


THIS MAP WAS PREPARED FOR ASSESSMENT PURPOSE ONLY.

SECTION 8 T.20S. R.10W. W.M. DOUGLAS COUNTY

20 10 8

1" = 400'

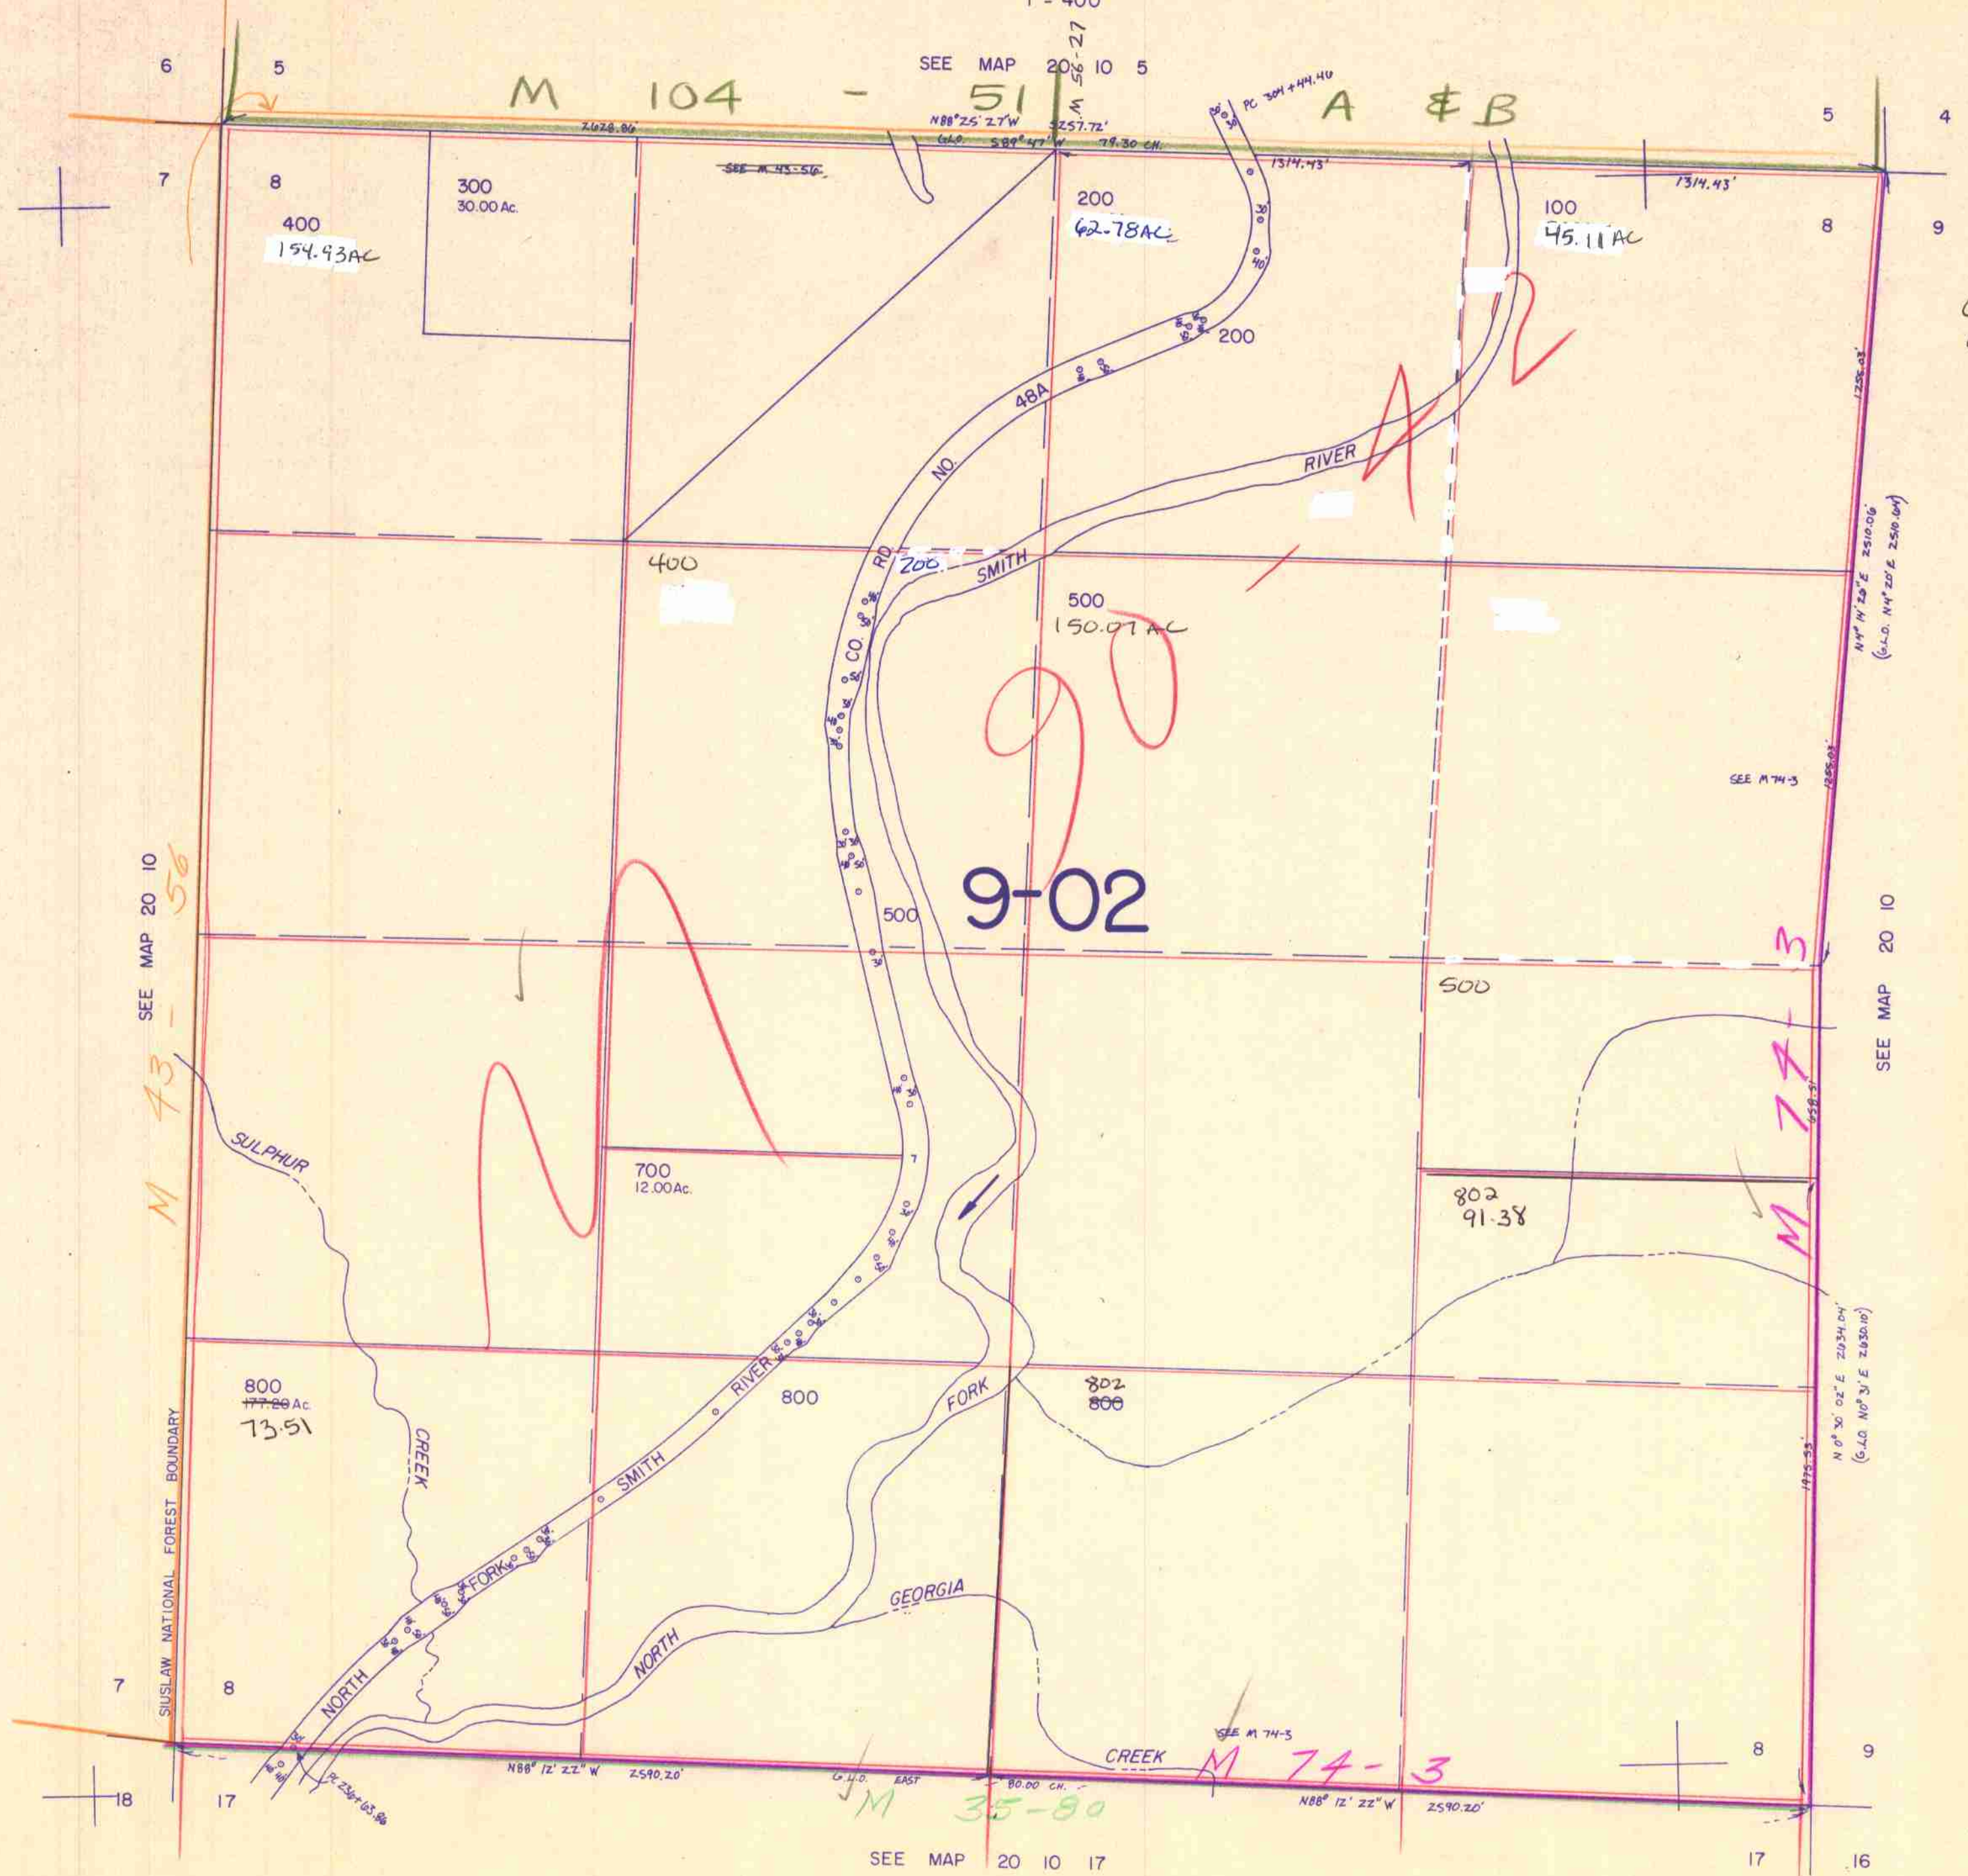

Cancelled No's 660

9-02

SEE MAP 20 10 43 - 56

SUSLAW NATIONAL FOREST BOUNDARY

SEE MAP 20 10 17

SEE MAP 20 10

1:101,000

20 10 8

3/87