


SECTION 20 T.20S. R.10W. W.M.
DOUGLAS COUNTY

20 10 20

THIS MAP WAS PREPARED FOR
ASSESSMENT PURPOSE ONLY.

1"=400'

1995-0089 A+B UNSURVEYED
1993-0072 A+B
SEE MAP 20 10 17
CS 55/166-1

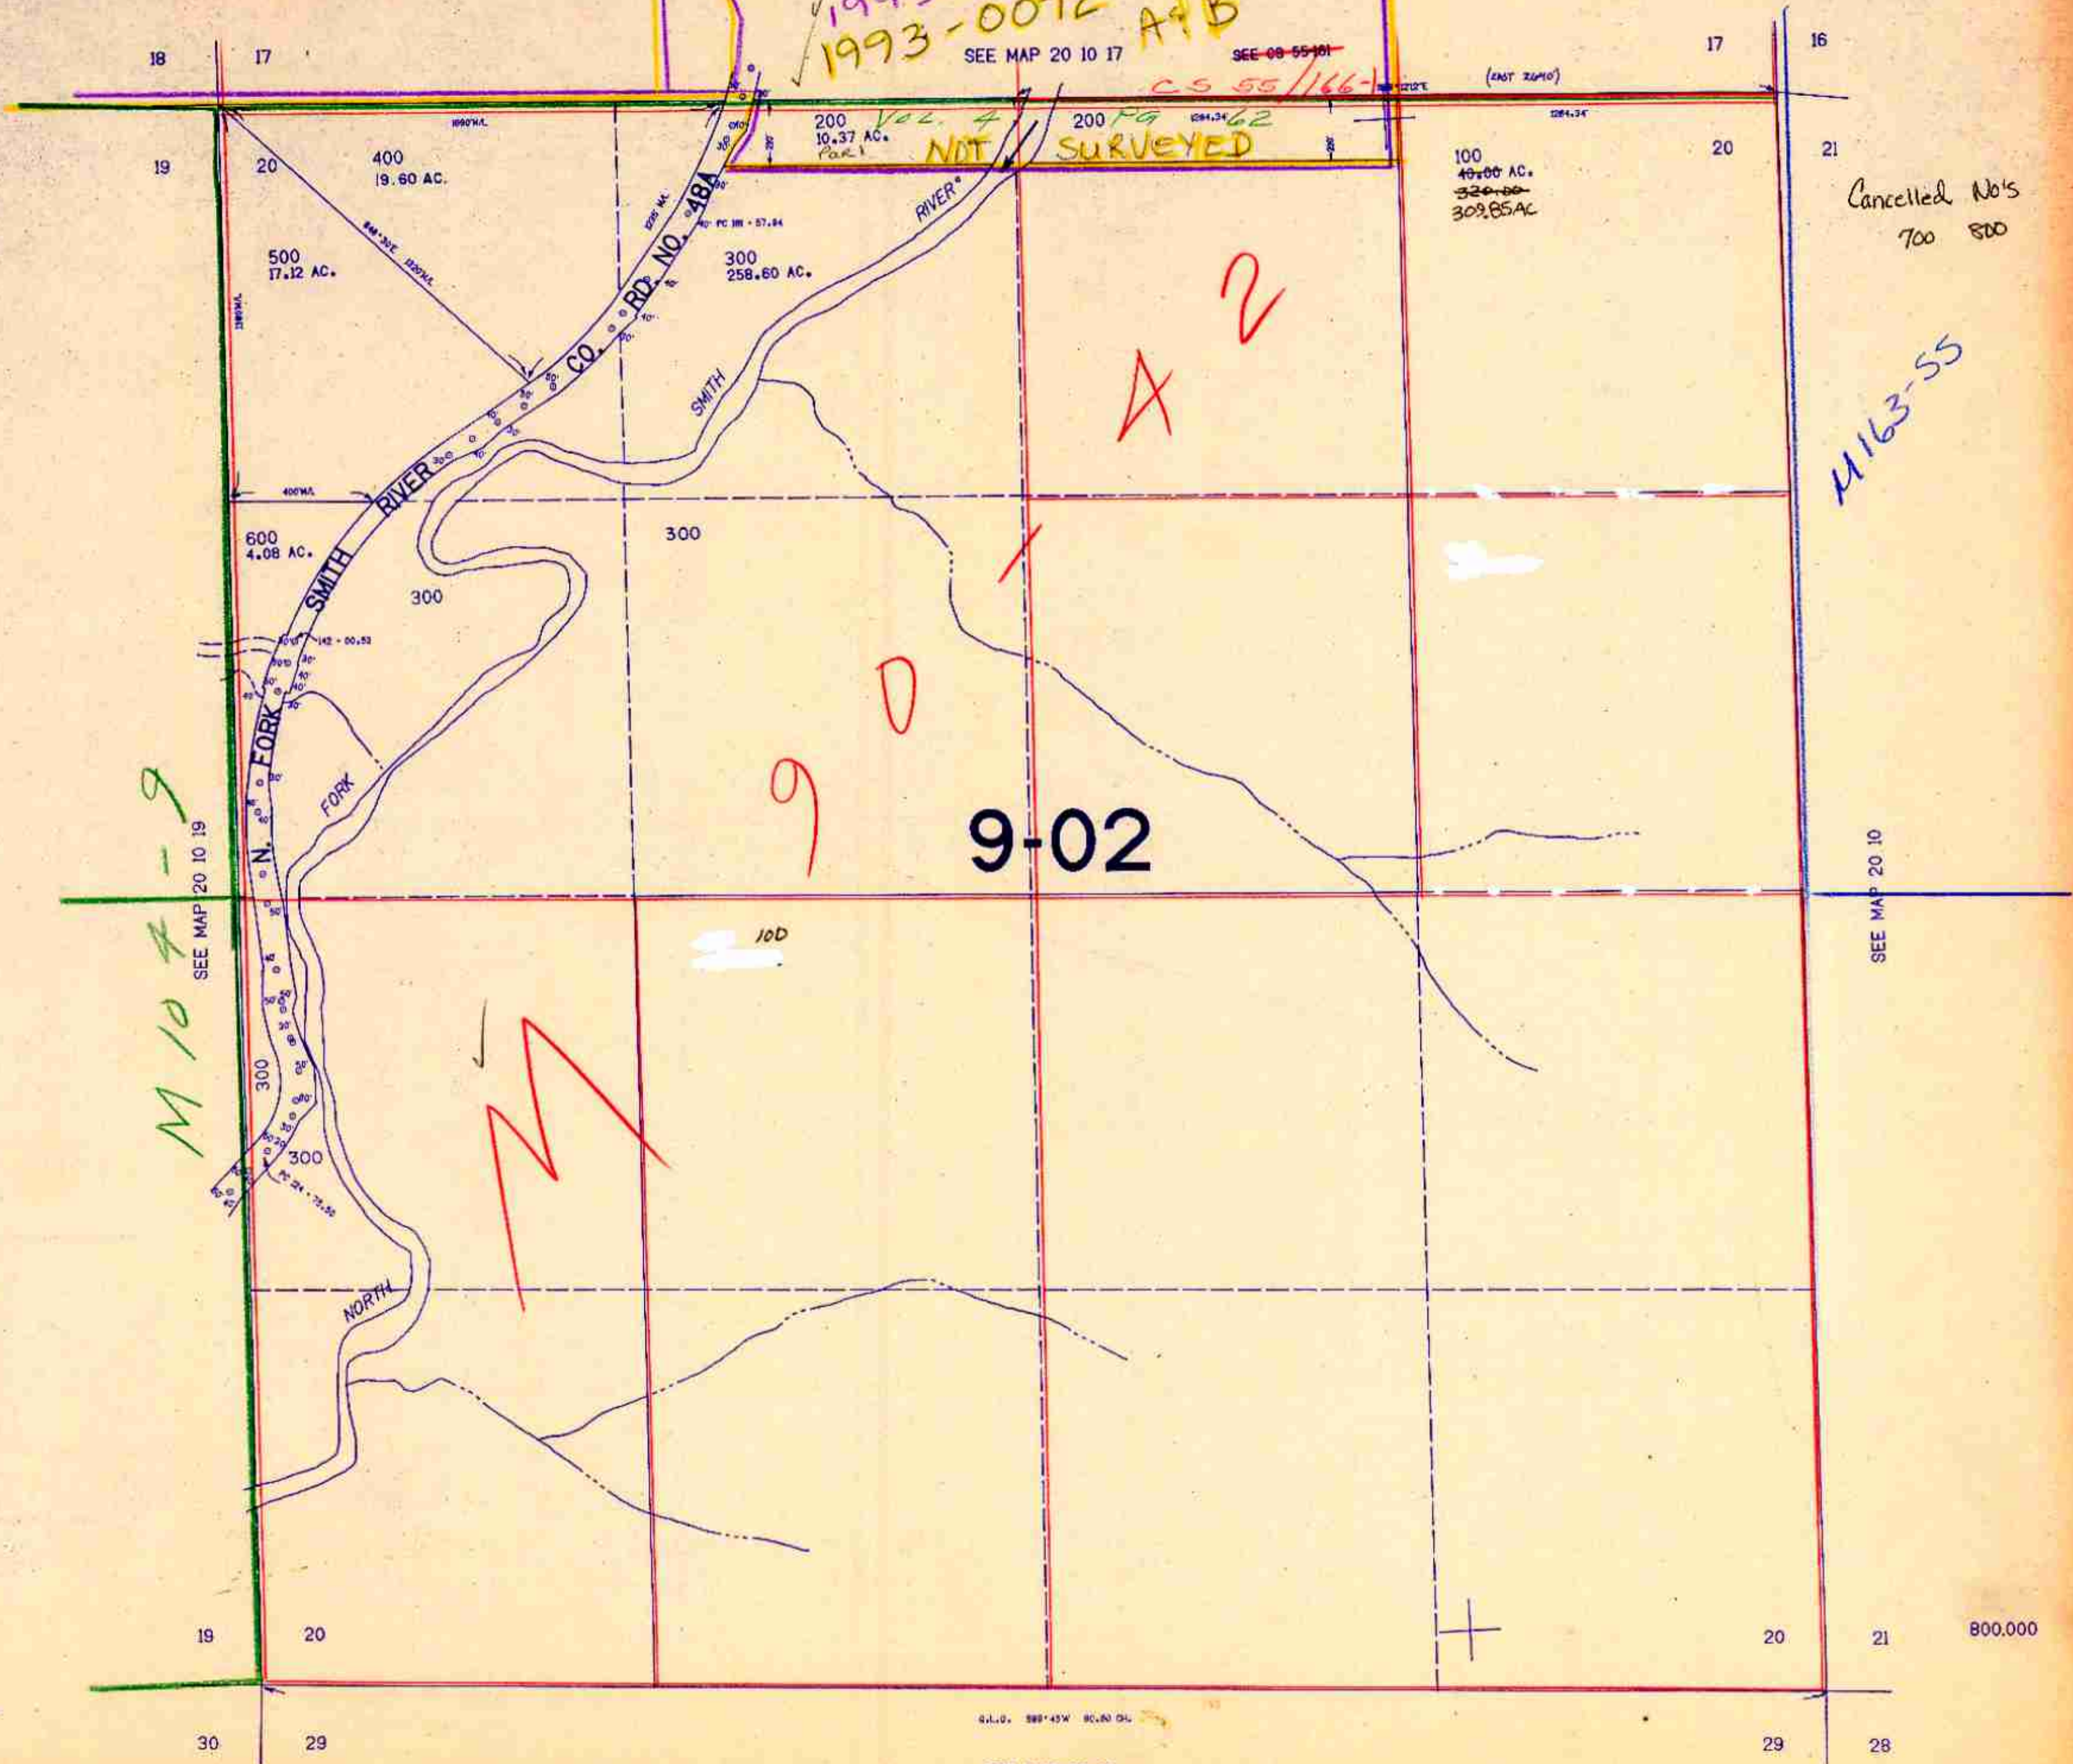

Cancelled No's
700 800

M 163-55

9-02

M 10 4 - 9

800,000

20 10 20

SEE MAP 20 10

1:100,000

3/1/20