


SECTION 18 T.22S. R.8W. W.M.  
DOUGLAS COUNTY



22 8 18  
& INDEX

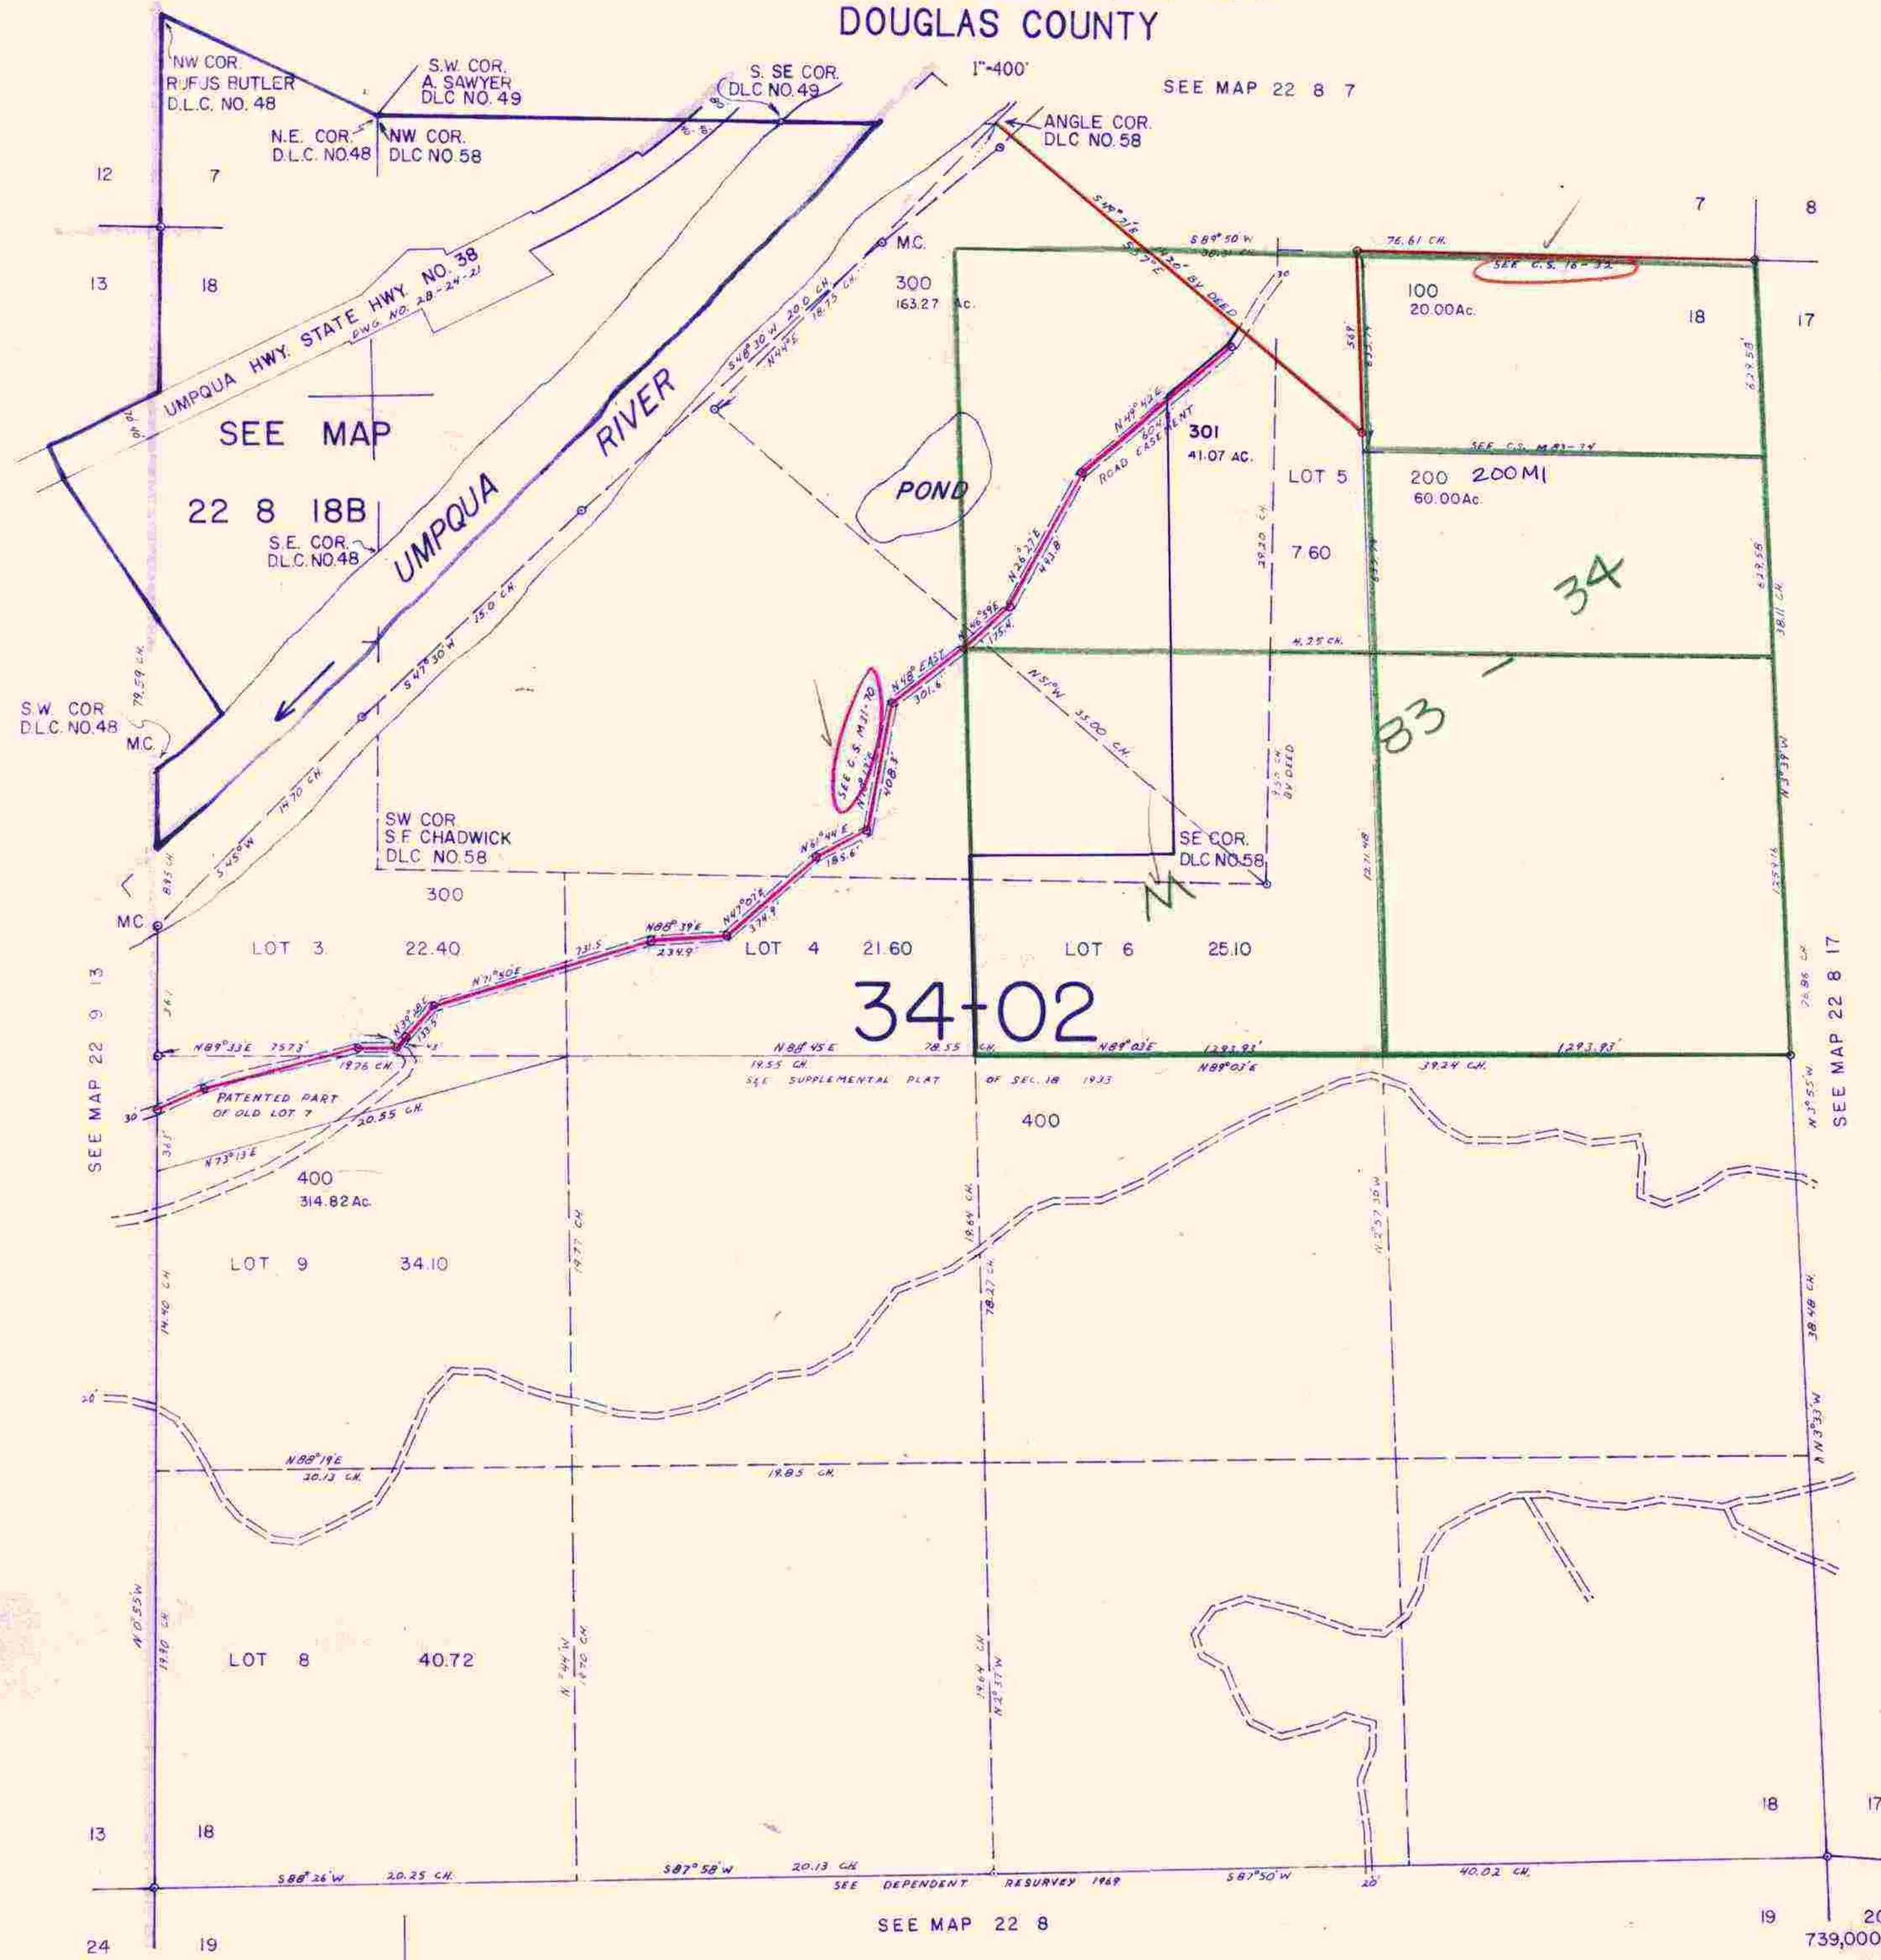

34-02

34

33

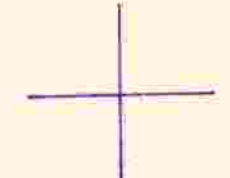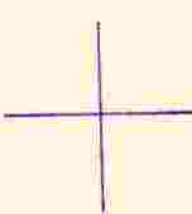

1,158,000  
739,000  
22 8 18  
& INDEX

5-88  
TF