


CEN SEC

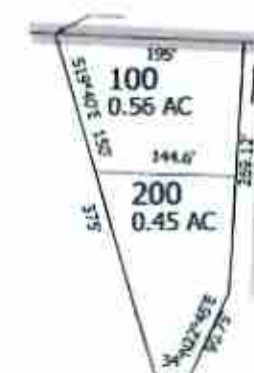

1/4 COR.

CANCELLED NO'S

SEE MAP 22 10 13

TAXLOT 300

1. N57°43'31"W 159.11'
2. S5°50'21"E 107.29'
3. S5°19'43"W 52.14'
4. S5°57'11"E 39.95'
5. N85°25'23"E 57.1'
6. N82°58'38"E 100.15'
7. N23°17'39"W 95.44'
8. N82°58'38"E 68.34'
9. N5°17'38"W 132.32'
10. S5°52'38"E 50.01'
11. N82°58'38"E 40.05'
12. N75°44'53"E 109.66'
13. S14°15'07"E 40.79'
14. S75°31'16"W 106.66'
15. S83°50'45"W 53.11'
16. N00°00'00"W 40.00'

SEE MAP 22 10 13

SEE MAP 22 10 13CD


SEE MAP 22 9 18

741,000

13 18 24 19

4,041,000

22 10 13D

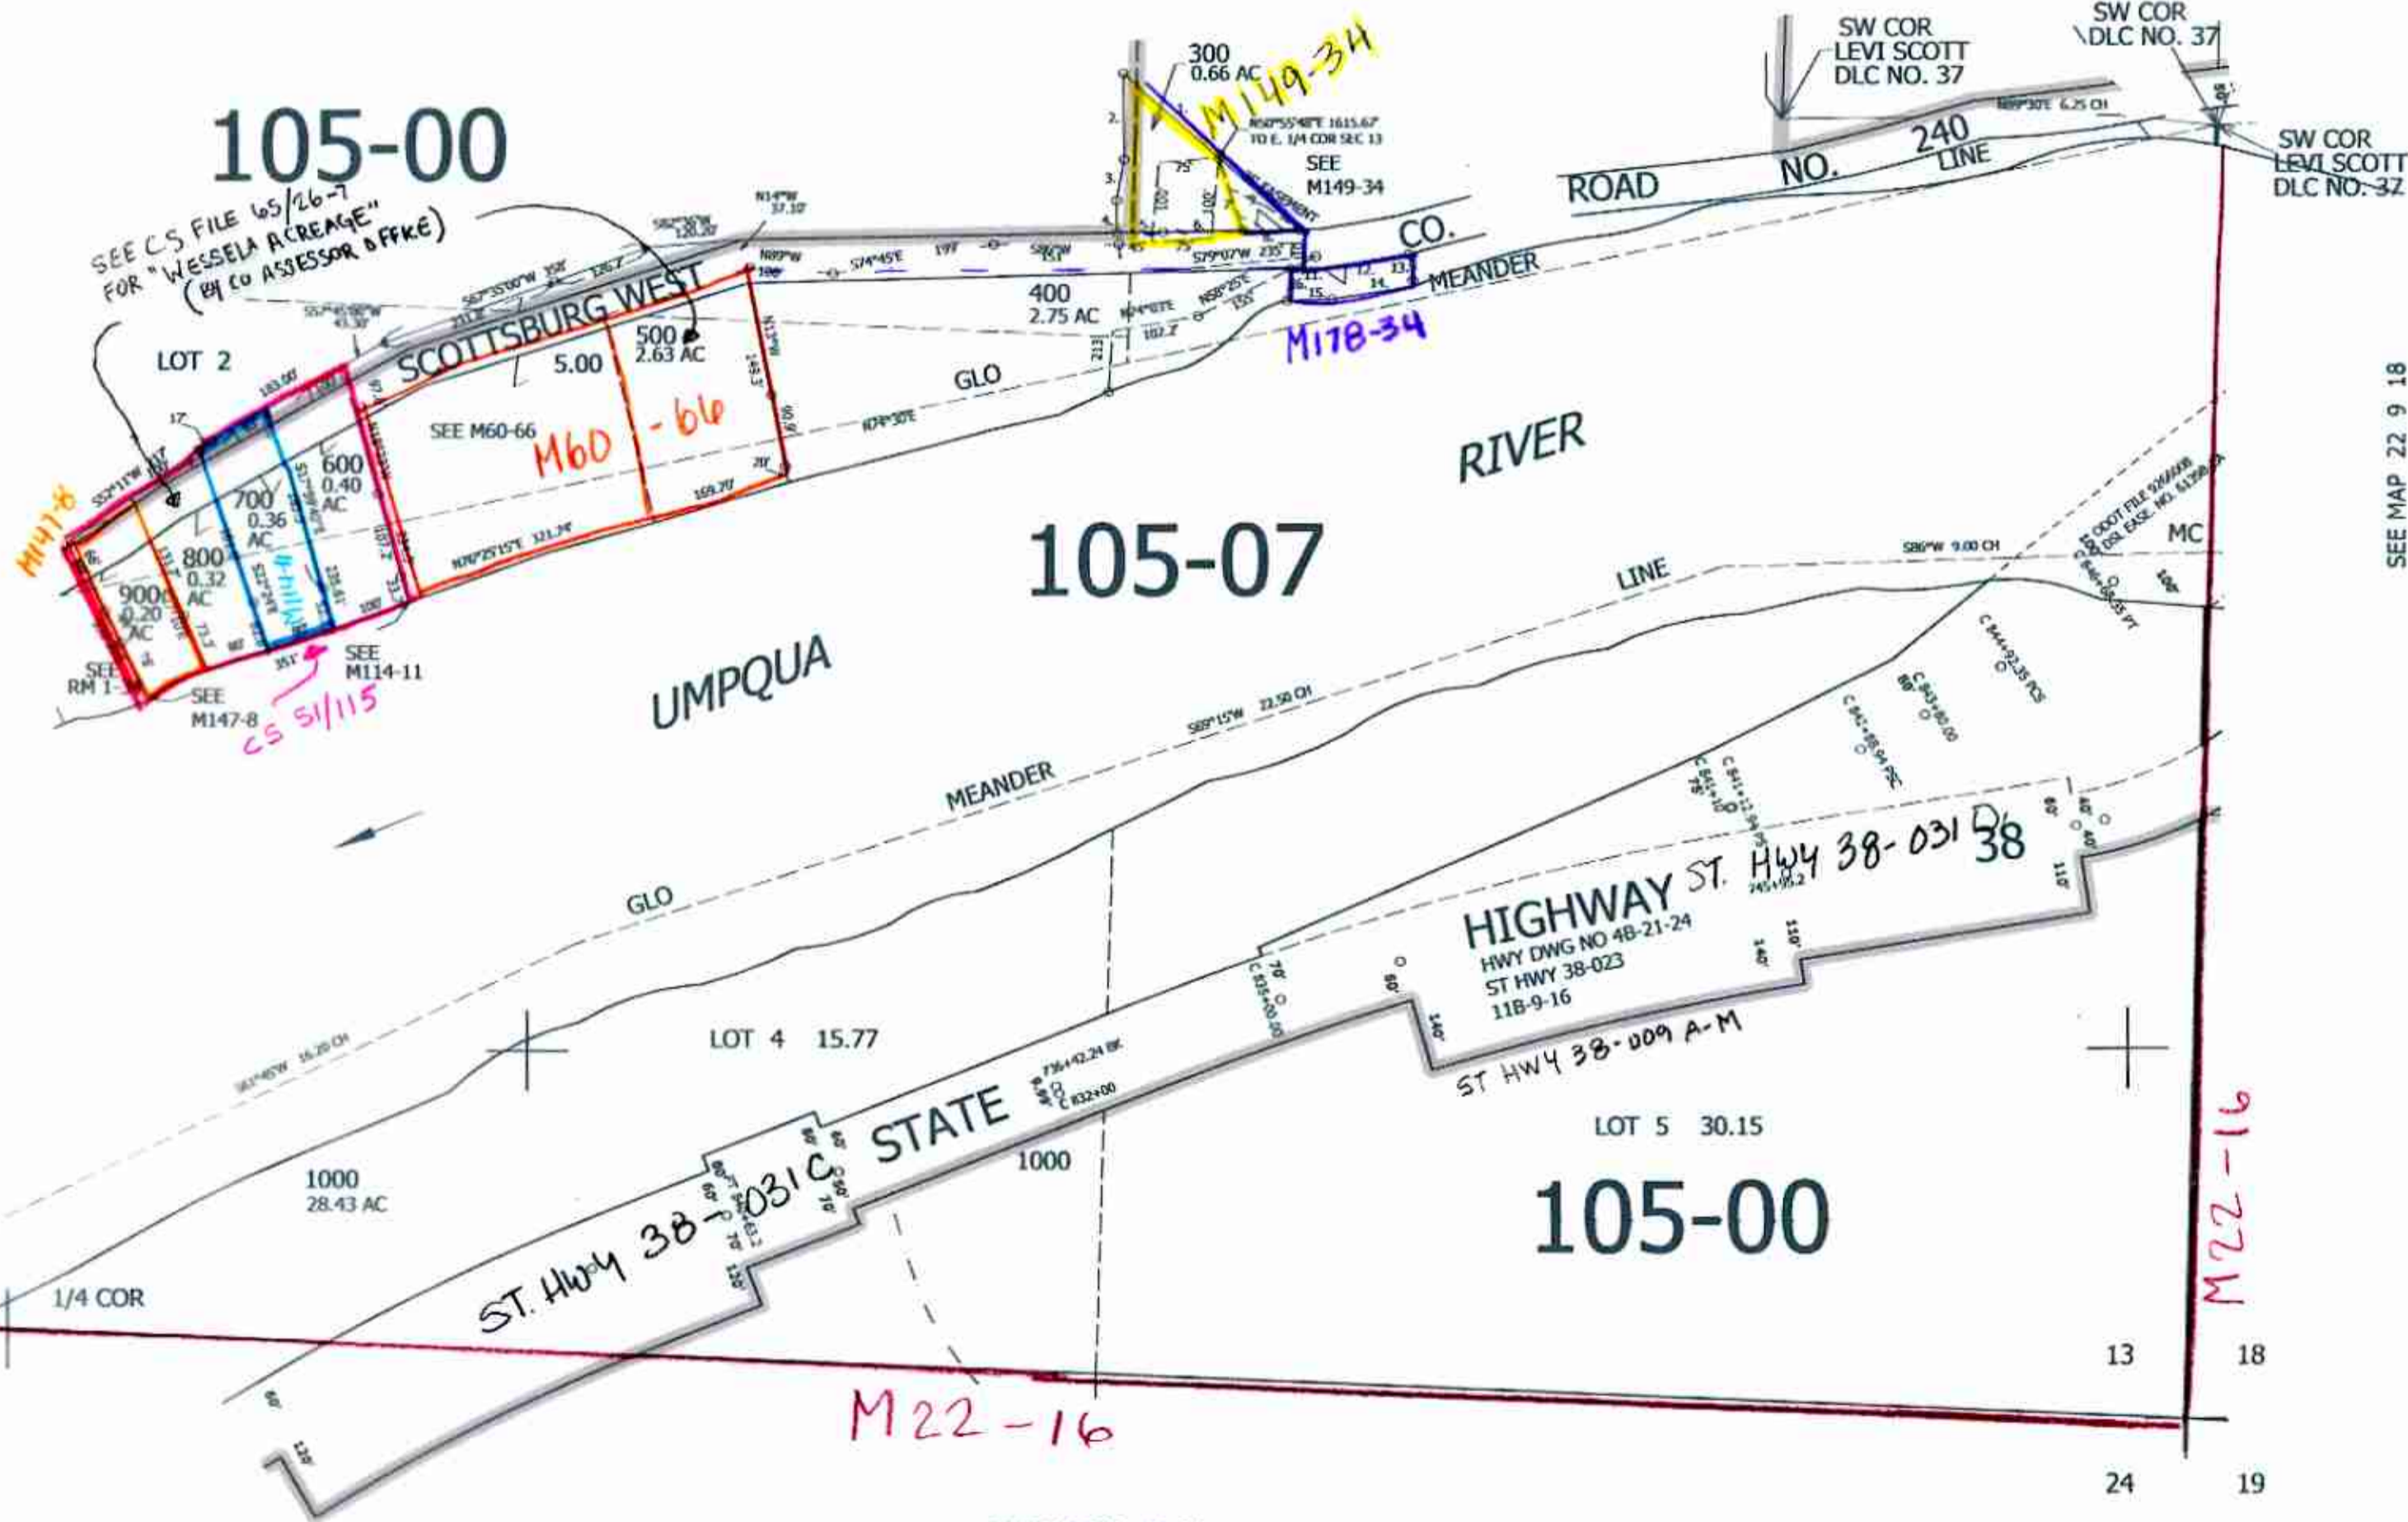

7/20/21