


THIS MAP WAS PREPARED FOR ASSESSMENT PURPOSE ONLY.

SECTION 15 T.22S. R.10W. W.M.
DOUGLAS COUNTY

1" = 400"

22 10 15

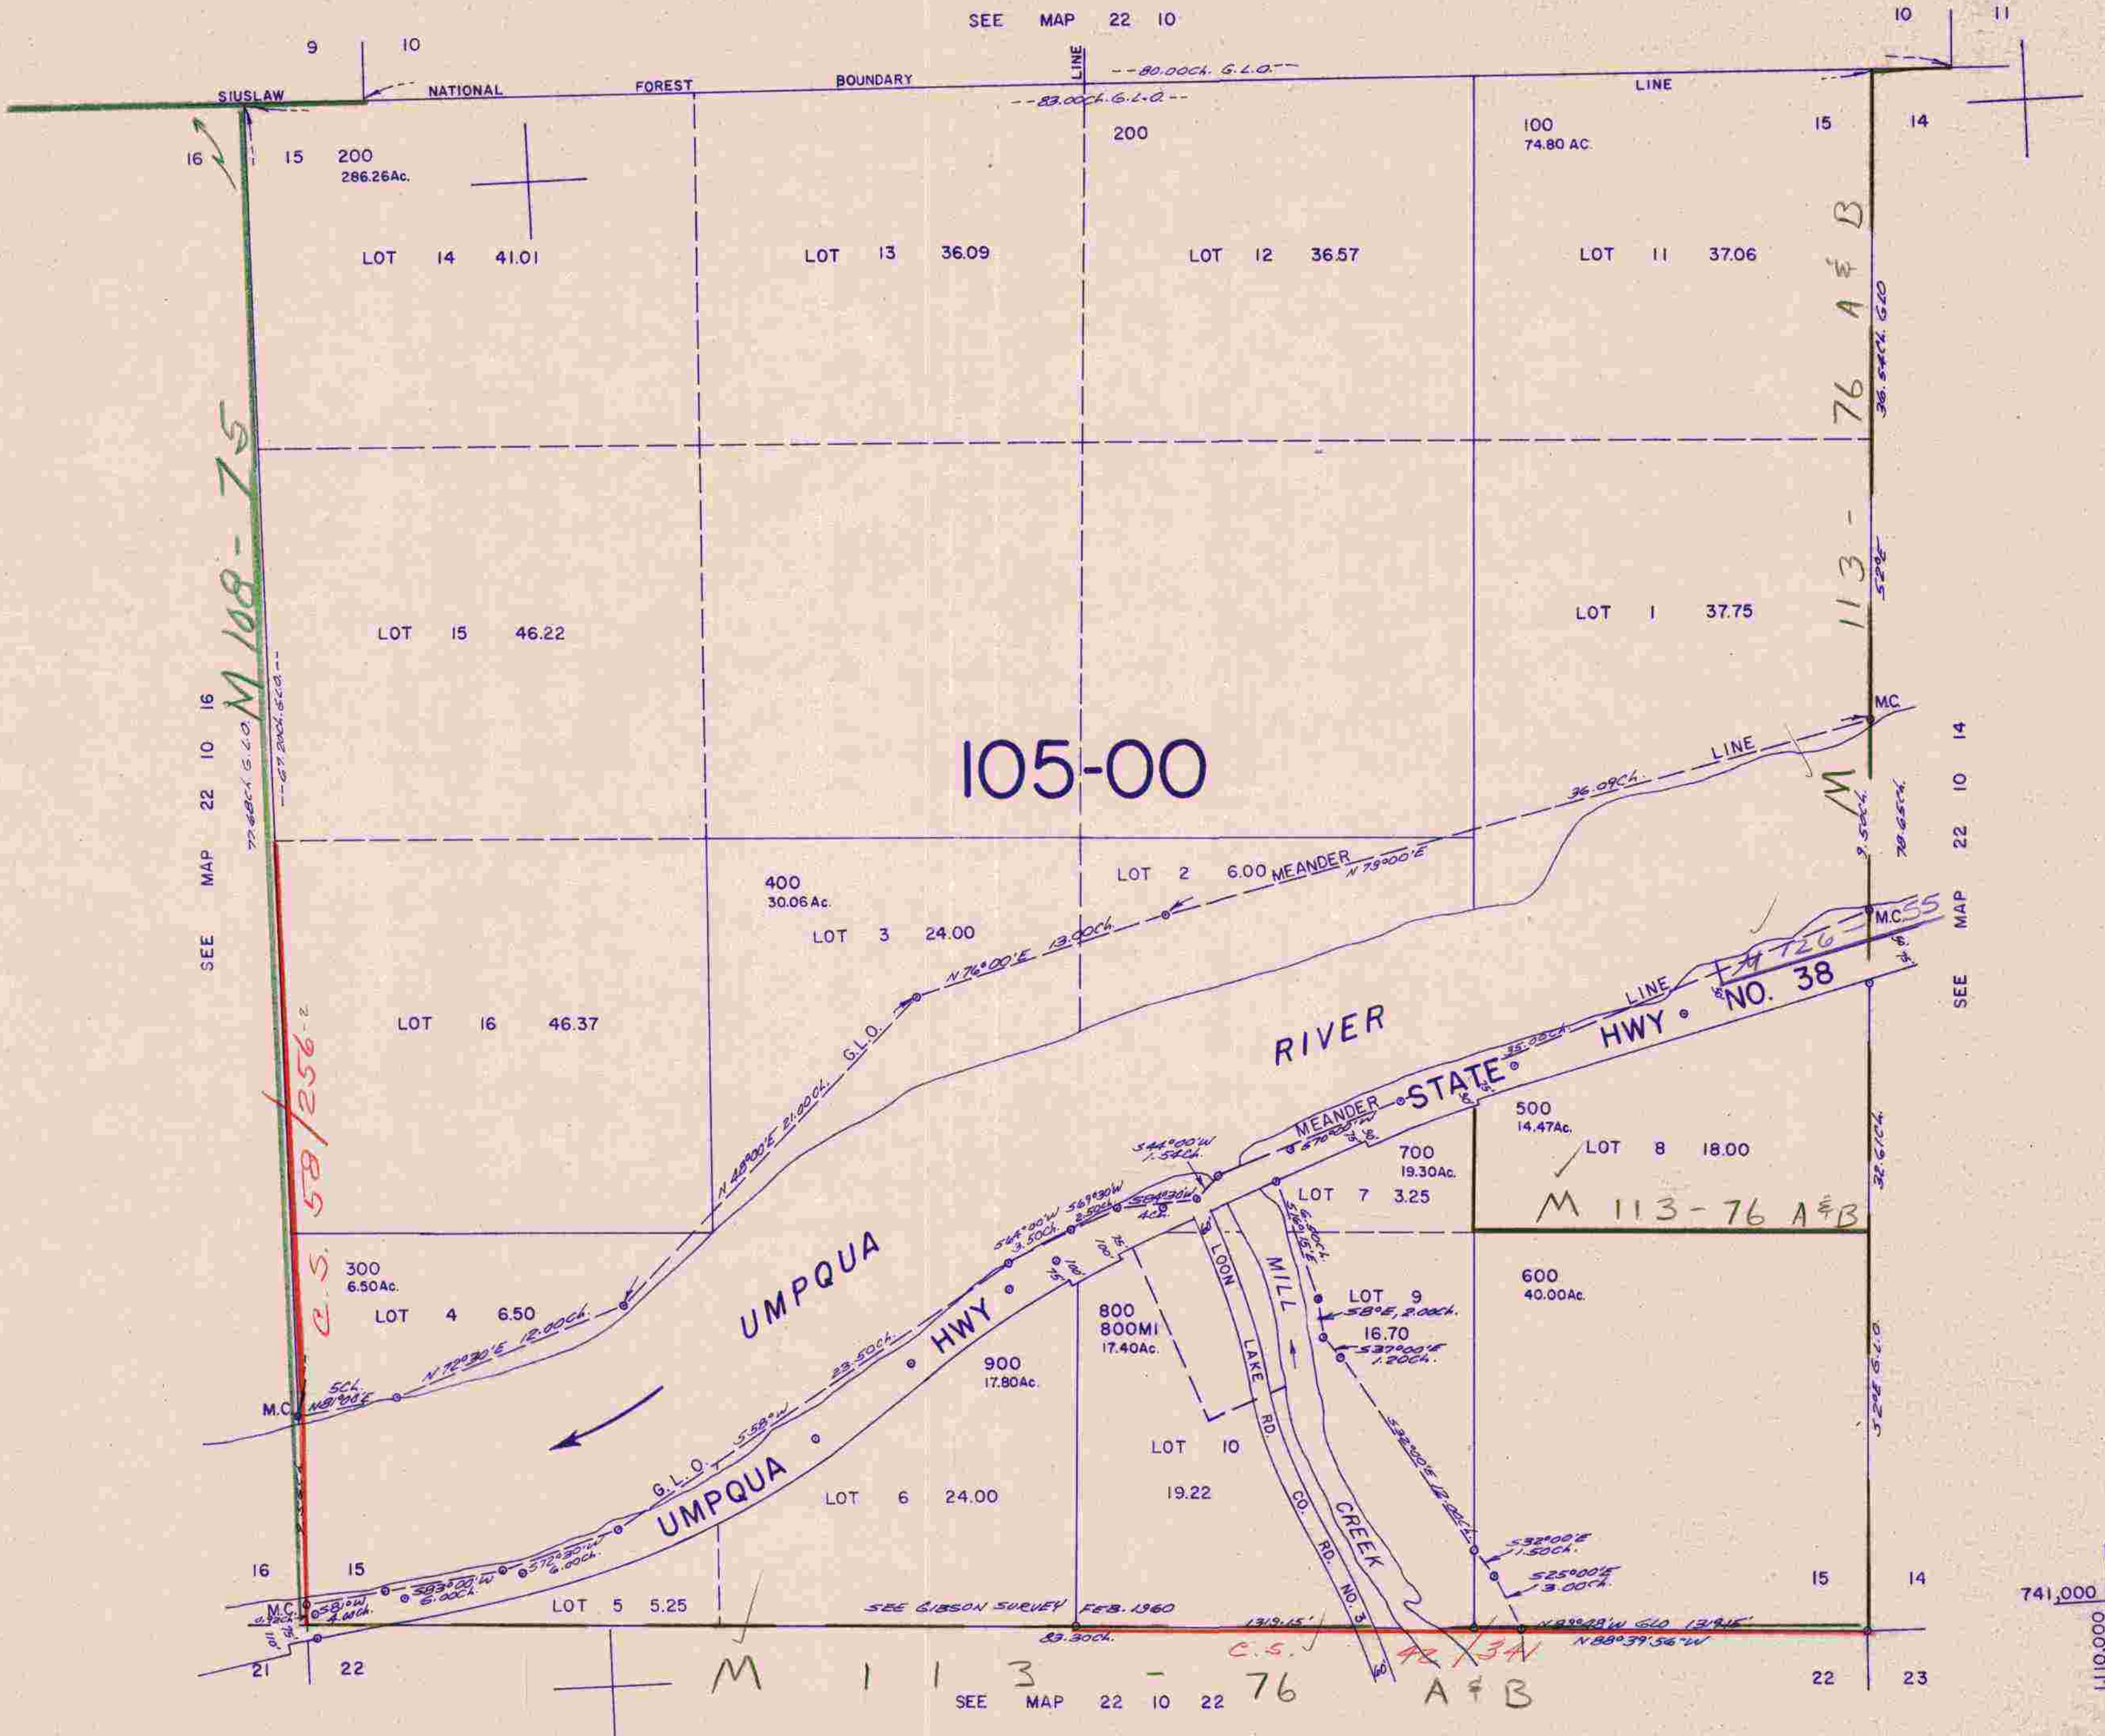

22 10 15

3/6/38