


THIS MAP WAS PREPARED FOR ASSESSMENT PURPOSE ONLY.

SECTION 12 T.24S. R.7W. W.M. DOUGLAS COUNTY

24 7 12 & INDEX

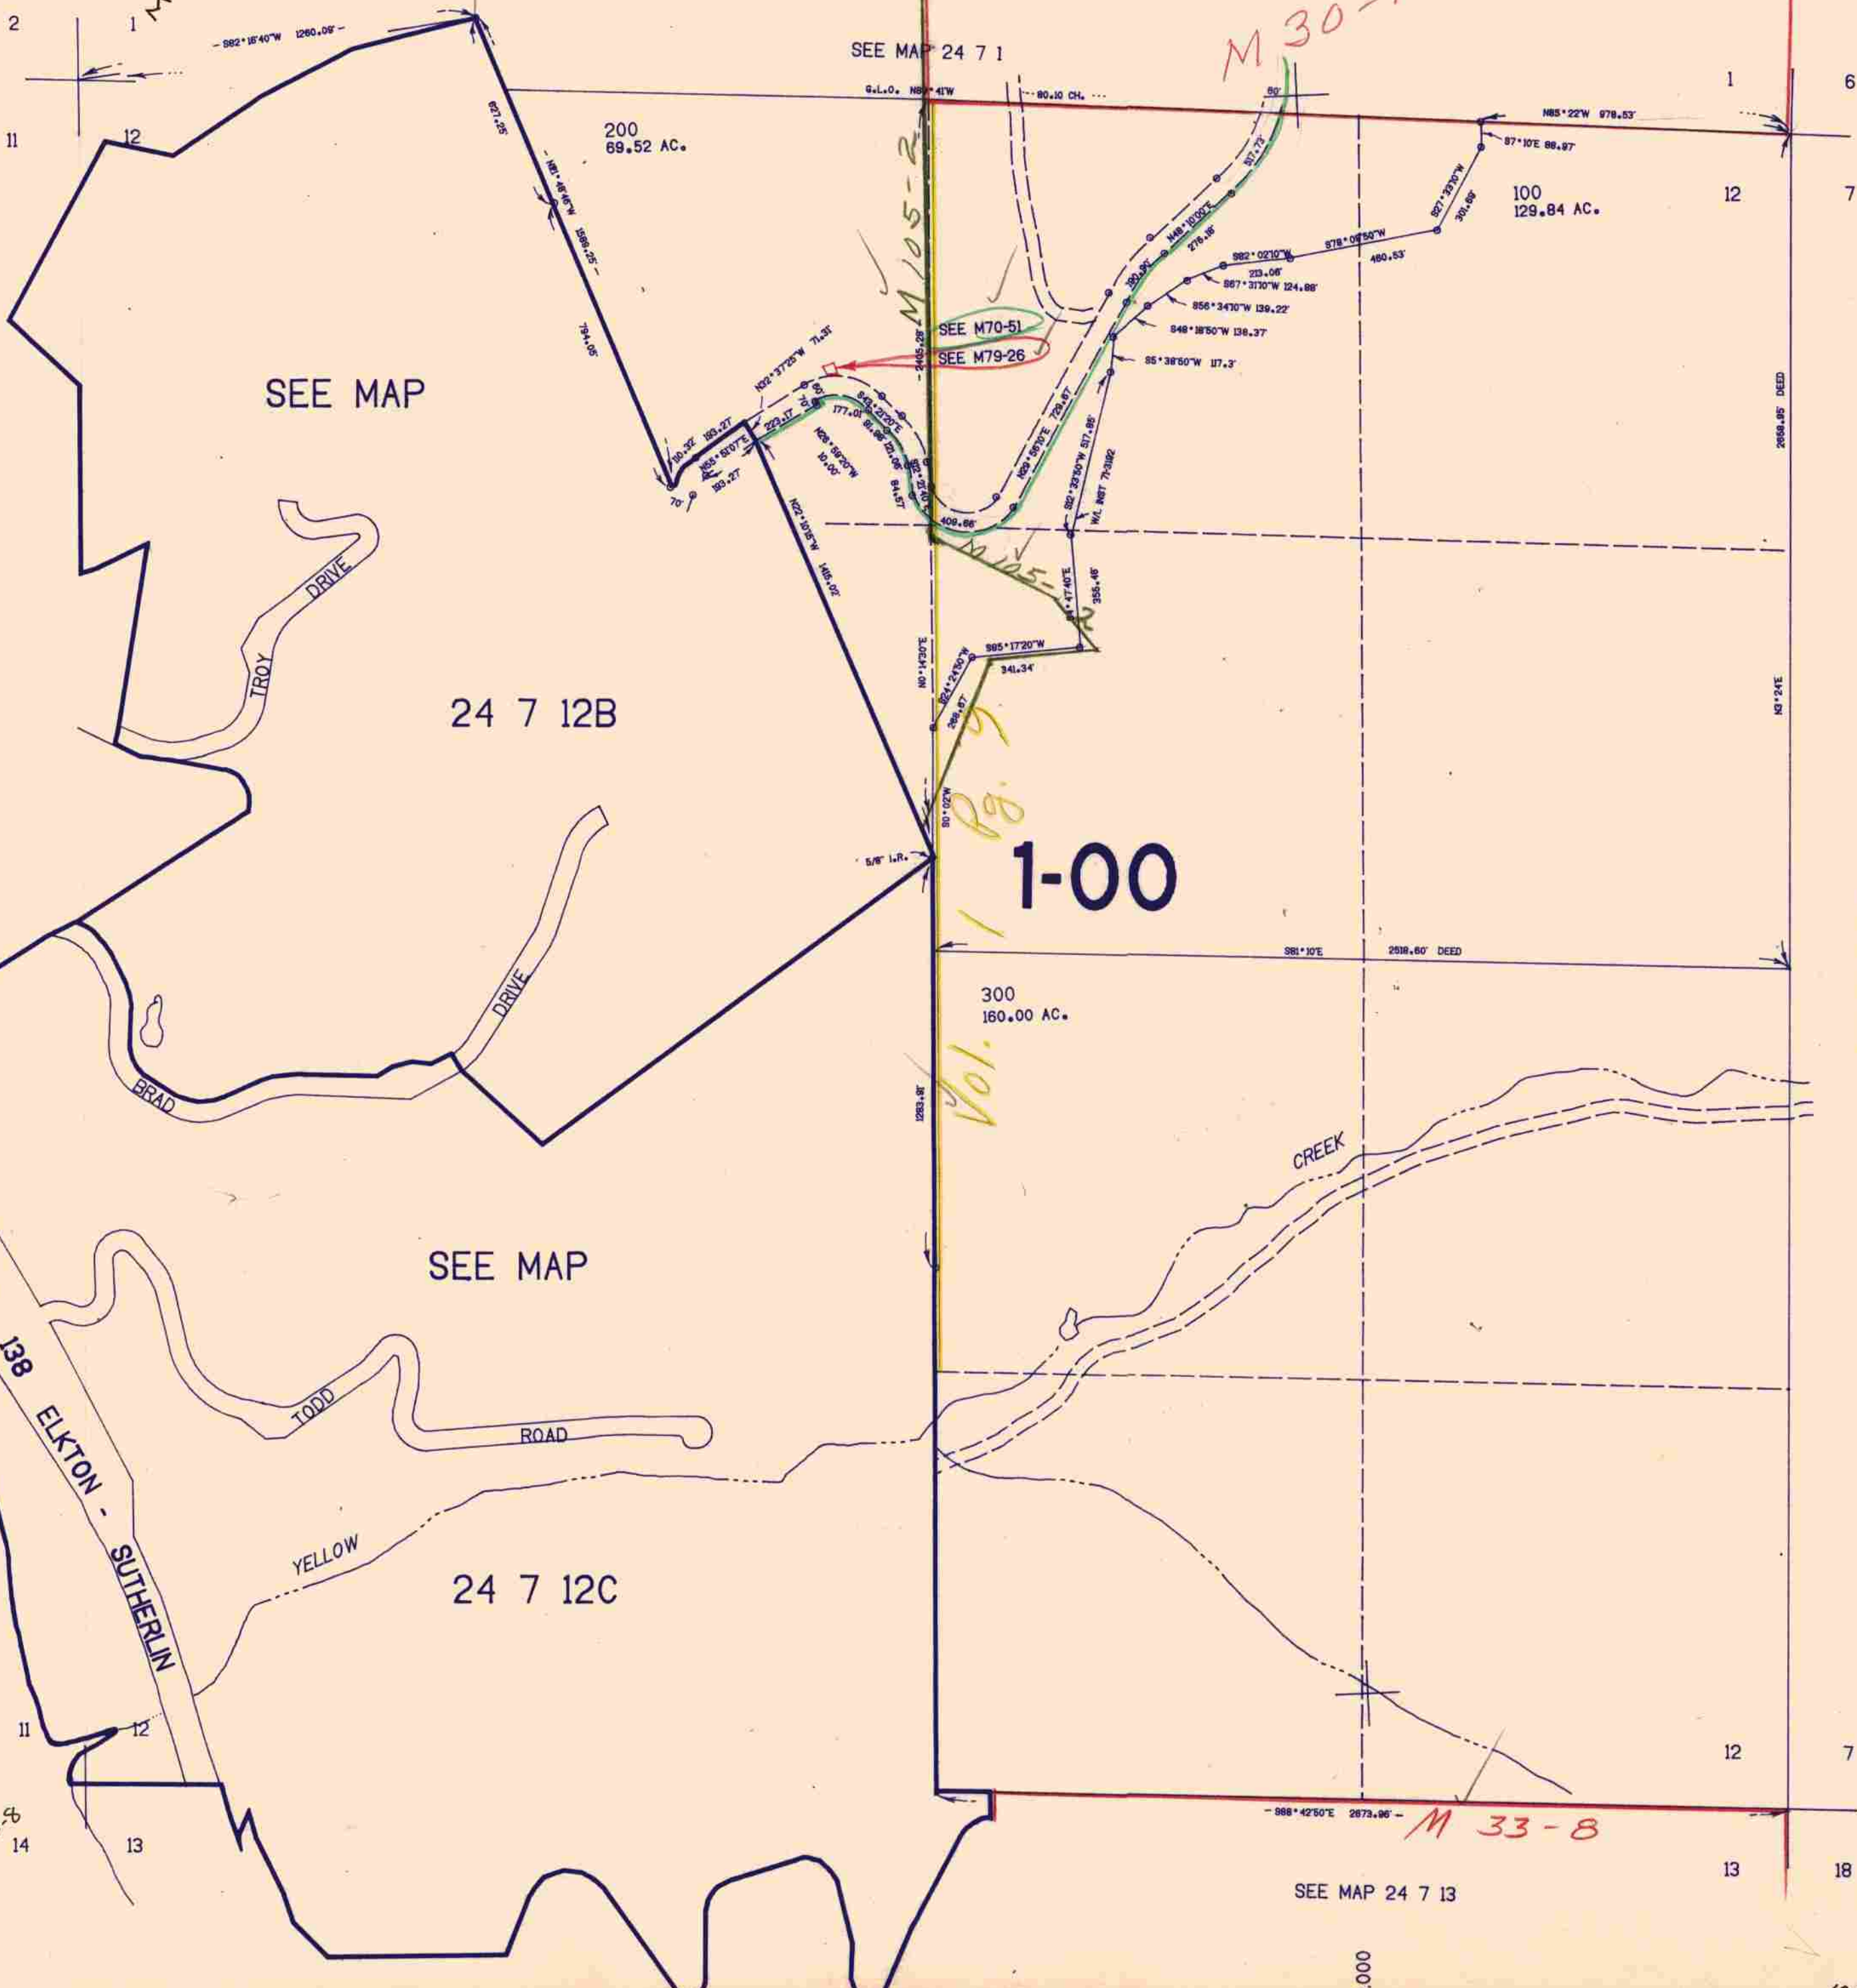

SEE MAP 24 7 11A

SEE MAP 24 7 1

SEE M70-51
SEE M79-26

1-00

Vol. 1 pg. 6

SEE MAP 24 6 7

SEE MAP

24 7 12C

SEE MAP 24 7 13

679.000

24 7 12 & INDEX

10/83 BS

SEE MAP 24 7 13B

1.212.000