


1"=2000'

THIS MAP WAS PREPARED FOR
ASSESSMENT PURPOSE ONLY.

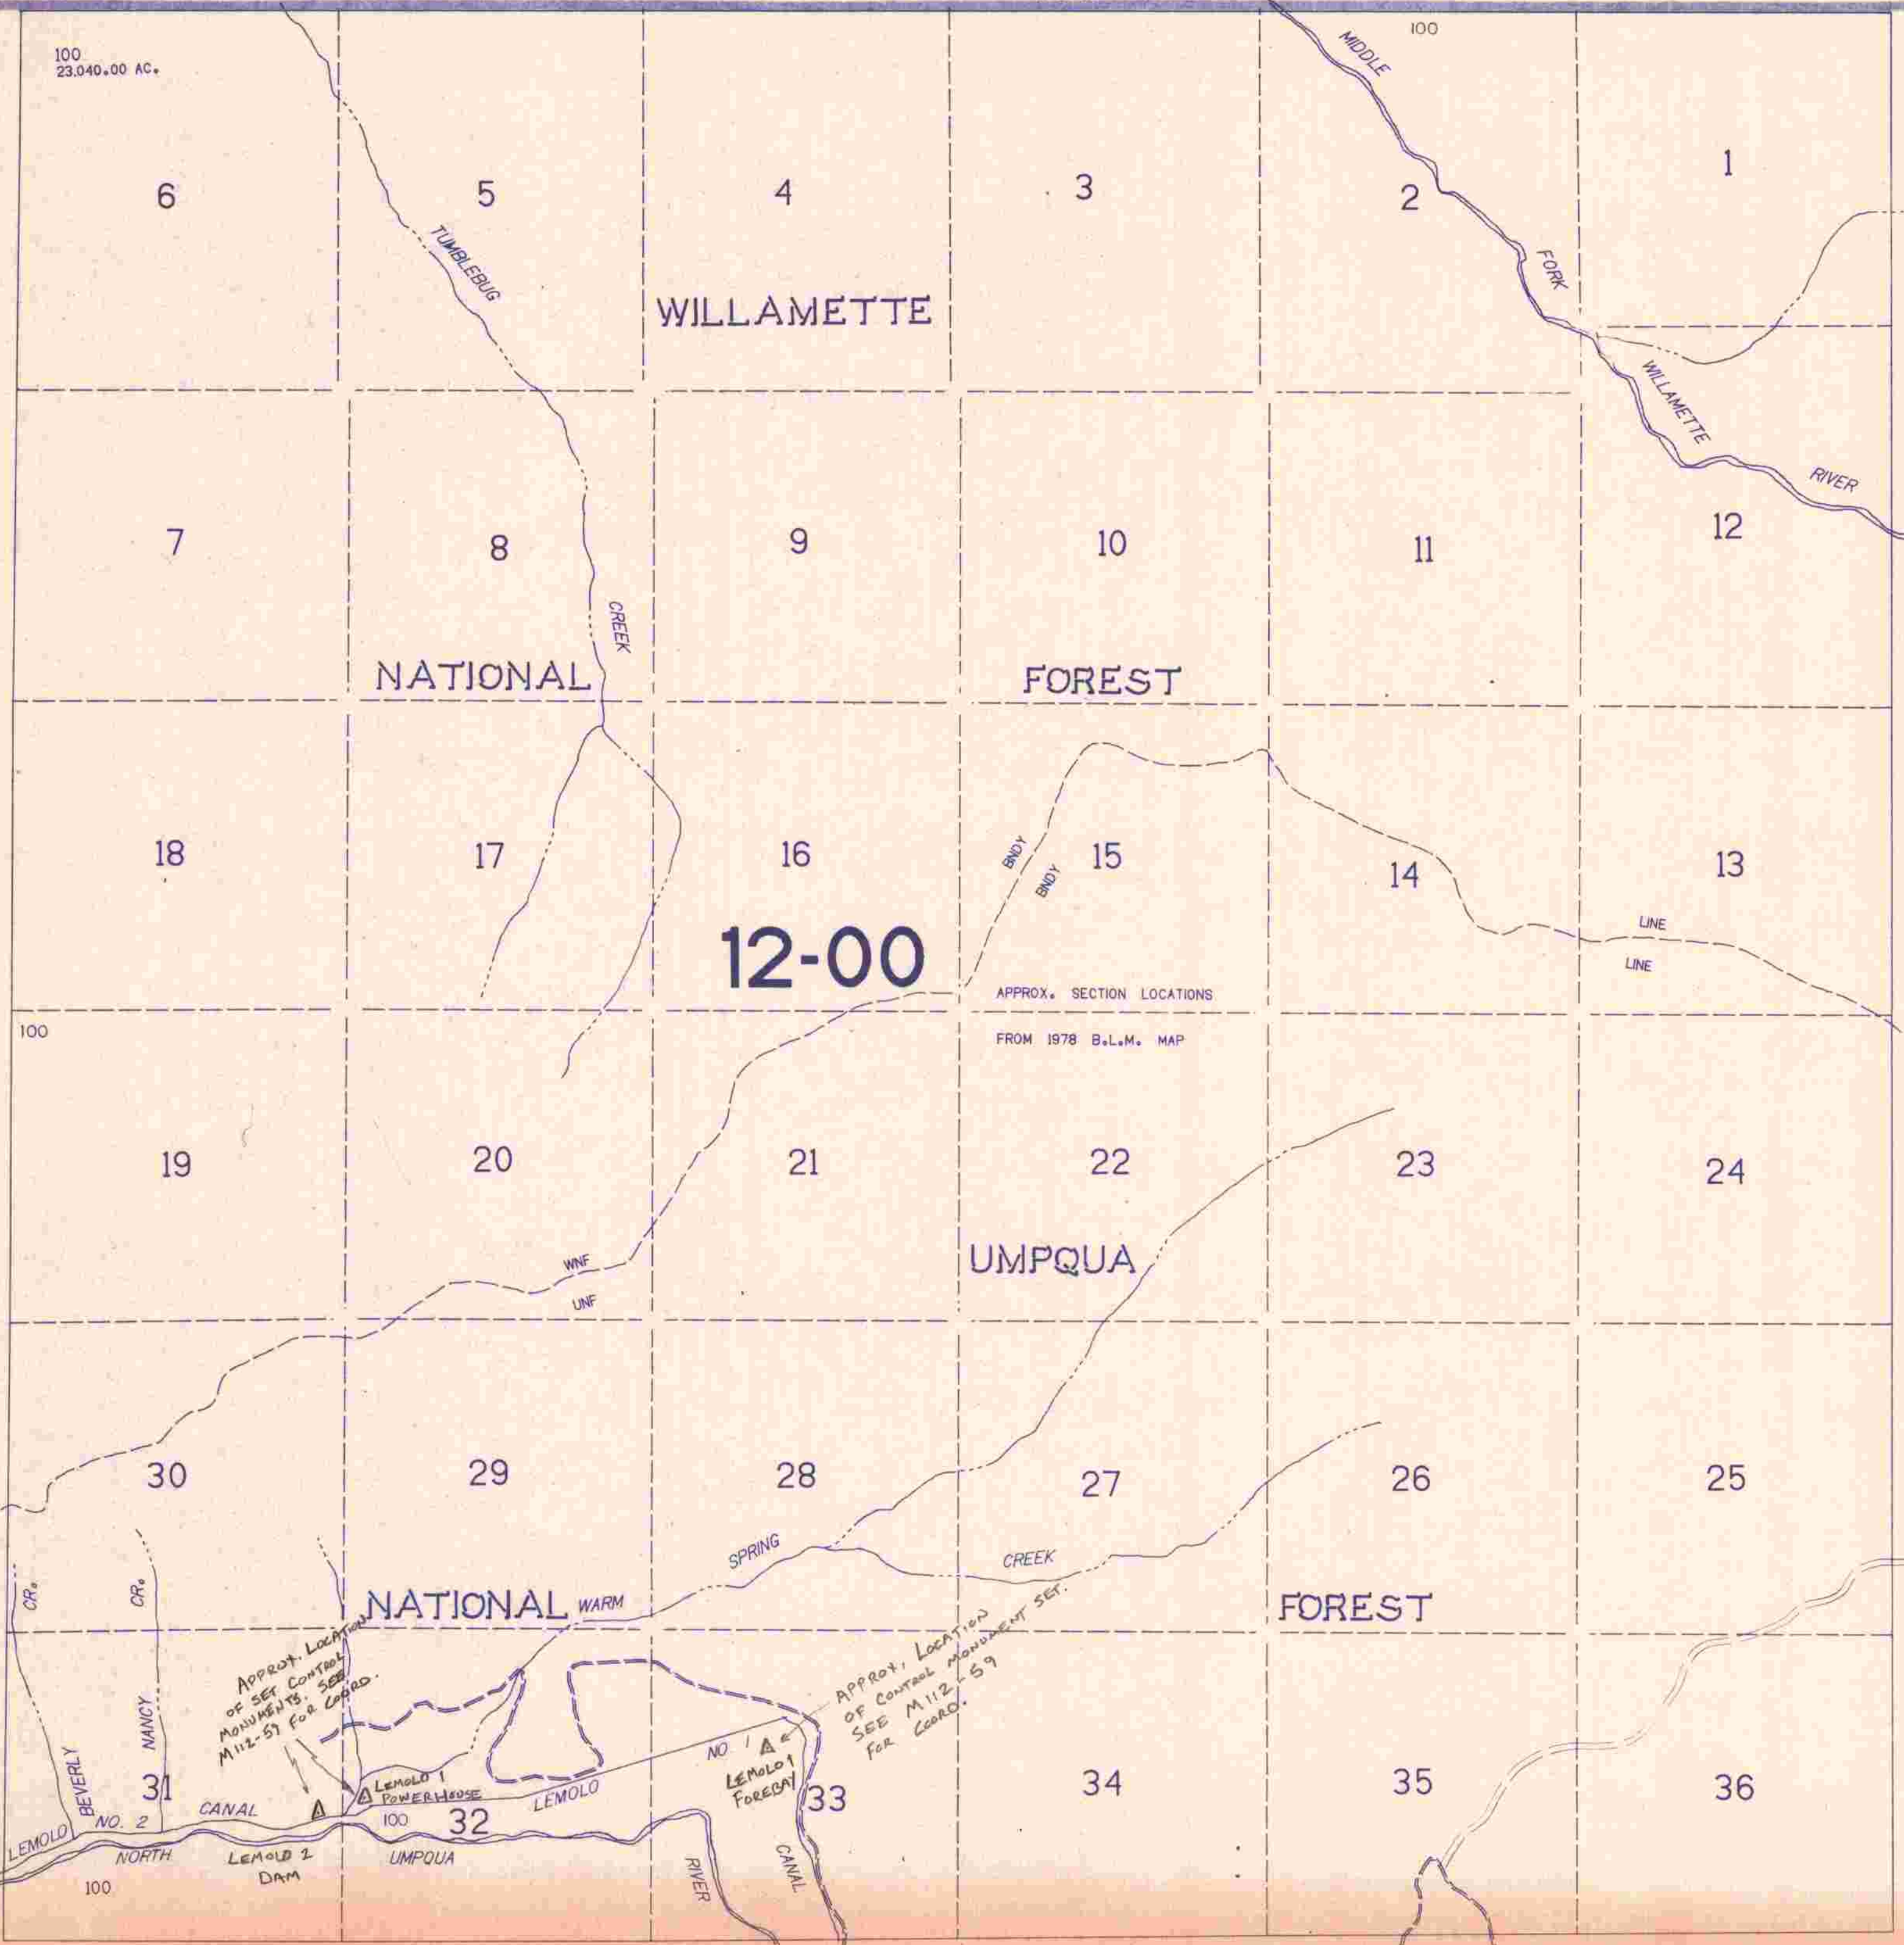

100
23,040.00 AC.

100

100

100

SEE MAP 25 4E

SEE MAP 25 5I/2E

12-00

APPROX. SECTION LOCATIONS
FROM 1978 B.L.M. MAP

APPROX. LOCATION
OF SET CONTROL
MONUMENTS. SEE
M112-59 FOR COORD.

APPROX. LOCATION
OF CONTROL MONUMENT SET.
SEE M112-59
FOR COORD.

SEE MAP 26 5E