


SE1/4 SE1/4 SEC.5 T.25S. R.5W. W.M.
DOUGLAS COUNTY

1"=100'

THIS MAP WAS PREPARED FOR
ASSESSMENT PURPOSE ONLY.

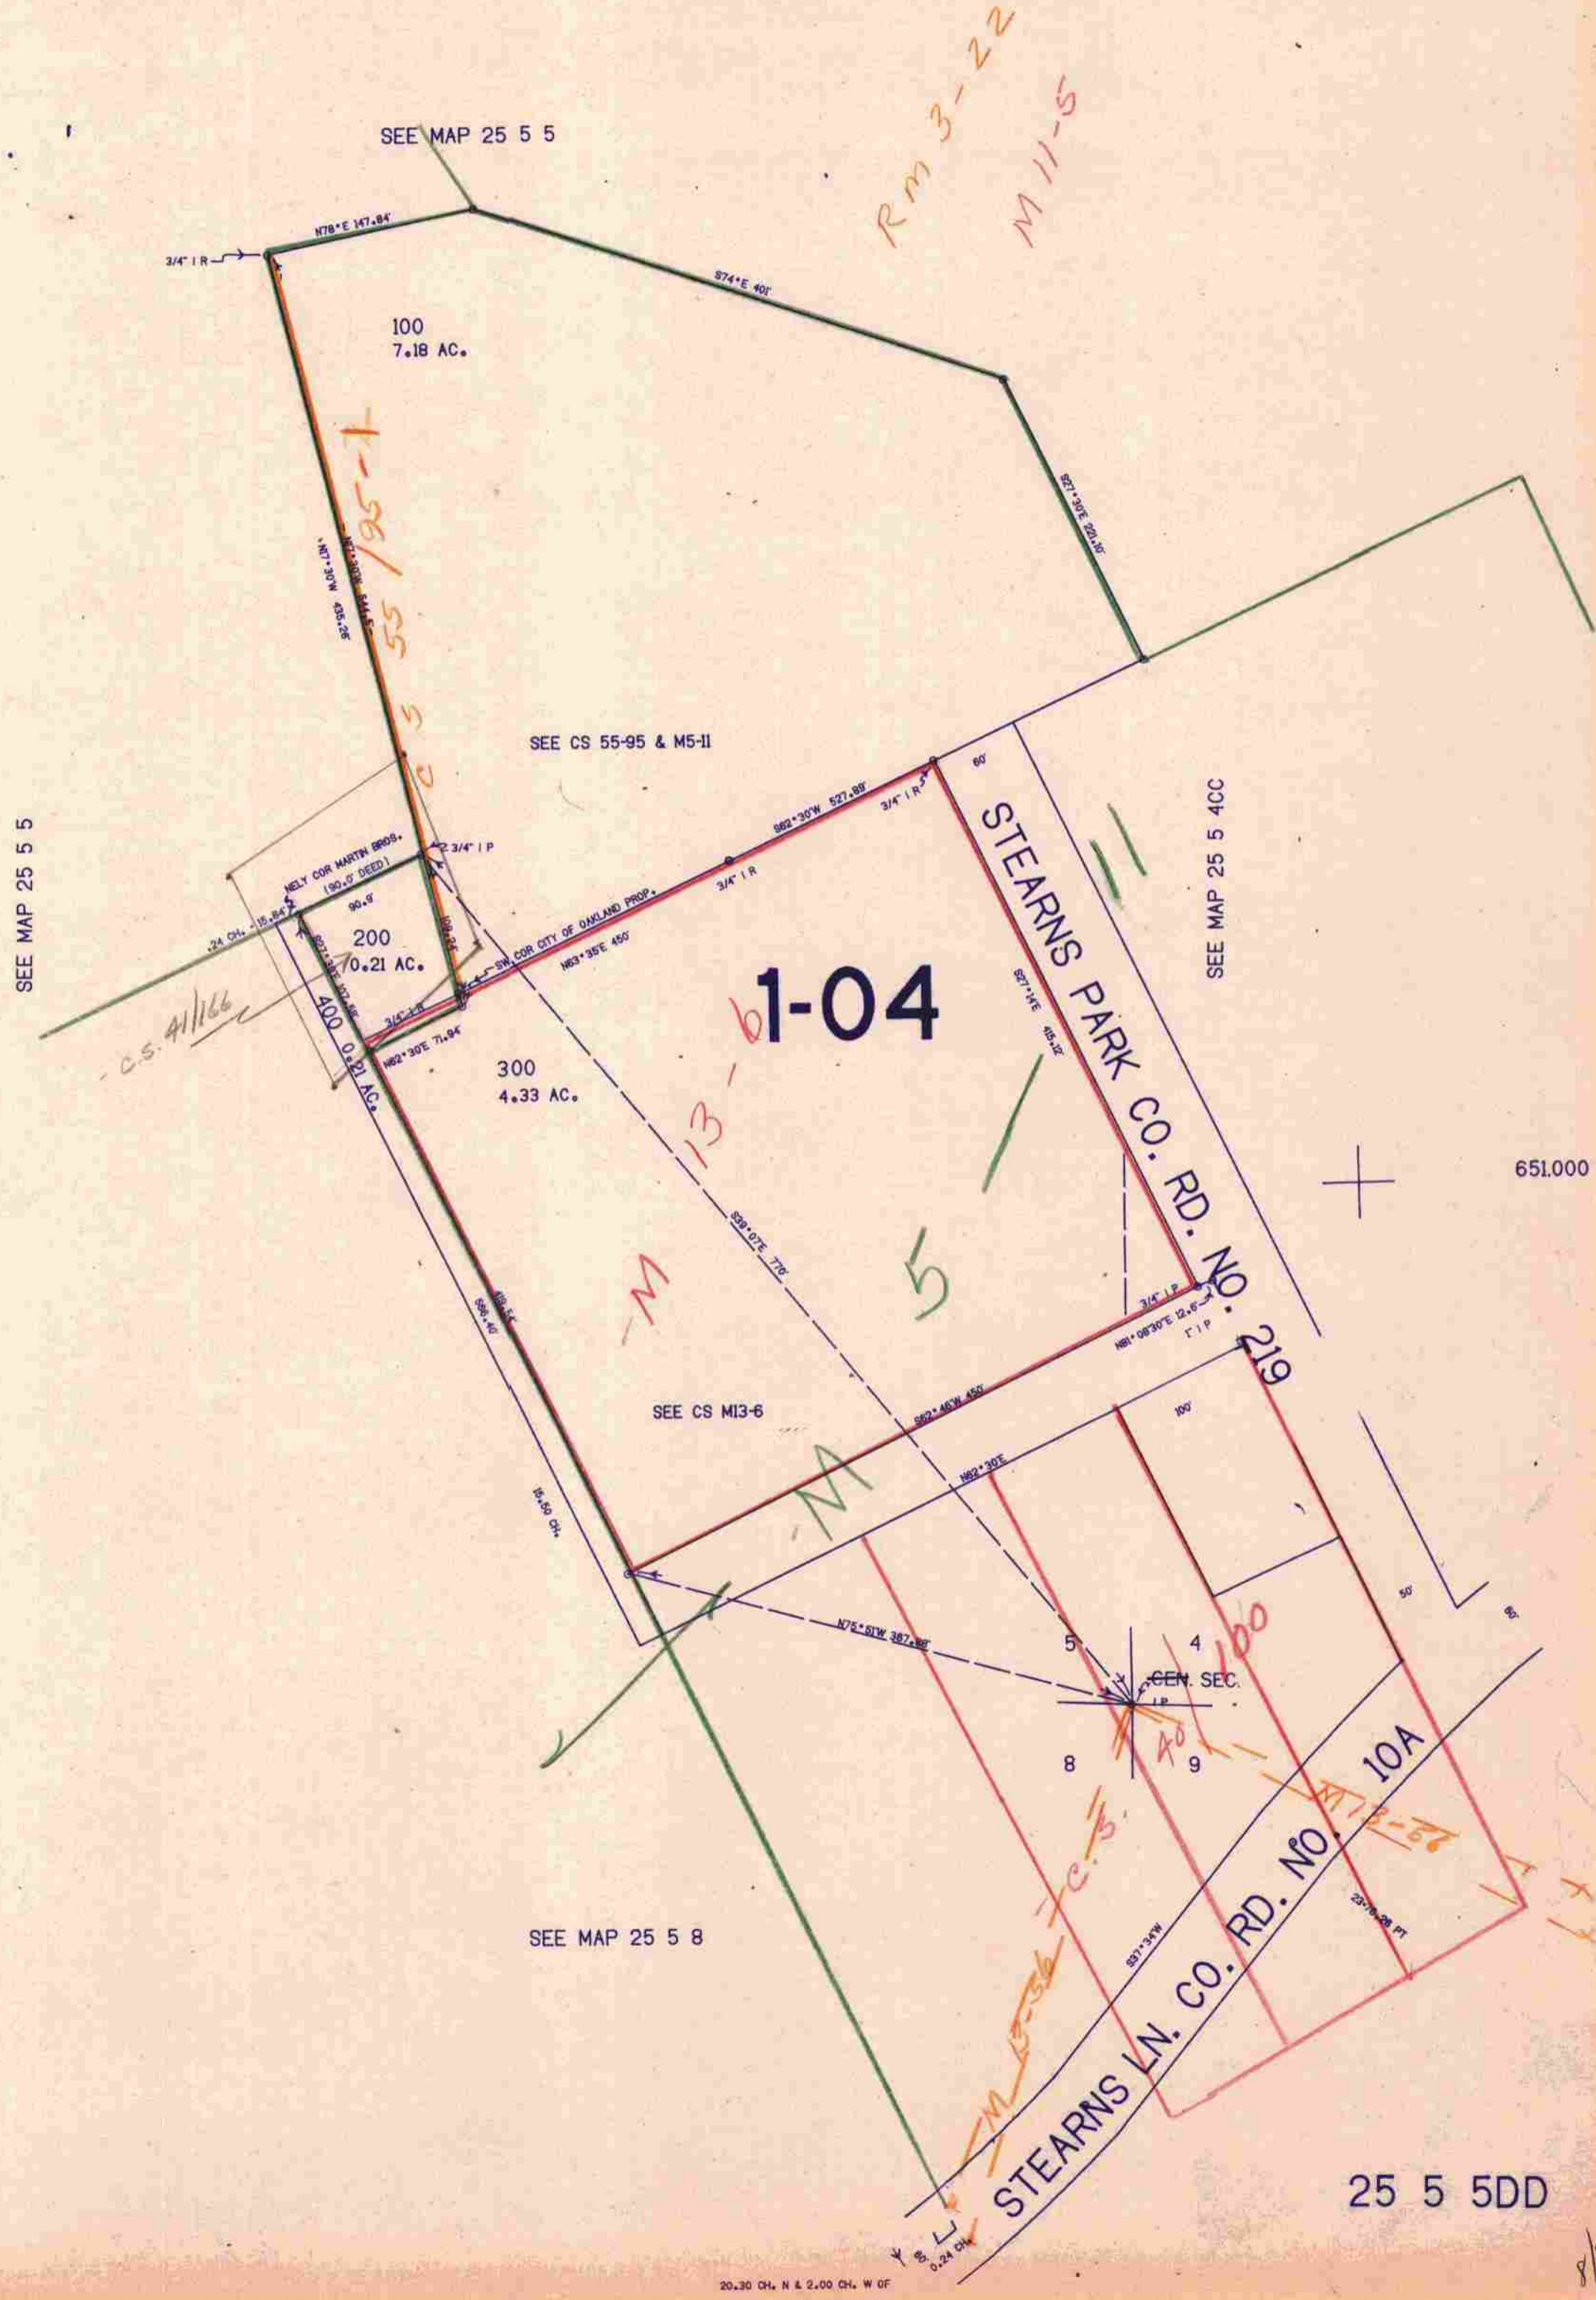

SEE MAP 25 5 5

SEE MAP 25 5 5

SEE CS 55-95 & M5-11

SEE MAP 25 5 400

1-04

SEE CS M13-6

SEE MAP 25 5 8

651.000

1/16 COR.

1.254.000

20.30 CH. N & 2.00 CH. W OF
MT. AND. COR. BEARON. REEDY'S FILE

CONTROL 4-8-77 LAYOUT 2-2-77

8/100