


THIS MAP WAS PREPARED FOR
ASSESSMENT PURPOSE ONLY

SEC. 15 T.25S. R. 5W W.M.
DOUGLAS COUNTY

REVISED ON
11-30-98

25 5 15
& INDEX
SUTHERLIN

1"=400'

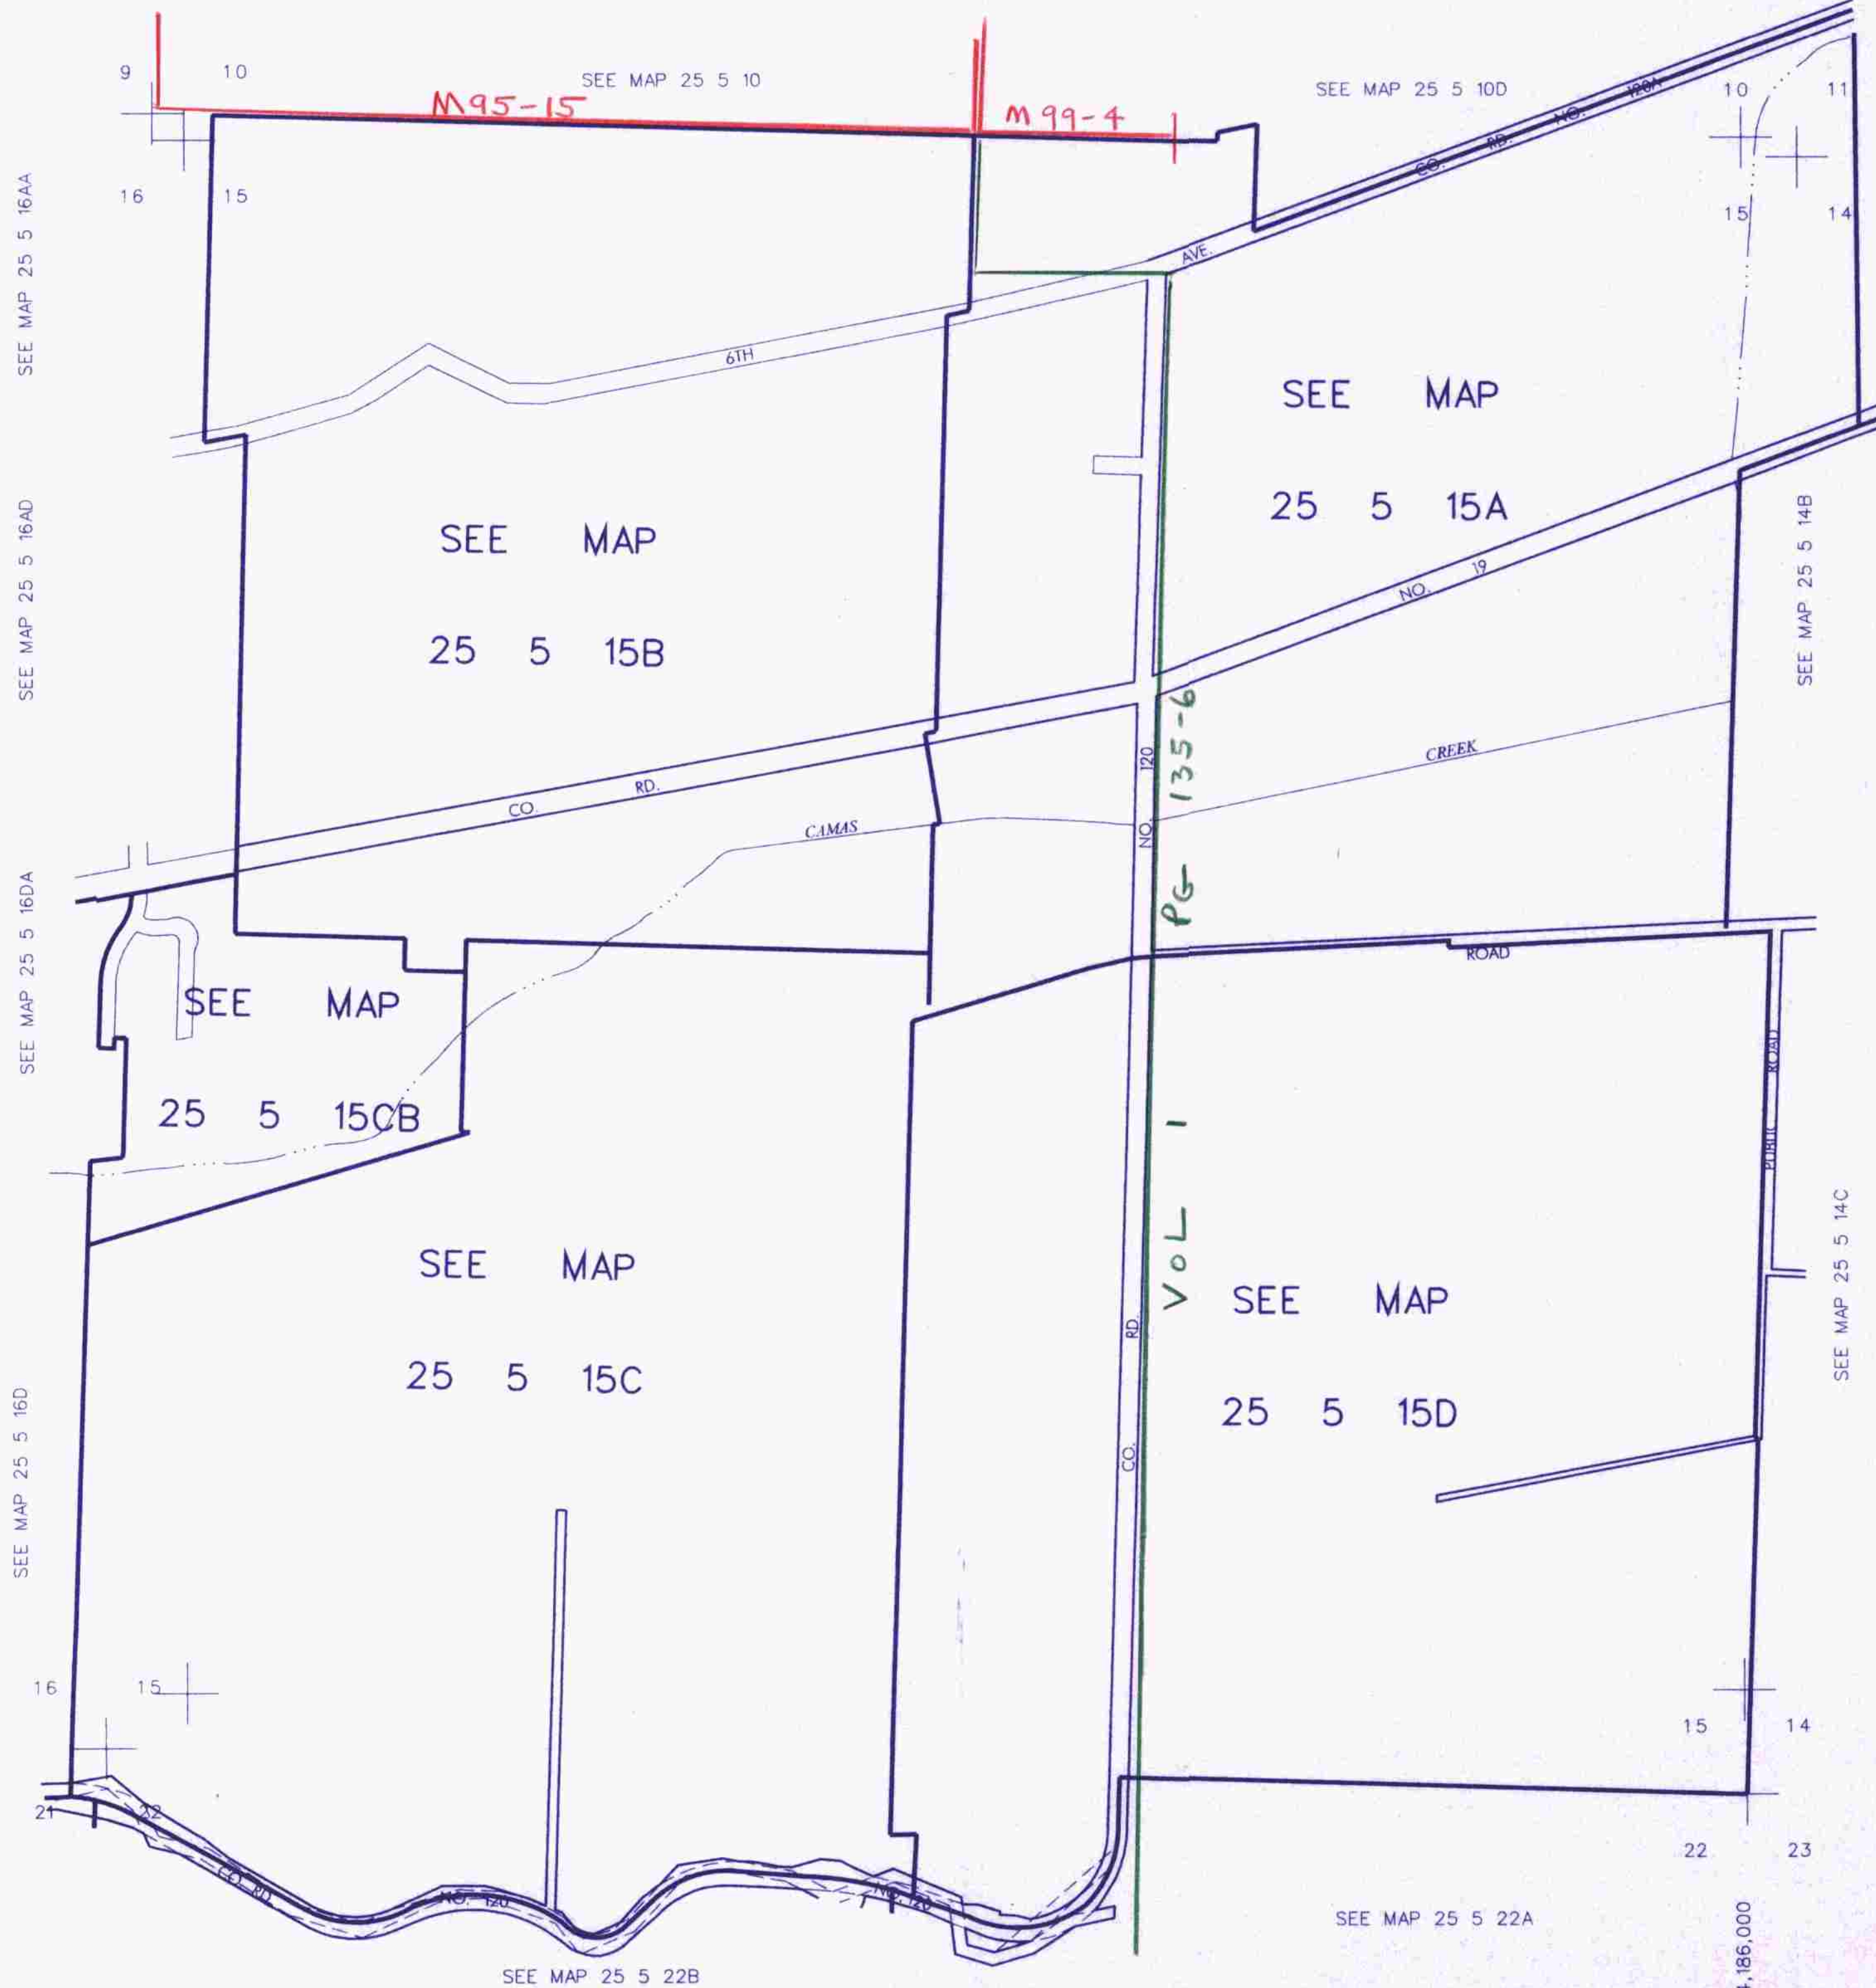

CANCELLED NO'S

640,000

4,186,000

25 5 15
& INDEX
SUTHERLIN
12-1-98
12-1-98