


SECTION 23 T.25S. R.5W. W.M.  
DOUGLAS COUNTY

25 5 23  
INDEX

THIS MAP WAS PREPARED FOR  
ASSESSMENT PURPOSE ONLY.

1"=400'

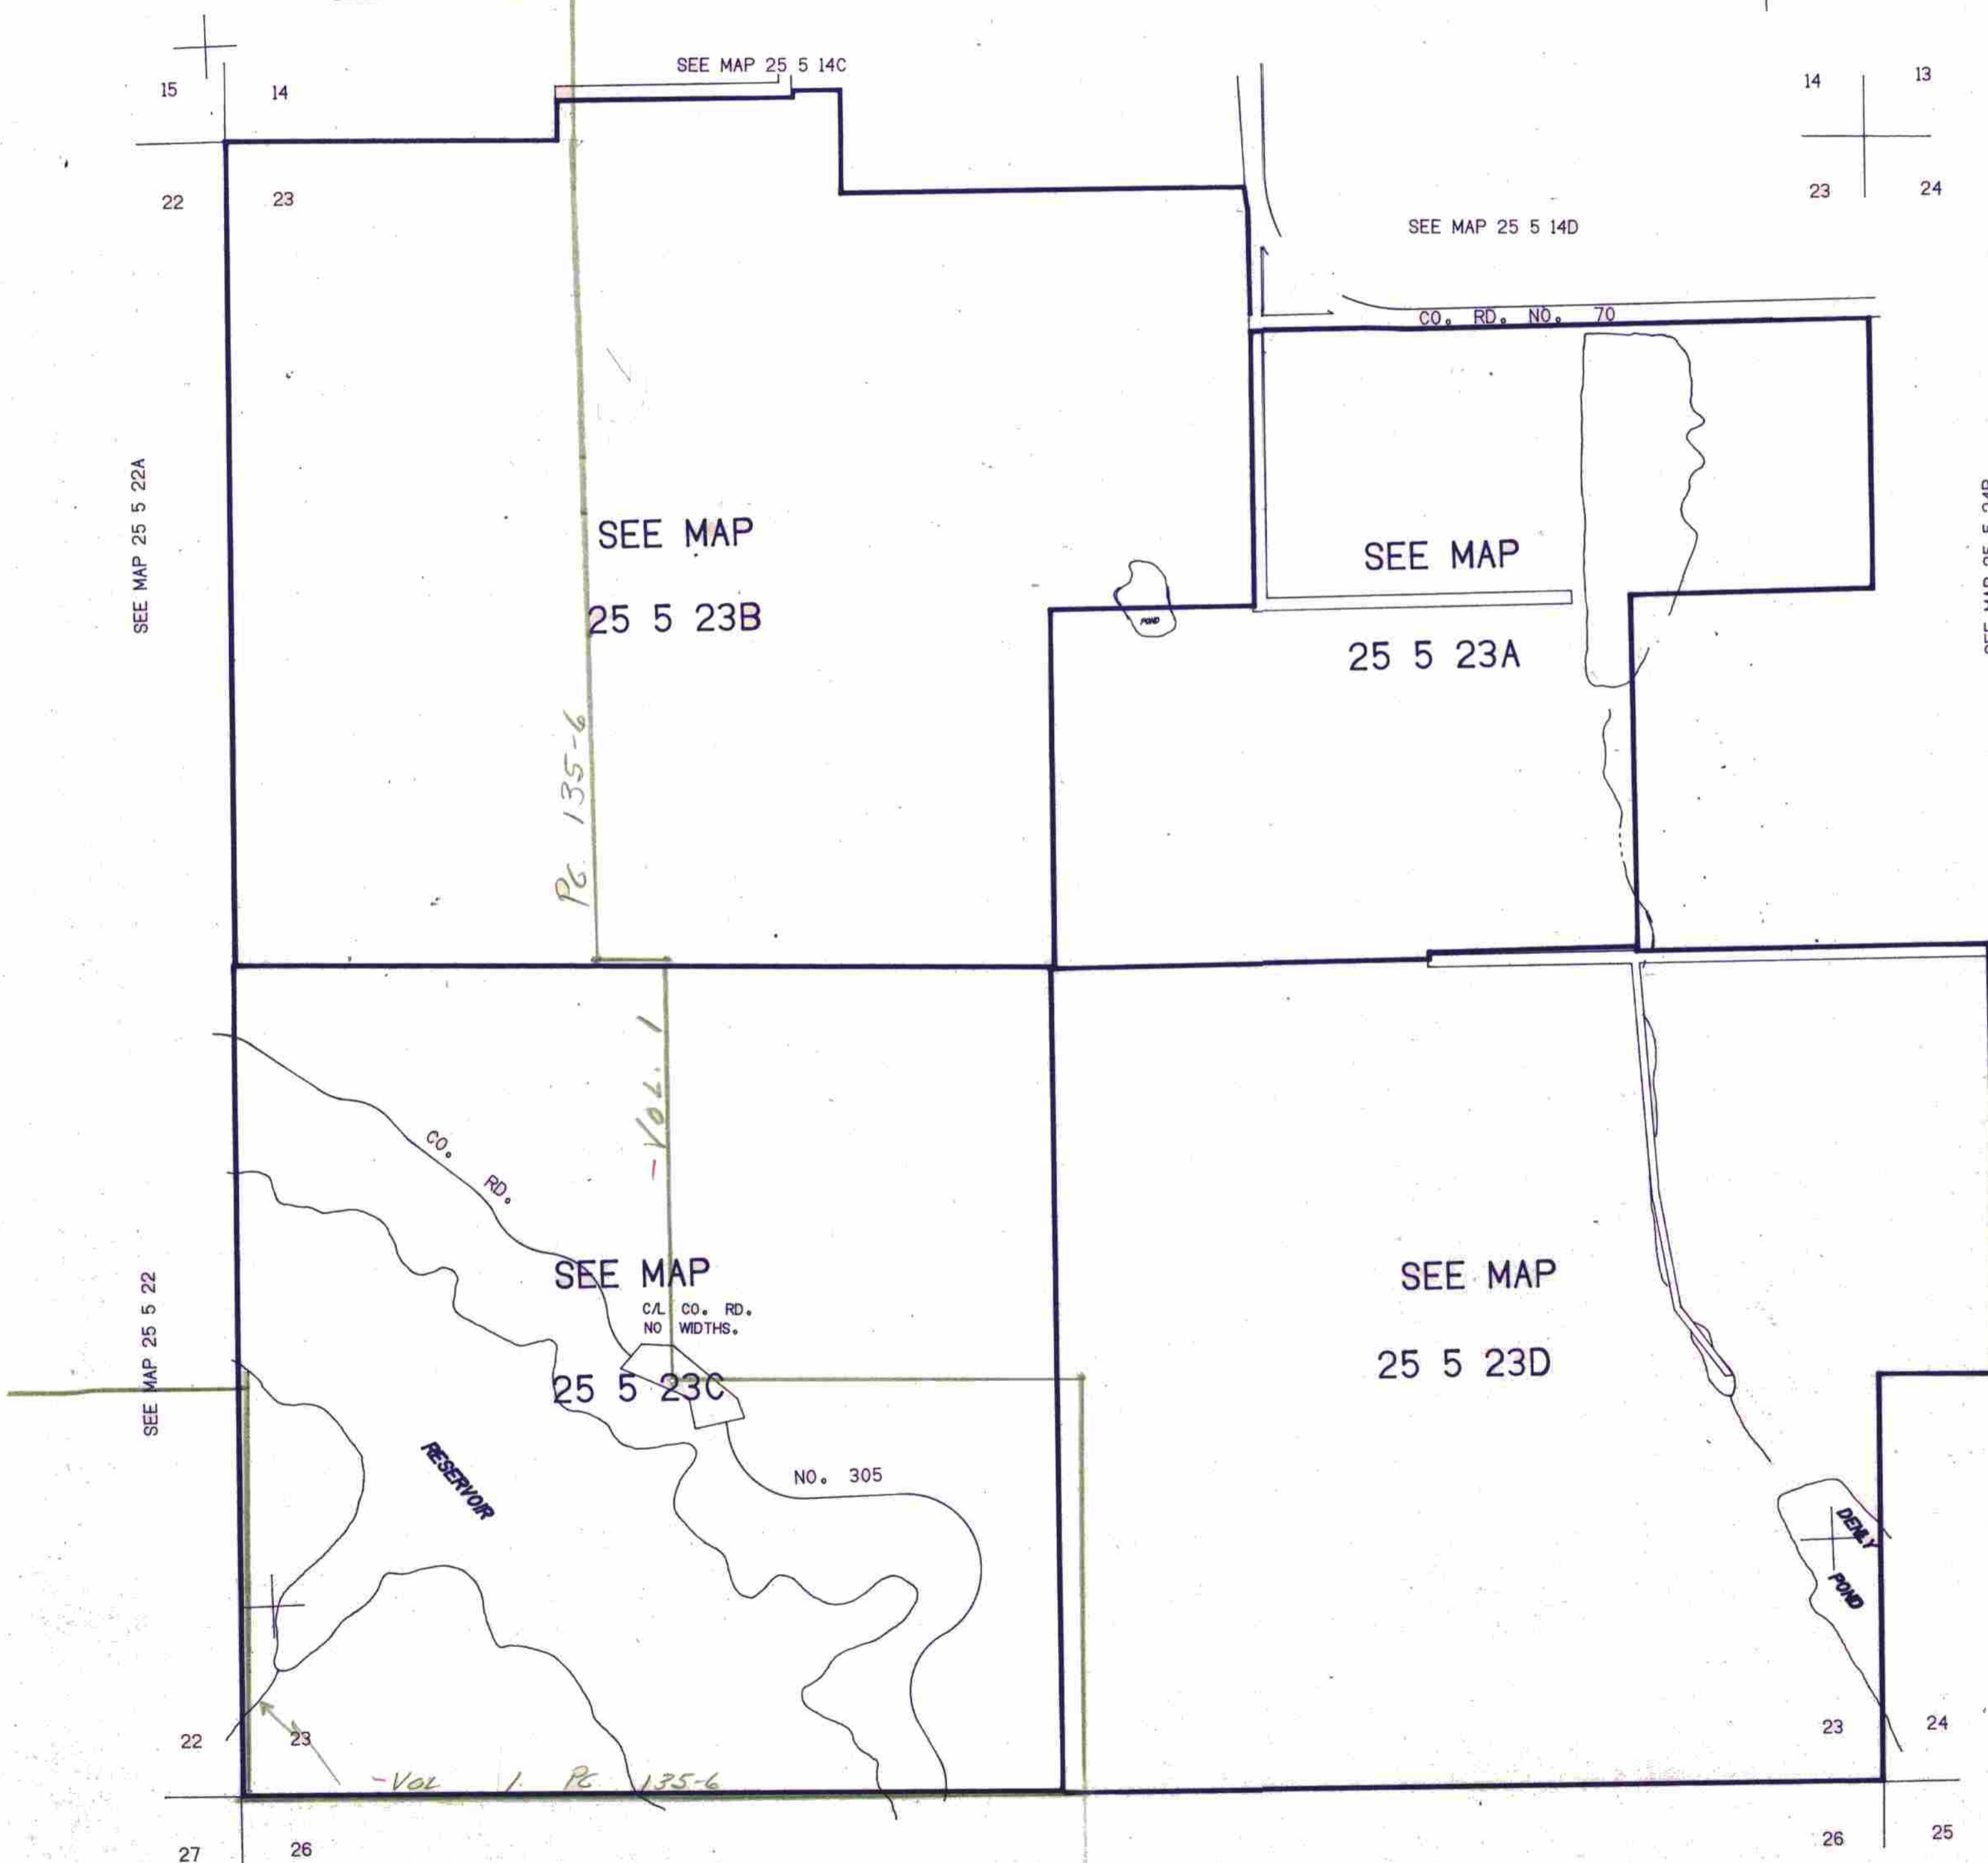

SEE MAP 25 5 22A

SEE MAP 25 5 14C

14 13  
23 24

SEE MAP 25 5 14D

CO. RD. NO. 70

SEE MAP  
25 5 23B

SEE MAP  
25 5 23A

SEE MAP 25 5 24B

*Pg. 135-6*

*-Vol. 1*

SEE MAP 25 5 22

SEE MAP  
C/L CO. RD.  
NO WIDTHS.  
25 5 23C

SEE MAP  
25 5 23D

SEE MAP 25 5 24C

RESERVOIR

NO. 305

DAILY  
POND

*-Vol. 1 Pg. 135-6*

SEE MAP 25 5 26

25 5 23  
INDEX

CONTROL 6/11/2008 LAYOUT 5/12/08 TRACED 5/12/08 CHECKED