


SW1/4 SEC. 9 T.26S. R. 1 W.W.M.
DOUGLAS COUNTY

26 | 9C

THIS MAP WAS PREPARED FOR
ASSESSMENT PURPOSE ONLY.

1" = 200'

SEE MAP 26 1

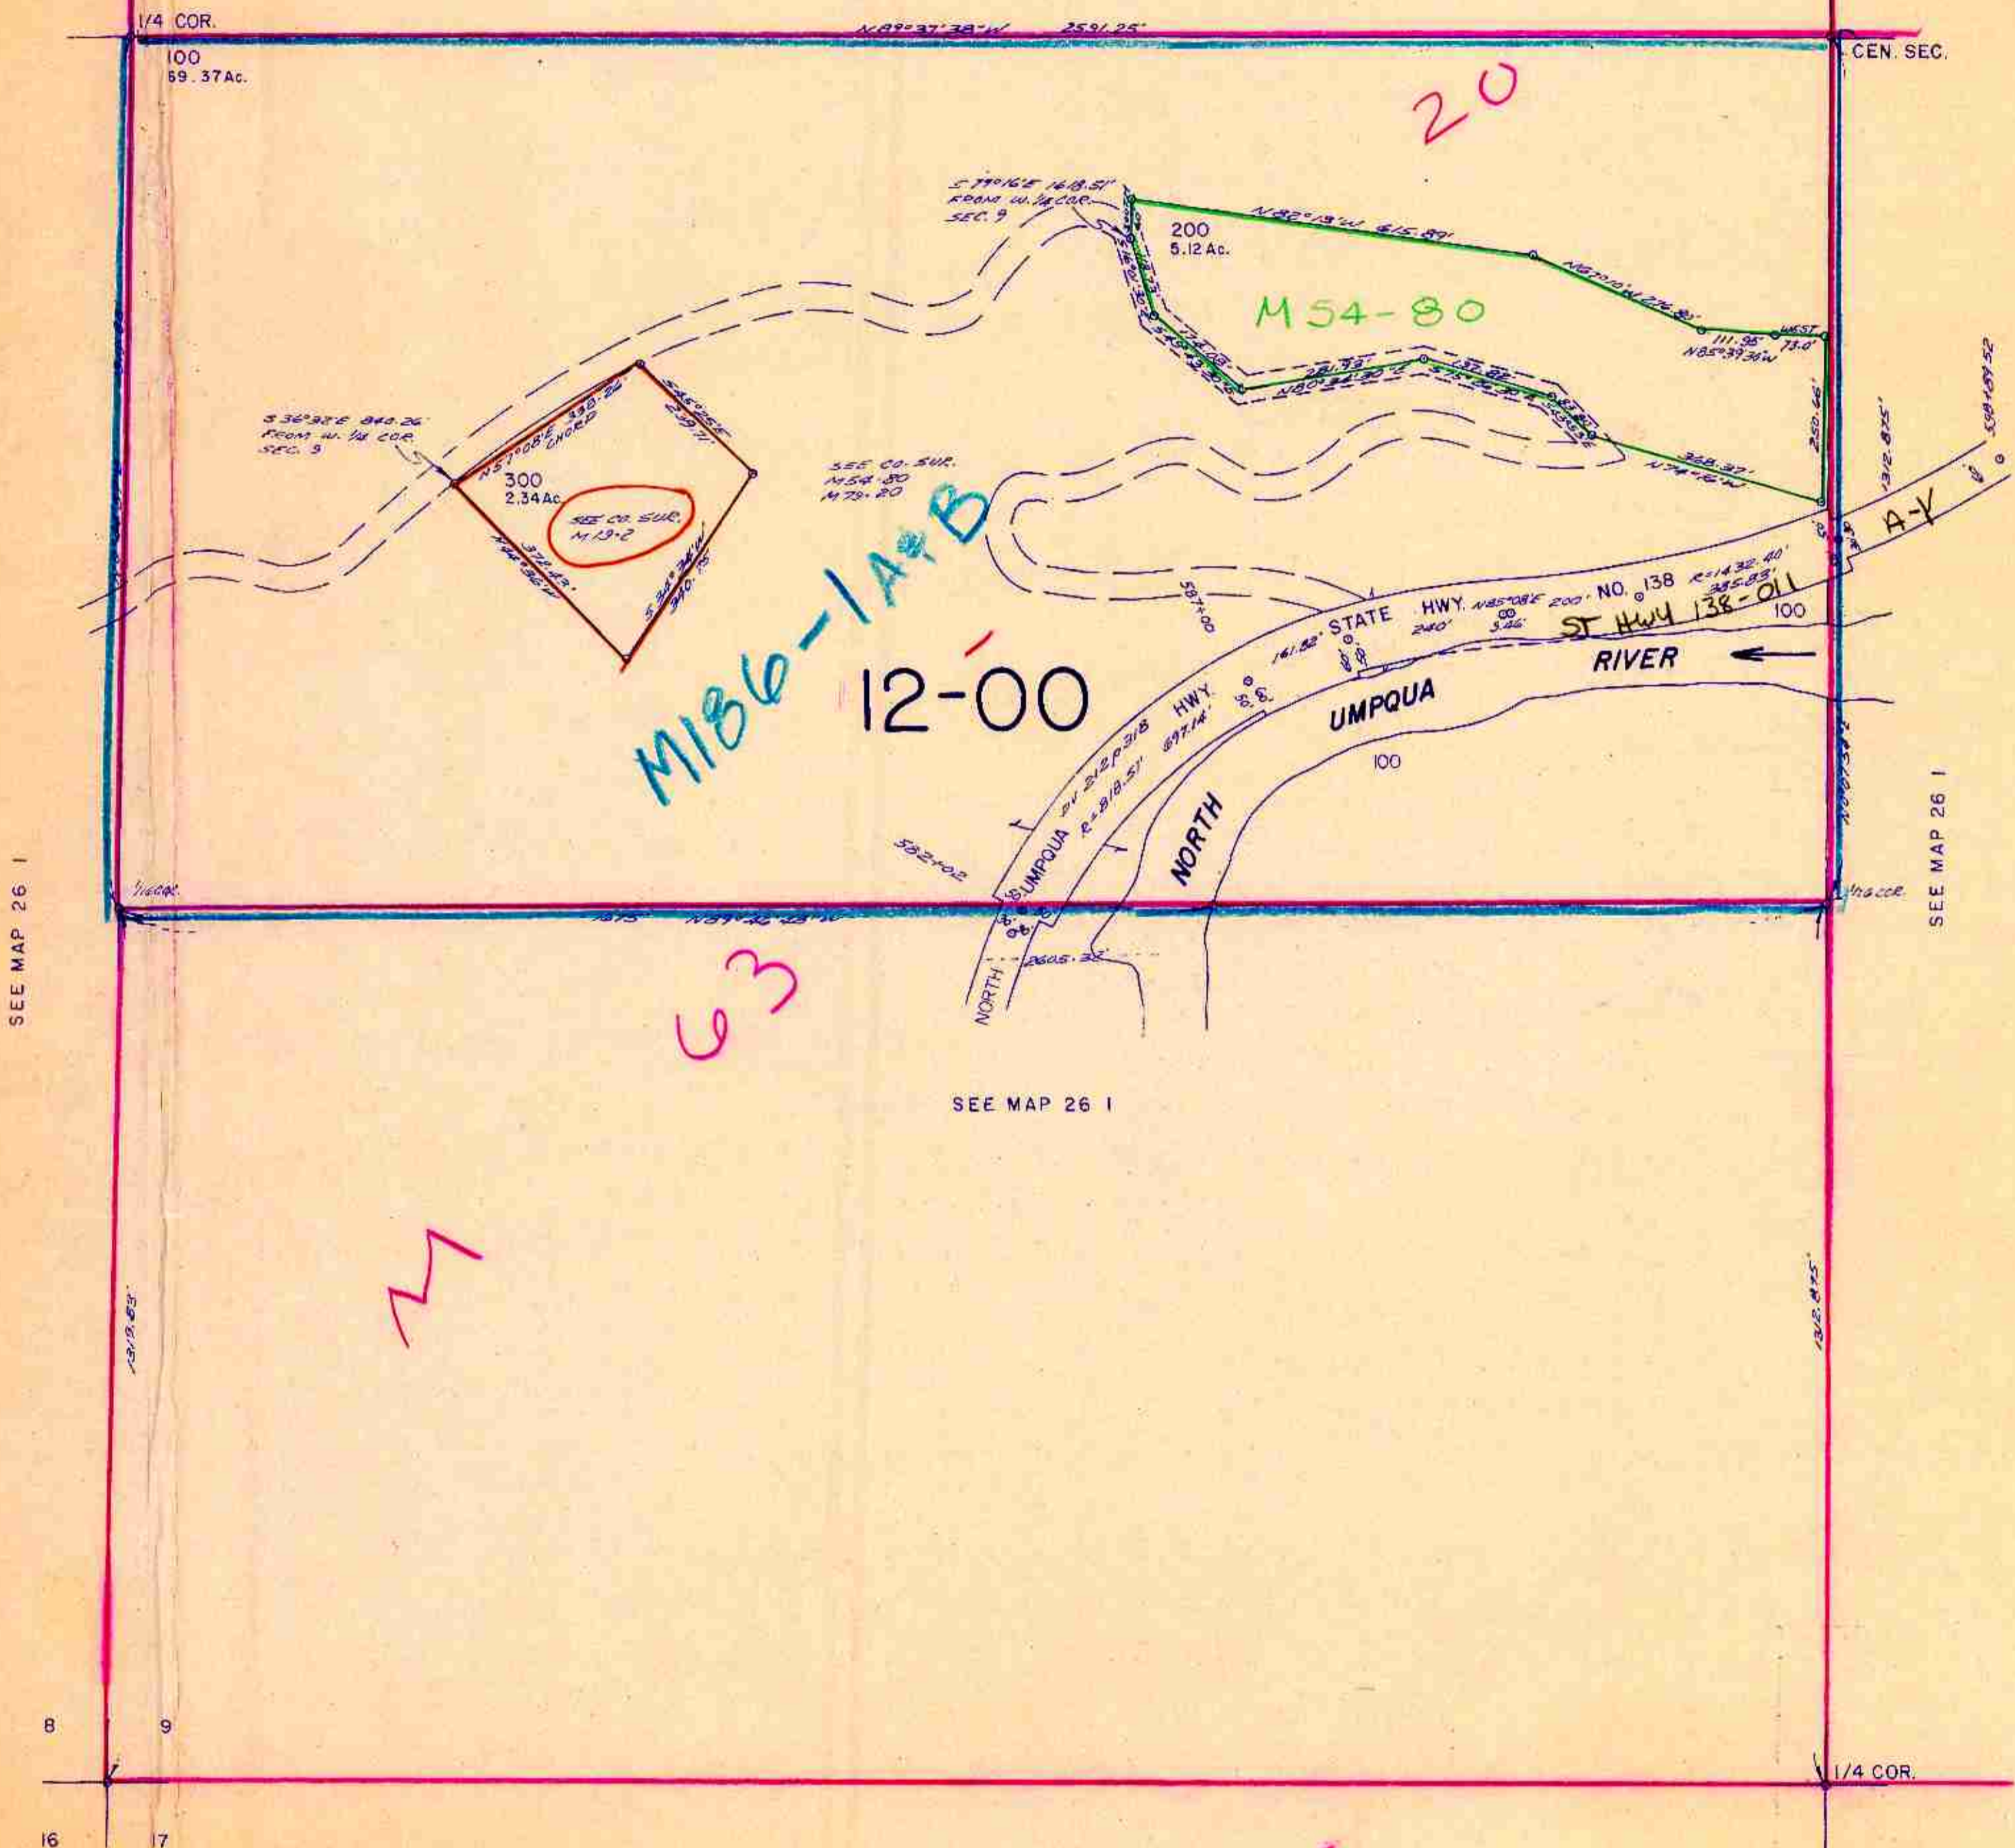

SEE MAP 26 1

SEE MAP 26 1

8 9
16 17

9/99 26 | 9C
JC JP