


THIS MAP WAS PREPARED FOR ASSESSMENT PURPOSE ONLY.

SEC.13 T.26S. R.2W. W.M.  
DOUGLAS COUNTY

REVISED ON  
7-8-09

26 2 13

1" = 400'

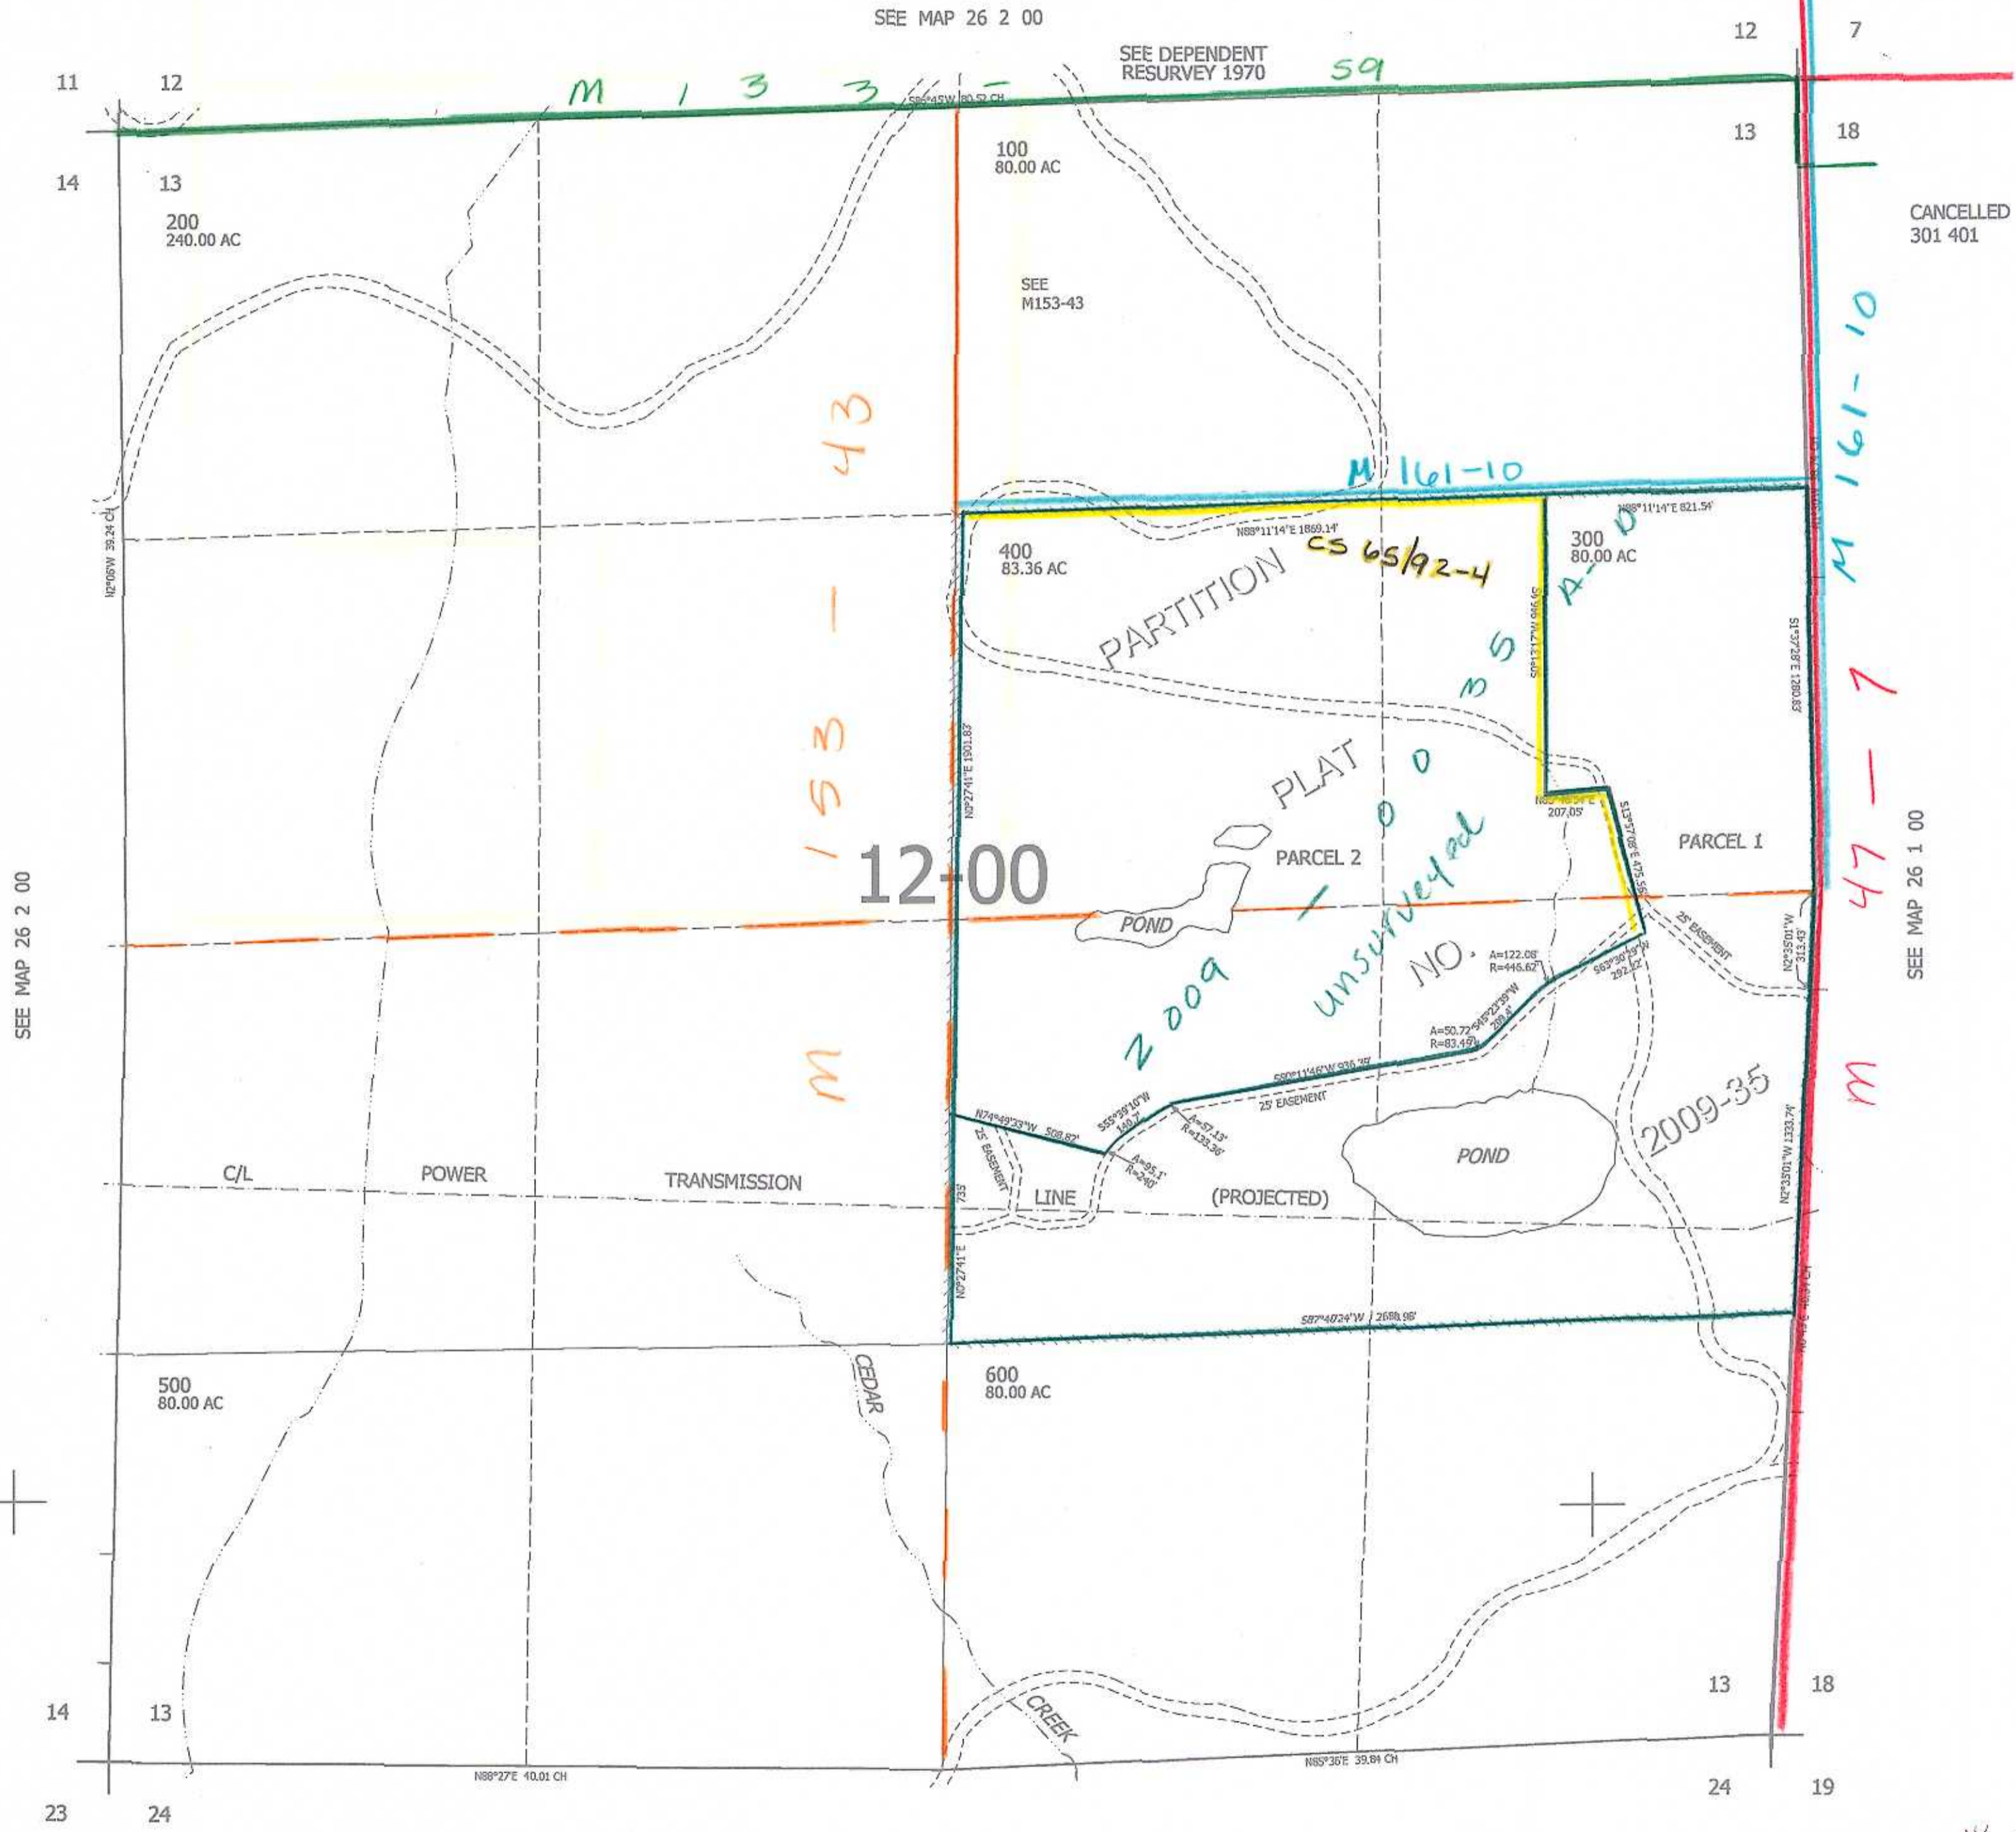

SEE MAP 26 2 00

12-00

SEE MAP 26 1 00

605,000

4,289,000

GMC  
1/20/09  
JC

26 2 13