


THIS MAP WAS PREPARED FOR ASSESSMENT PURPOSE ONLY.

SECTION 4 T.26S. R.4W. W.M.  
DOUGLAS COUNTY

REVISED ON  
3-1-96

26 4 4

1"=400'

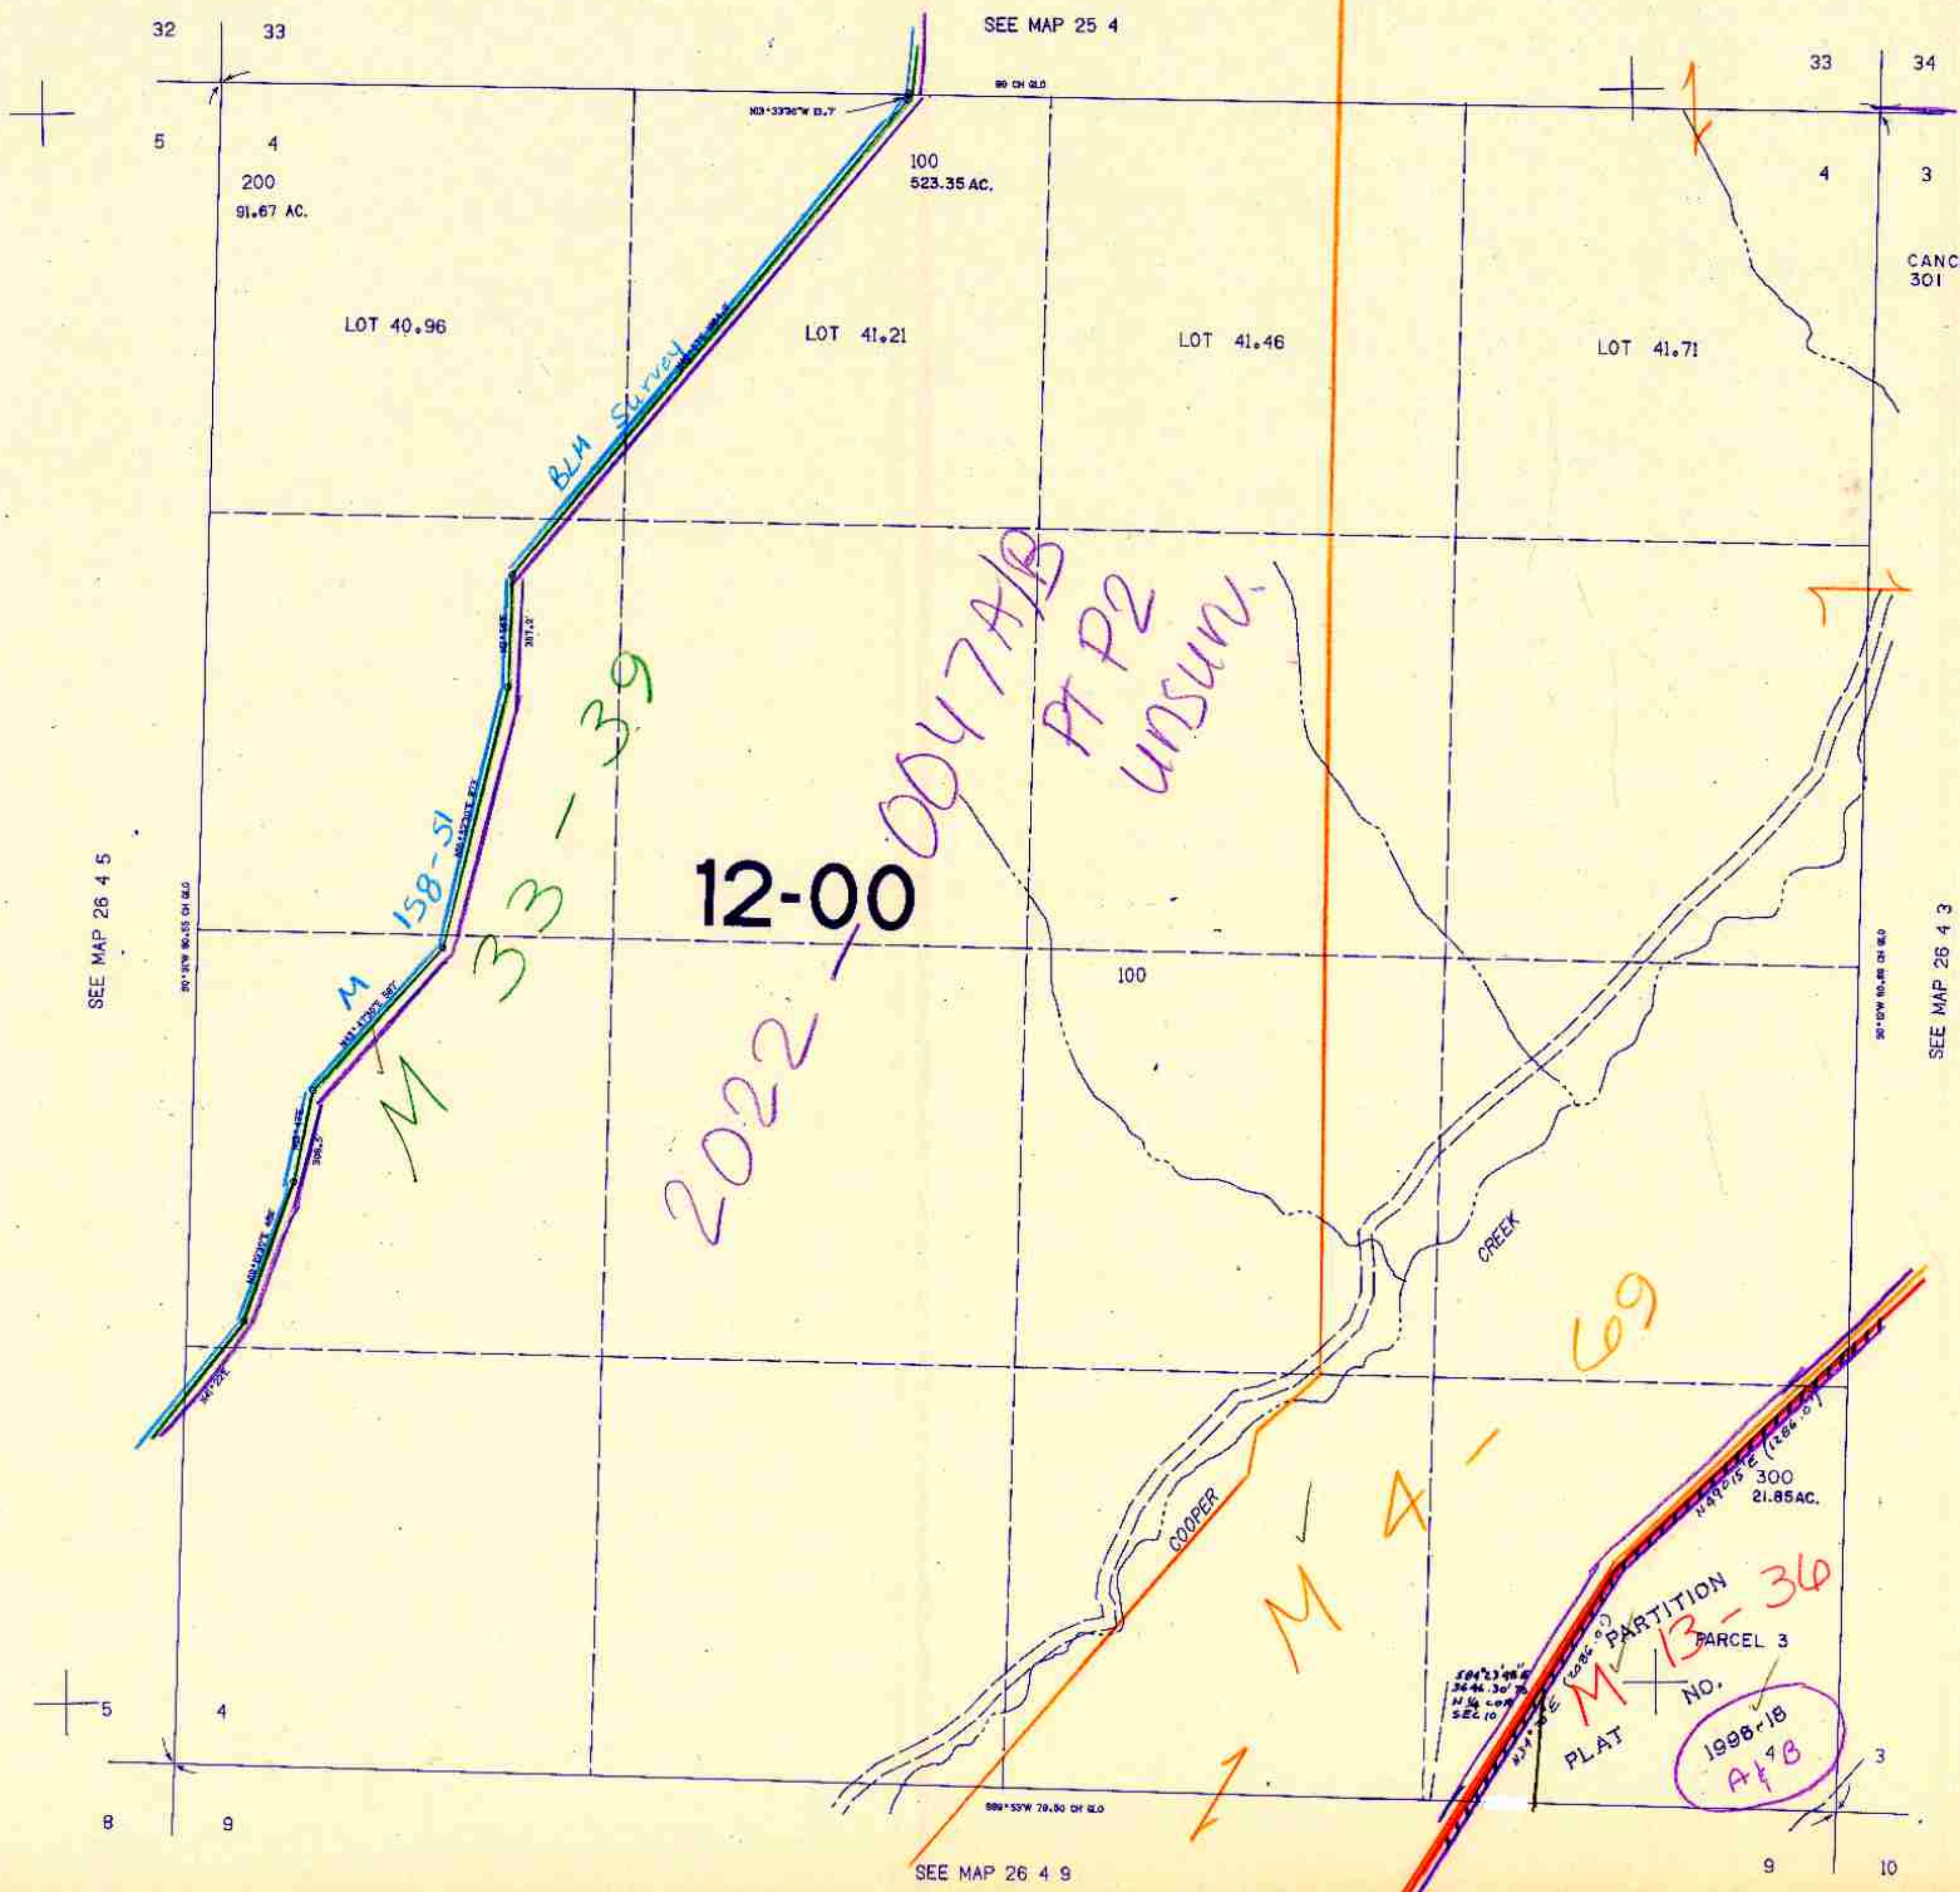

CANCELLED PARCEL NO'S  
301

618.000

26 4 4

Handwritten initials/signature