


This map was prepared for assessment purpose only.

NE 1/4 NE 1/4 SEC. 30 T.26S. R.5W. W.M.  
DOUGLAS COUNTY

26 5 30AA

1"=100'

SEE MAP 26 5 19DD

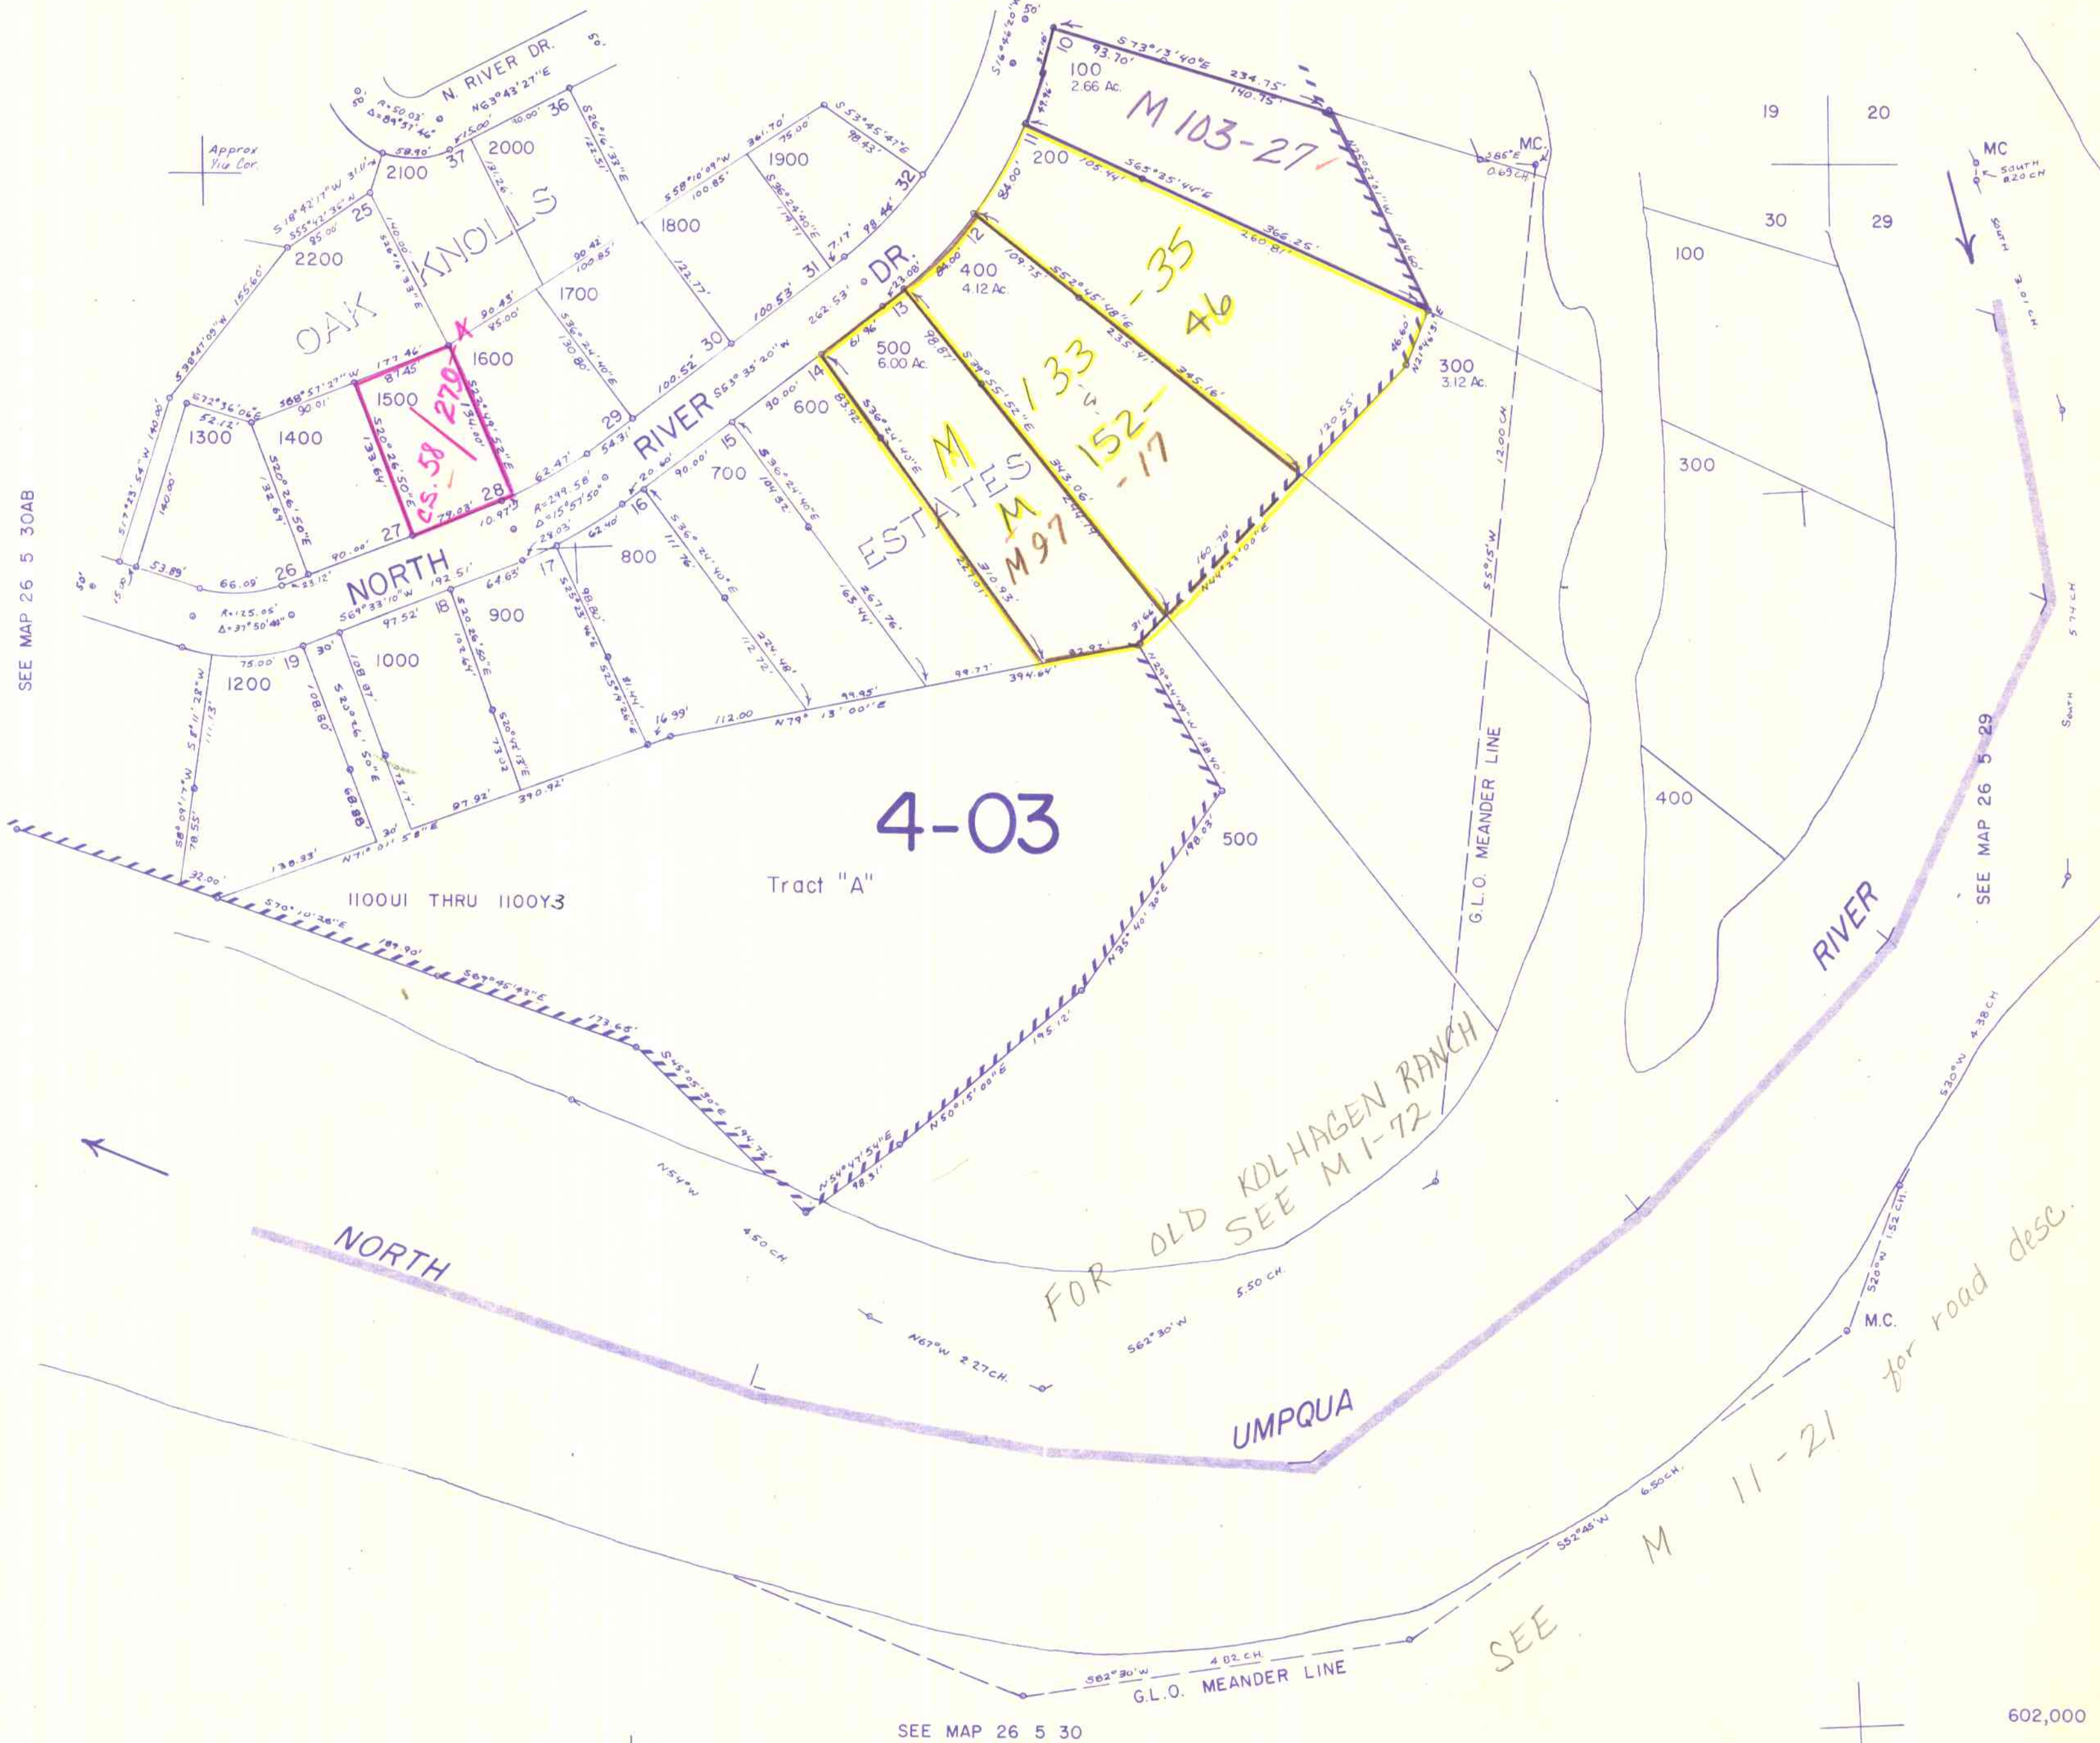

SEE MAP 26 5 30AB

SEE MAP 26 5 29

4-03

Tract "A"

NORTH

FOR OLD KOLHAGEN RANCH  
SEE M 1-72

UMPQUA

SEE M 11-21 for road desc.

SEE MAP 26 5 30

602,000

26 5 30AA

1/100  
C.B.M.