

THIS MAP WAS PREPARED FOR ASSESSMENT PURPOSE ONLY.


SEC.31 T.26S. R.5W. W.M. DOUGLAS COUNTY

SW COR DLC NO 47

REVISED ON 1-22-20

26 5 31 & INDEX

1" = 400'

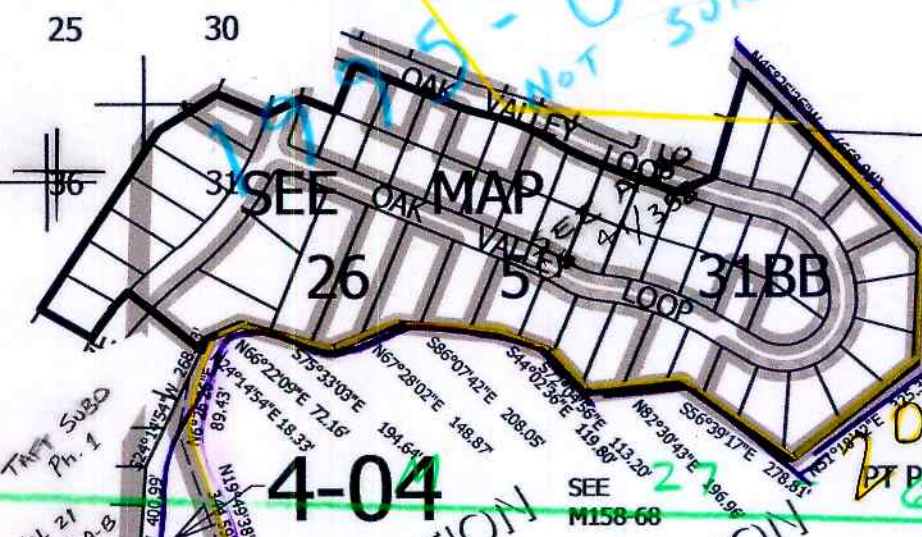

SEE MAP 26 5 30

SEE MAP 26 5 30CC

25 30

4-04

SE COR JOHN AKIN DLC 51

SEE M157-44

RIDGE 2

M 56-4 M 161

78

- CANCELLED NO'S
- 1201 1301 303
- 304 THRU 310
- 300 302 1200
- 1302 1303
- 1400 THRU 1701
- 1100 1300 1800
- 1900 2100 2000
- 200 100

4-00

NE COR WM J MARTIN DLC NO 50

NE COR W J MARTIN DLC NO 64

NW COR DLC 50 400 48.65 AC

500 0.73 AC

605 5.00 AC

600 8.22 AC

602 5.00 AC

603 5.00 AC

700 5.00 AC

800 5.00 AC

900 5.00 AC

1000 5.00 AC

4-03

SUBDIVISION A 49

SEE MAP M 20-60

SEE MAP M 154

DAVIS CREEK

A 20

KENNETH FORD DRIVE

26 5 31C

26 5 31D

SE COR DLC 64 SW COR DLC 50

SE COR DLC 50

NE COR WM J MARTIN DLC NO 48

SEE MAP 27 5 6B

SEE MAP 27 5 6

4,168,000

593,000

31 32

6 5

26 5 31 & INDEX