


THIS MAP WAS PREPARED FOR ASSESSMENT PURPOSE ONLY.

SE 1/4 SEC. 1 T.26 S. R.8 W. W.M. DOUGLAS COUNTY

REVISED ON 10-14-92

26 8 ID

1" = 200'

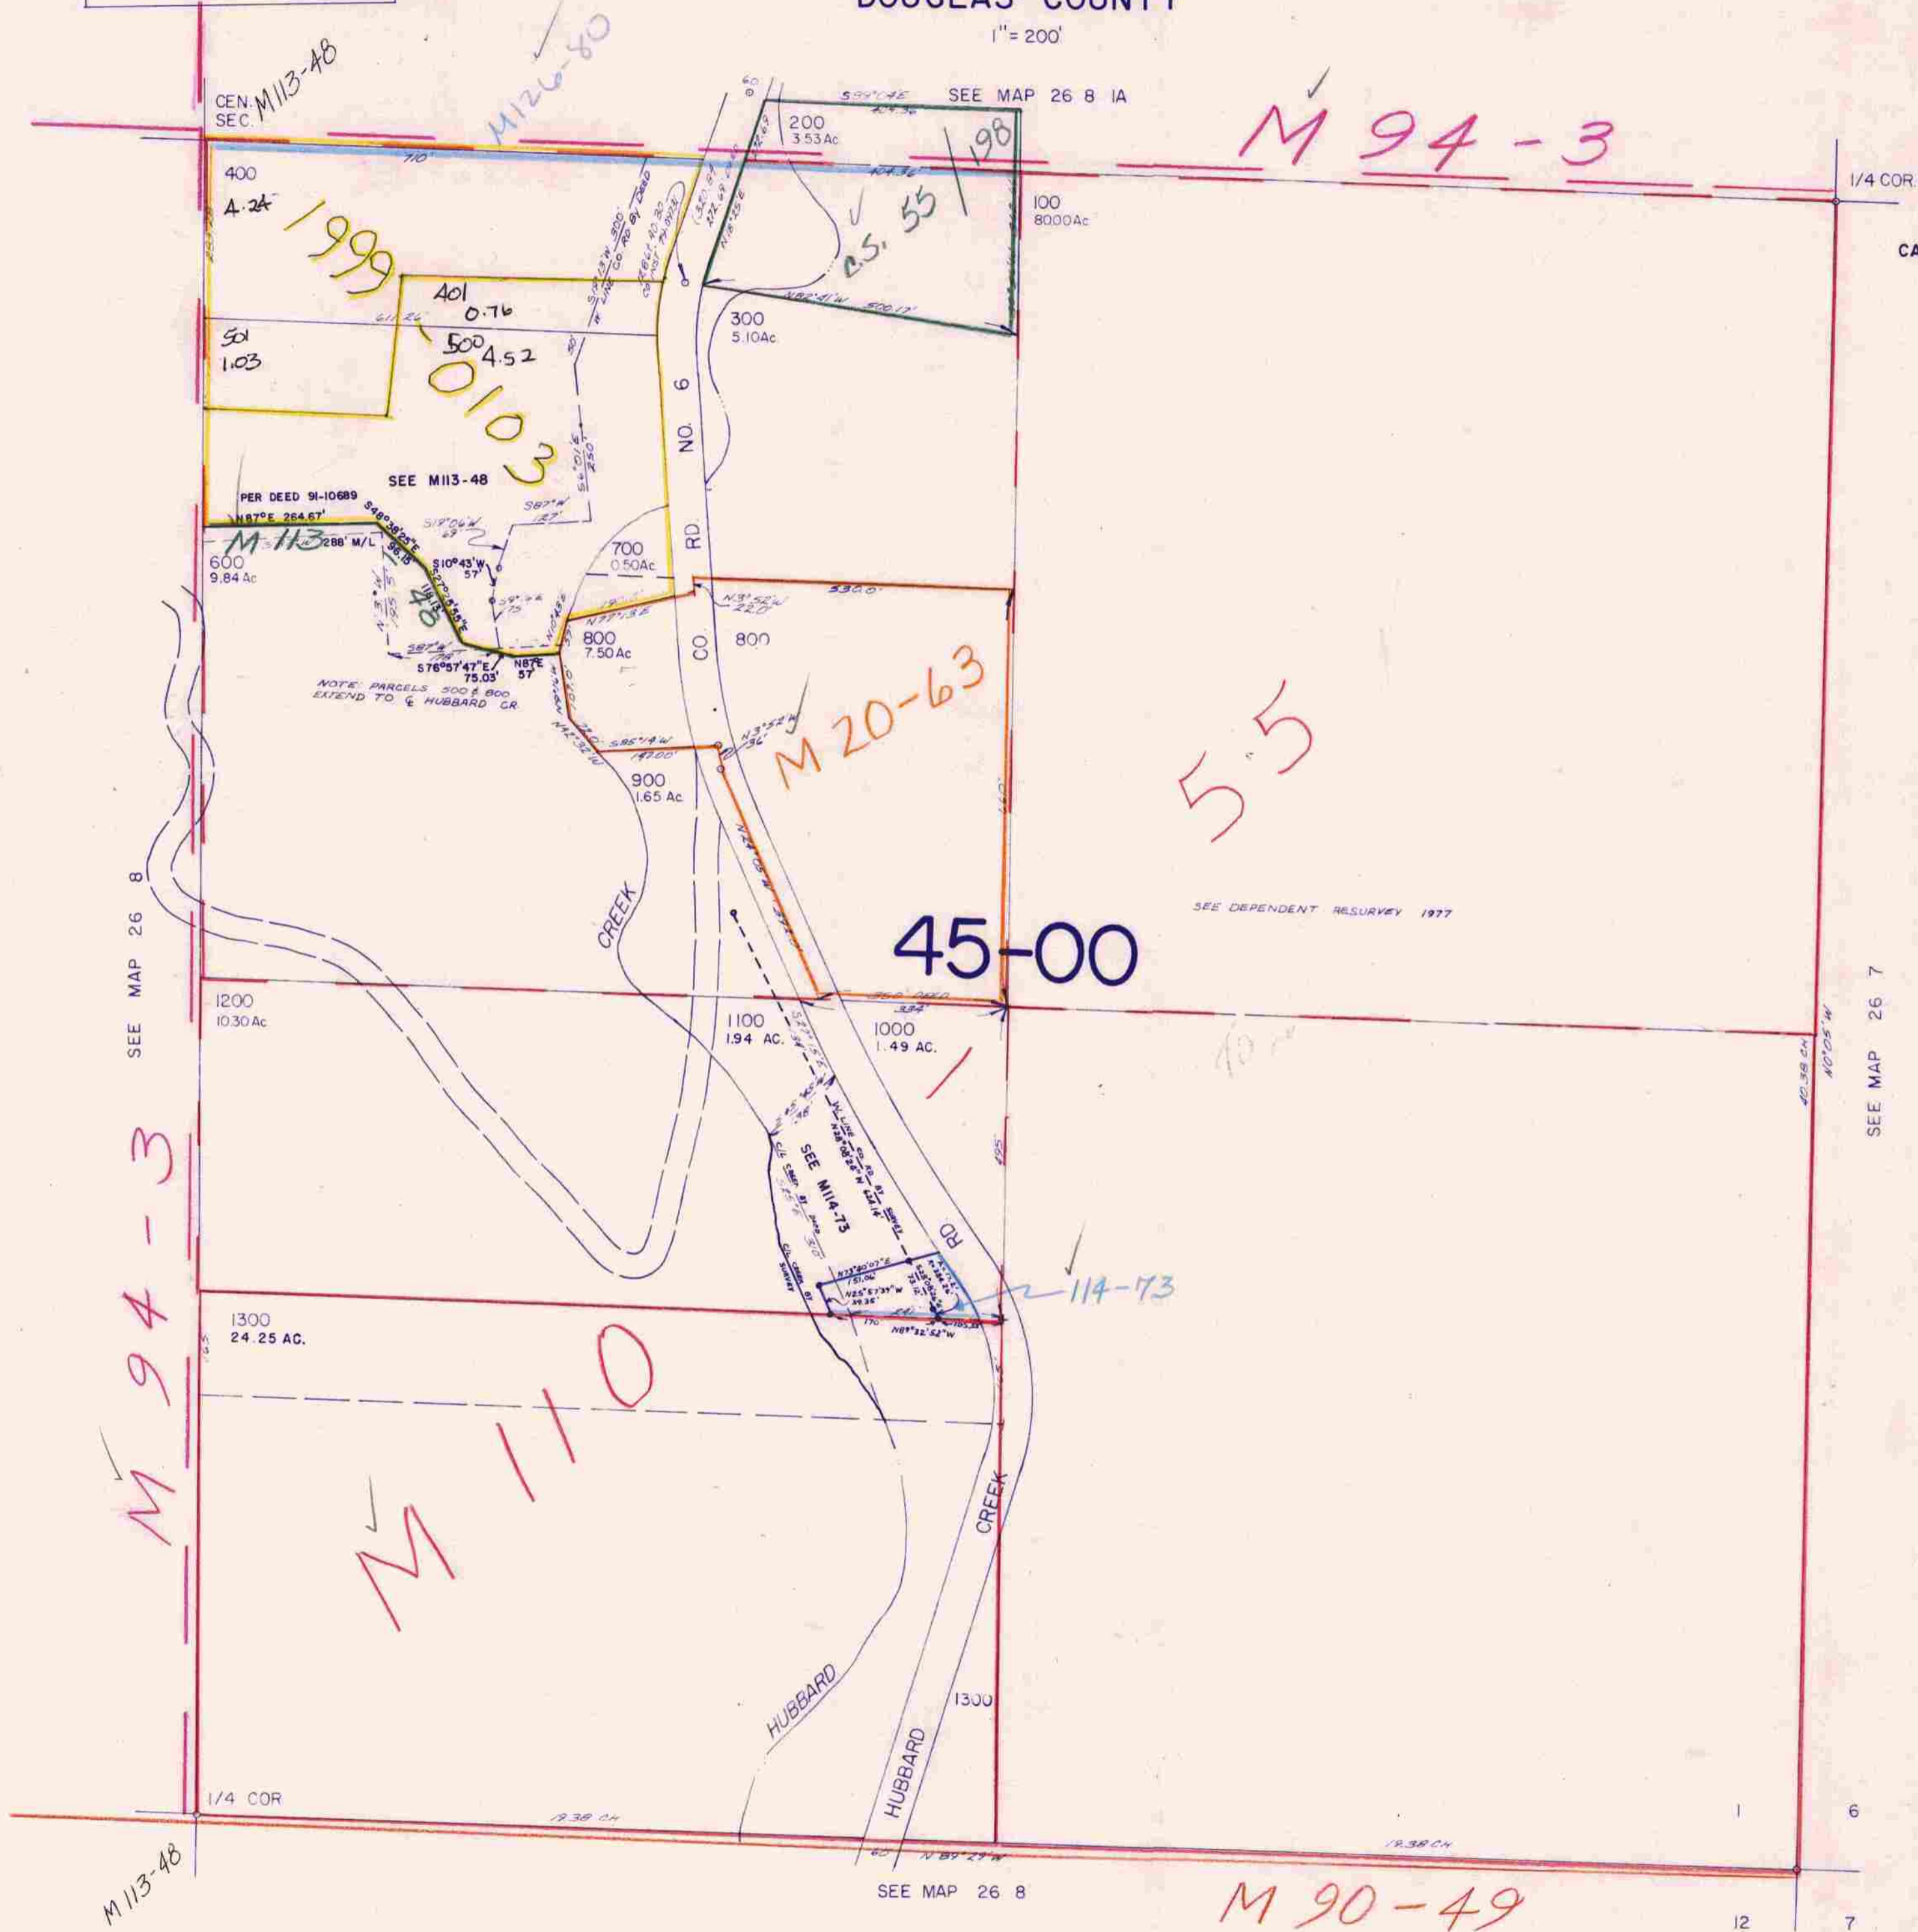

26 8 ID

10192