


THIS MAP WAS PREPARED FOR ASSESSMENT PURPOSE ONLY.

T.27S. R.4E. W.M. DOUGLAS COUNTY

27 4E

1"=2000'

SEE MAP 26 4E

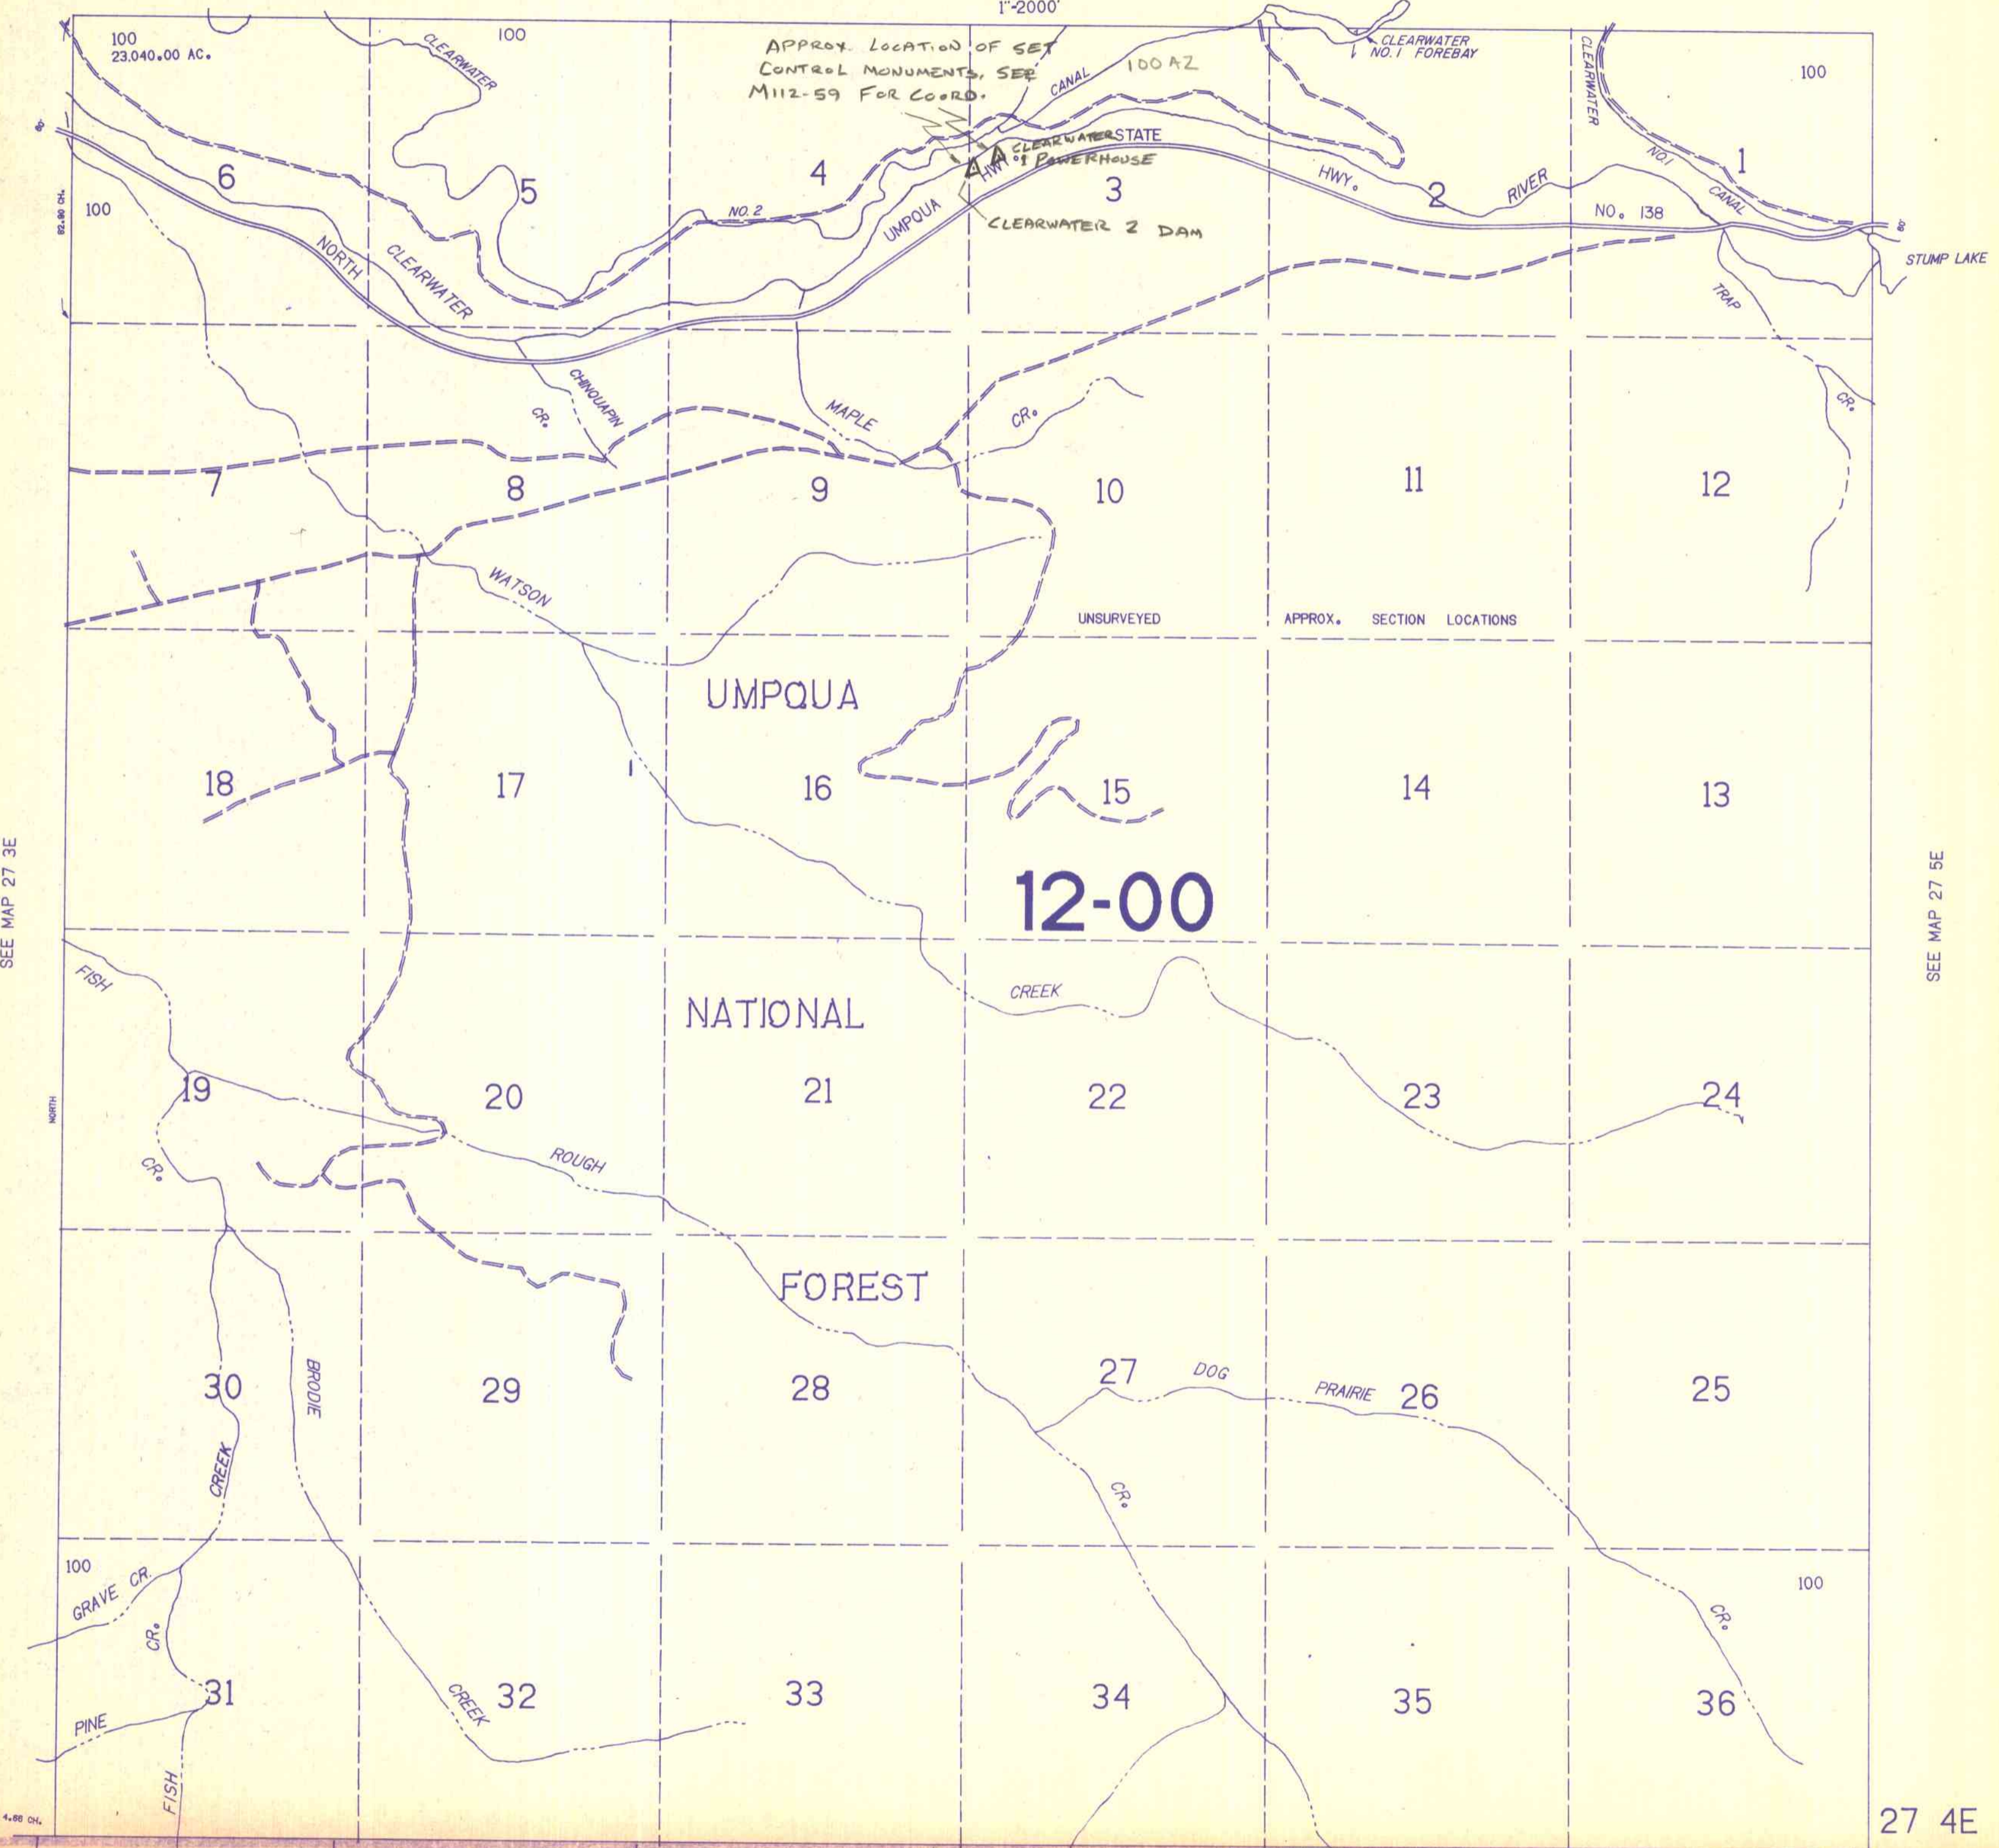

APPROX. LOCATION OF SET CONTROL MONUMENTS, SEE M112-59 FOR COORD.

CLEARWATER STATE POWERHOUSE

CLEARWATER 2 DAM

UNSURVEYED APPROX. SECTION LOCATIONS

12-00

NATIONAL FOREST

SEE MAP 27 3E

SEE MAP 27 5E

SEE MAP 28 4E

27 4E

11/27/88