


T.27S. R.5E. W.M.
DOUGLAS COUNTY

27 5E

THIS MAP WAS PREPARED FOR
ASSESSMENT PURPOSE ONLY.

SEE MAP 26 5E

1"=2000'

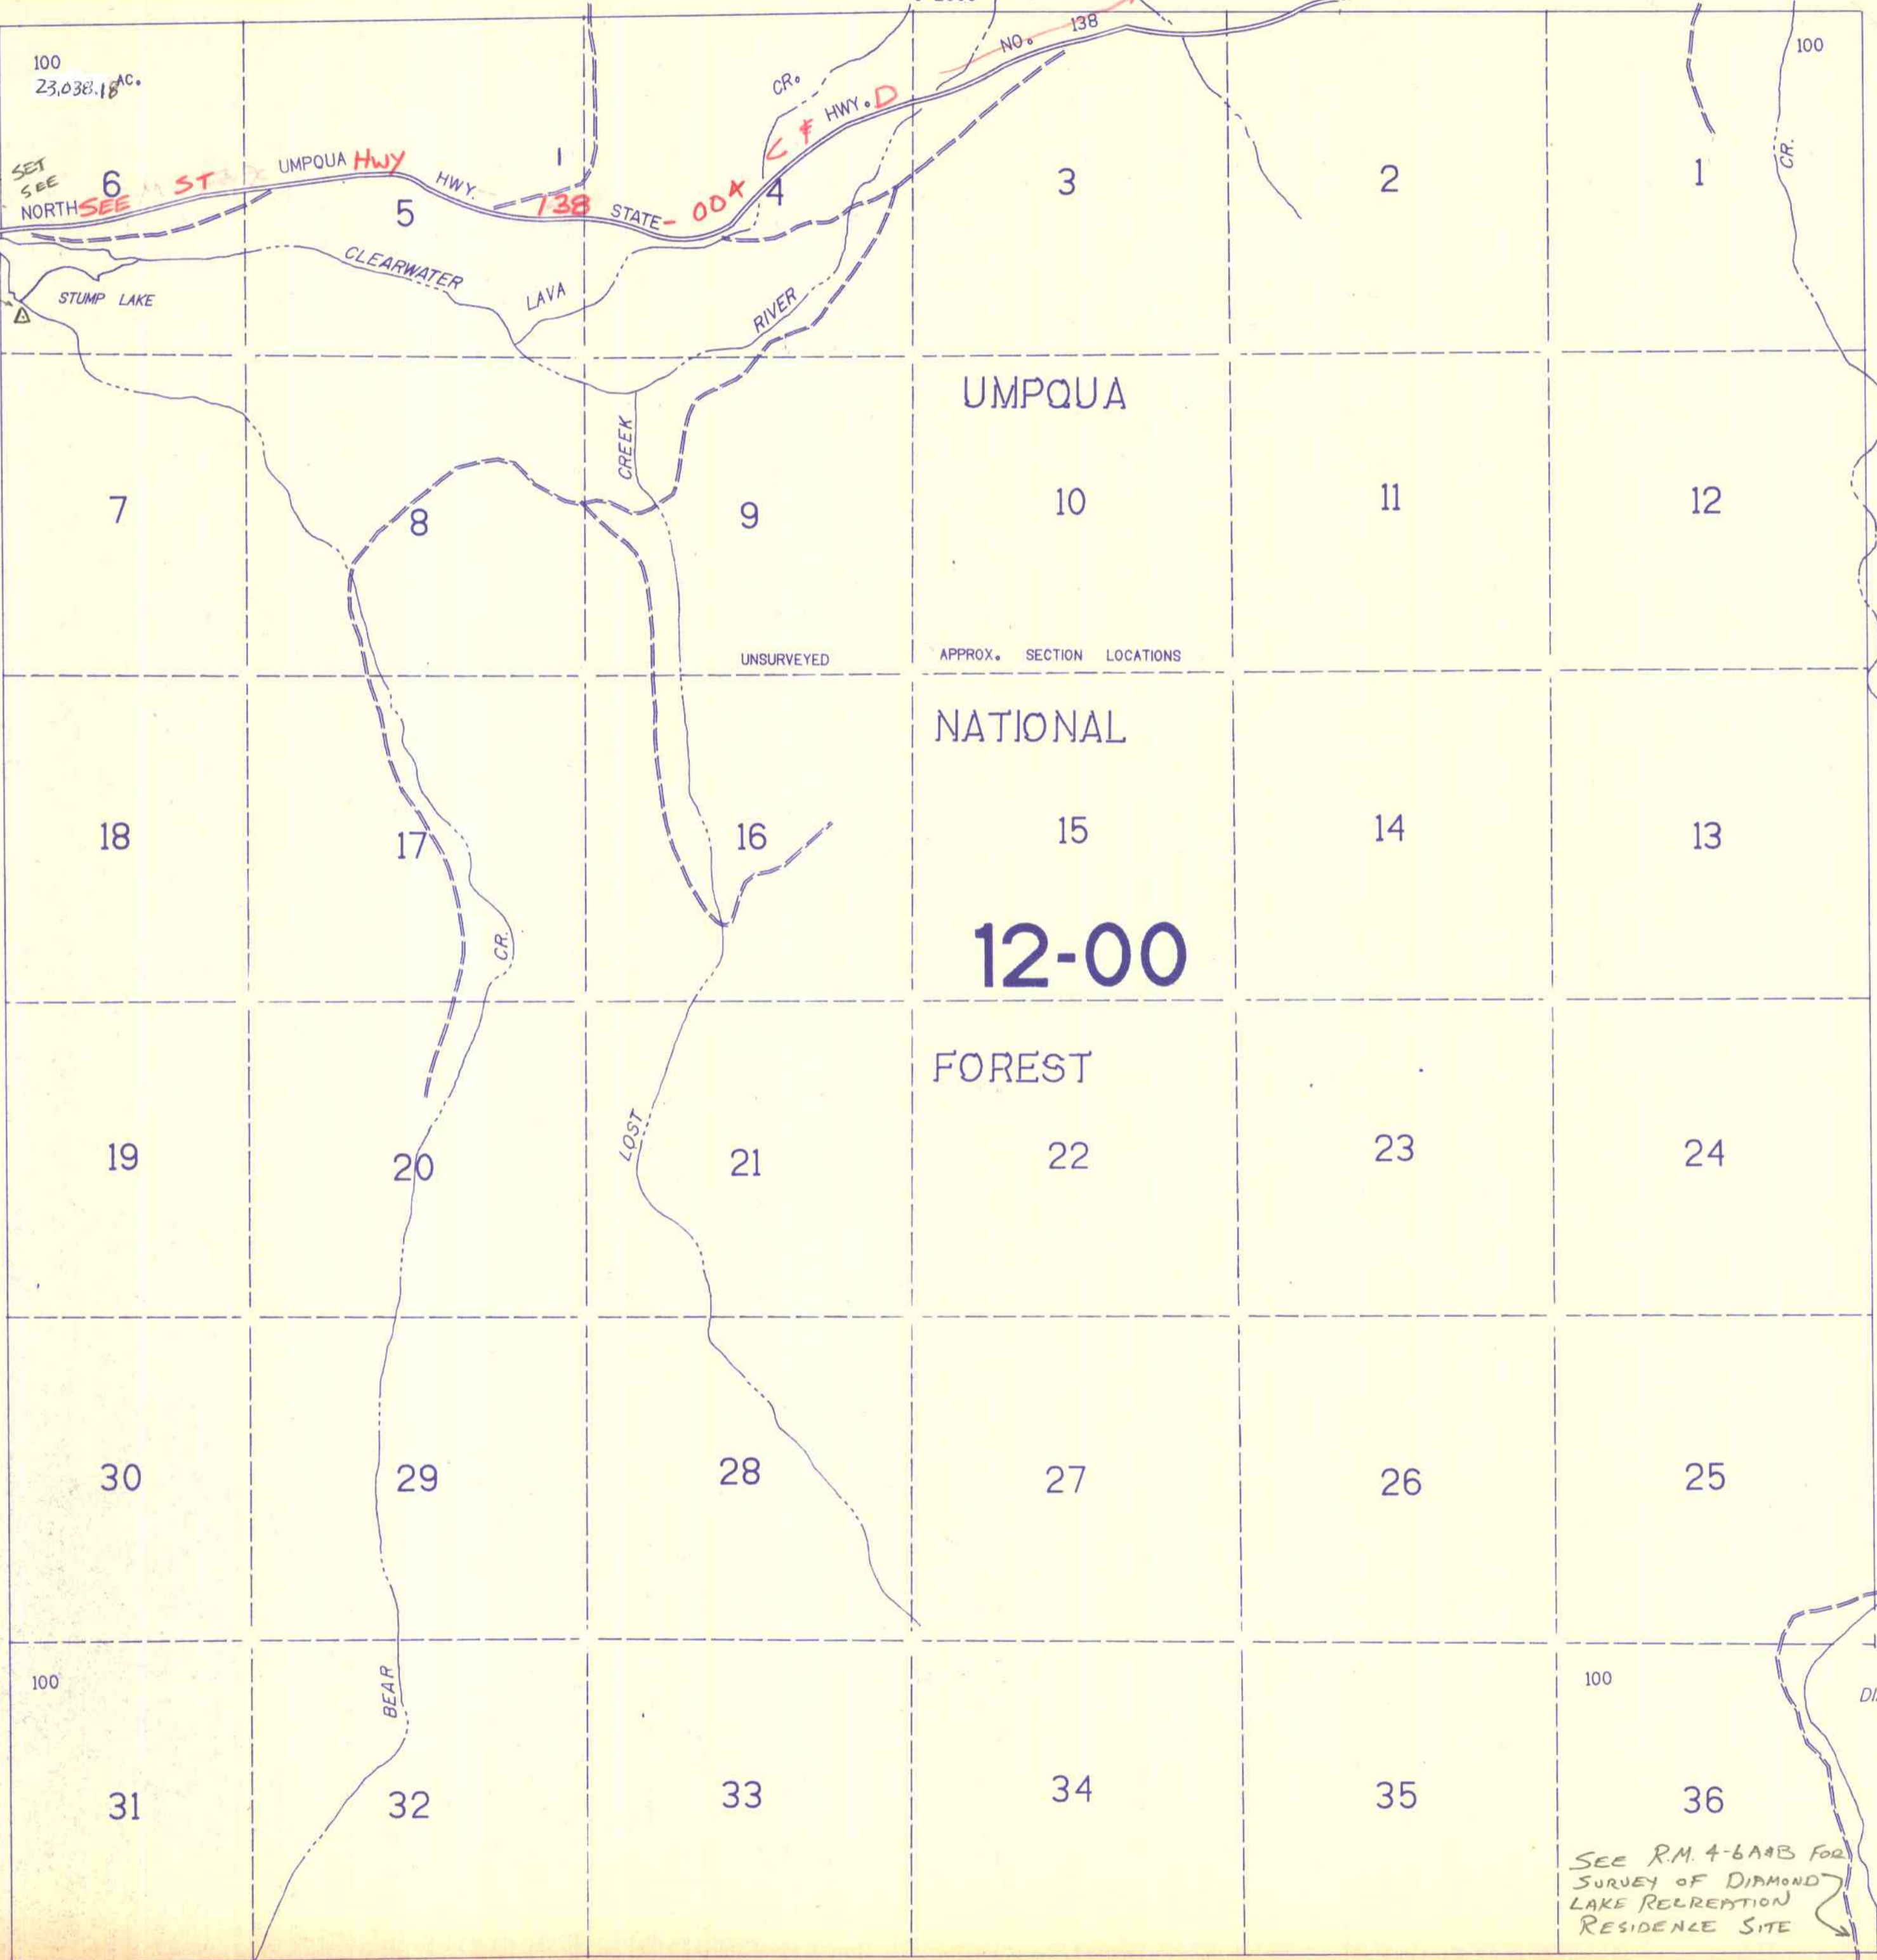

APPROX. LOCATION OF
CONTROL MONUMENT
M112-59 FOR
COORD.
CLEARWATER 1
DAM

SEE MAP 27 4E

SEE MAP 27 6E

SEE R.M. 4-6AAB FOR
SURVEY OF DIAMOND
LAKE RECREATION
RESIDENCE SITE

27 5E

SEE MAP 28 5E