

THIS MAP WAS PREPARED FOR
ASSESSMENT PURPOSE ONLY.

NW1/4 NW1/4 SEC.18 T.27S. R.5W. W.M.
SUPPLEMENTAL
DOUGLAS COUNTY
1" = 50'

REVISED ON
4-14-16


27 5 18BB
SUPPLEMENTAL
ROSEBURG

CANCELLED NO'S
60000 60021 60022
60023 60024 70000
70009 70010 70011
70012 70013 80000
80001 80002 80003
80004

SEE MAP 27 5 18BB

SEE MAP 27 5 18BB

SEE MAP 27 5 18BB

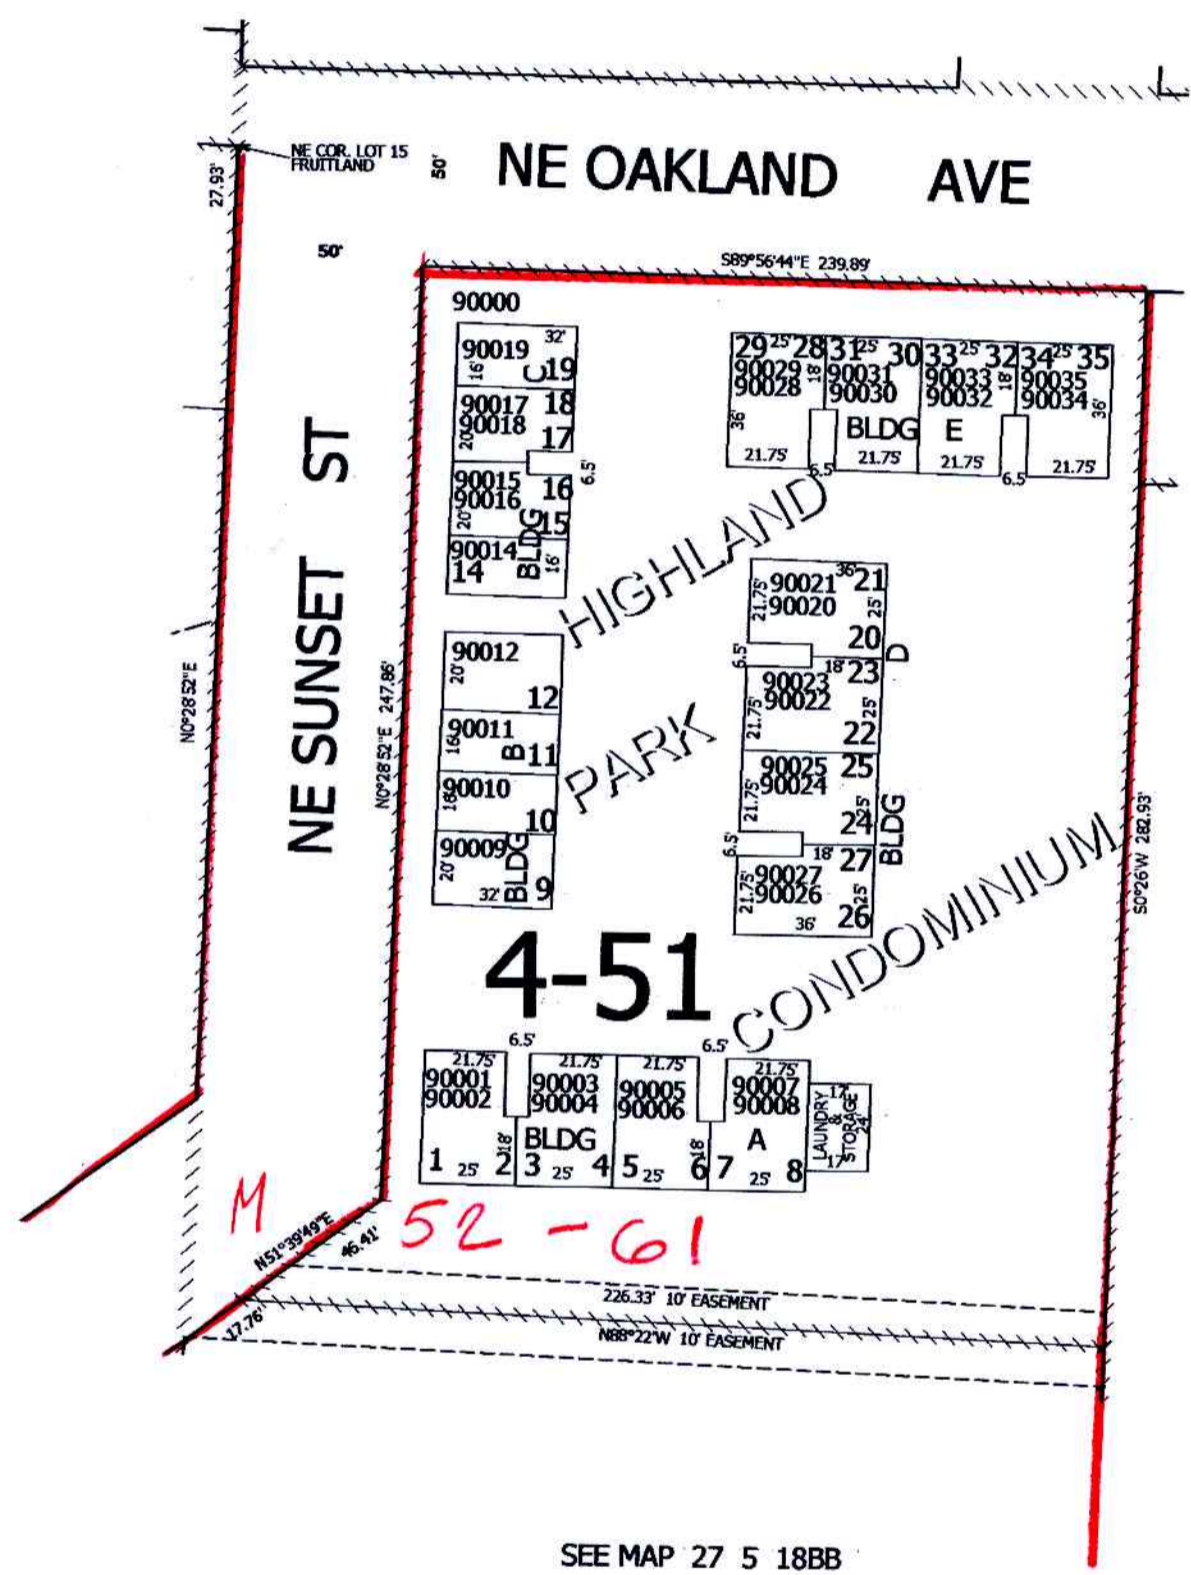

SEE MAP 27 5 18BB

11-26-19 881
xcv

27 5 18BB
SUPPLEMENTAL
ROSEBURG