

NW1/4NE1/4 SEC. 1 T.27S. R.6W. W.M.  
DOUGLAS COUNTY

27 6 1AB


1"=100'

THIS MAP WAS PREPARED FOR  
ASSESSMENT PURPOSE ONLY.

SEE MAP 26 6 36

1/4 COR.

APPROX. 1/16 COR.

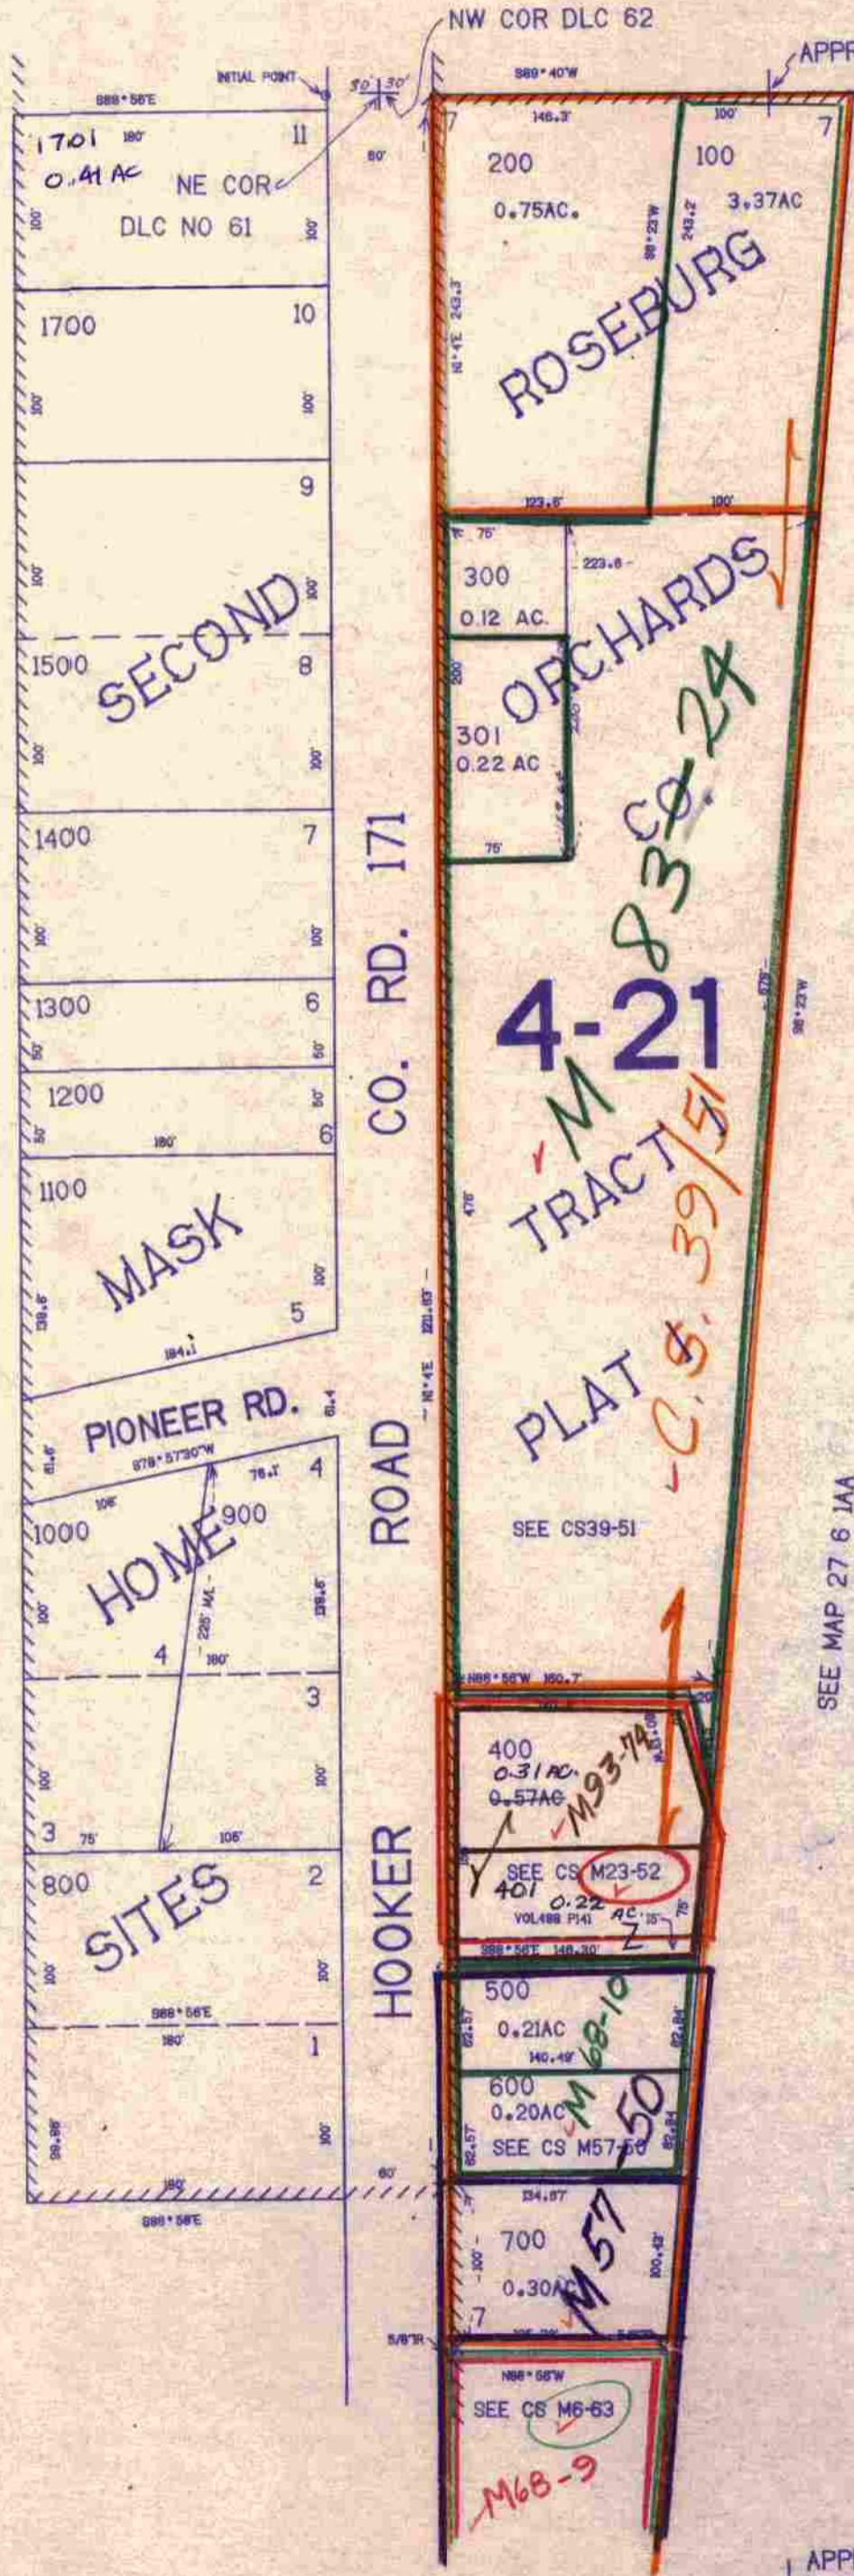

CANCELLED PARCEL NO'S  
1600  
1800

SEE MAP 27 6 1

SEE MAP 27 6 1AA

592.000

SEE MAP 27 6 1AC

APPROX. 1/16 COR.

APPROX. 1/16 COR.

27 6 1AB

1240.000

11/85  
2M0