


SW1/4 NW1/4 SEC. 15 T.27S. R.6W. W.M.  
DOUGLAS COUNTY

27 6 15BC

THIS MAP WAS PREPARED FOR  
ASSESSMENT PURPOSE ONLY.

1"=100'

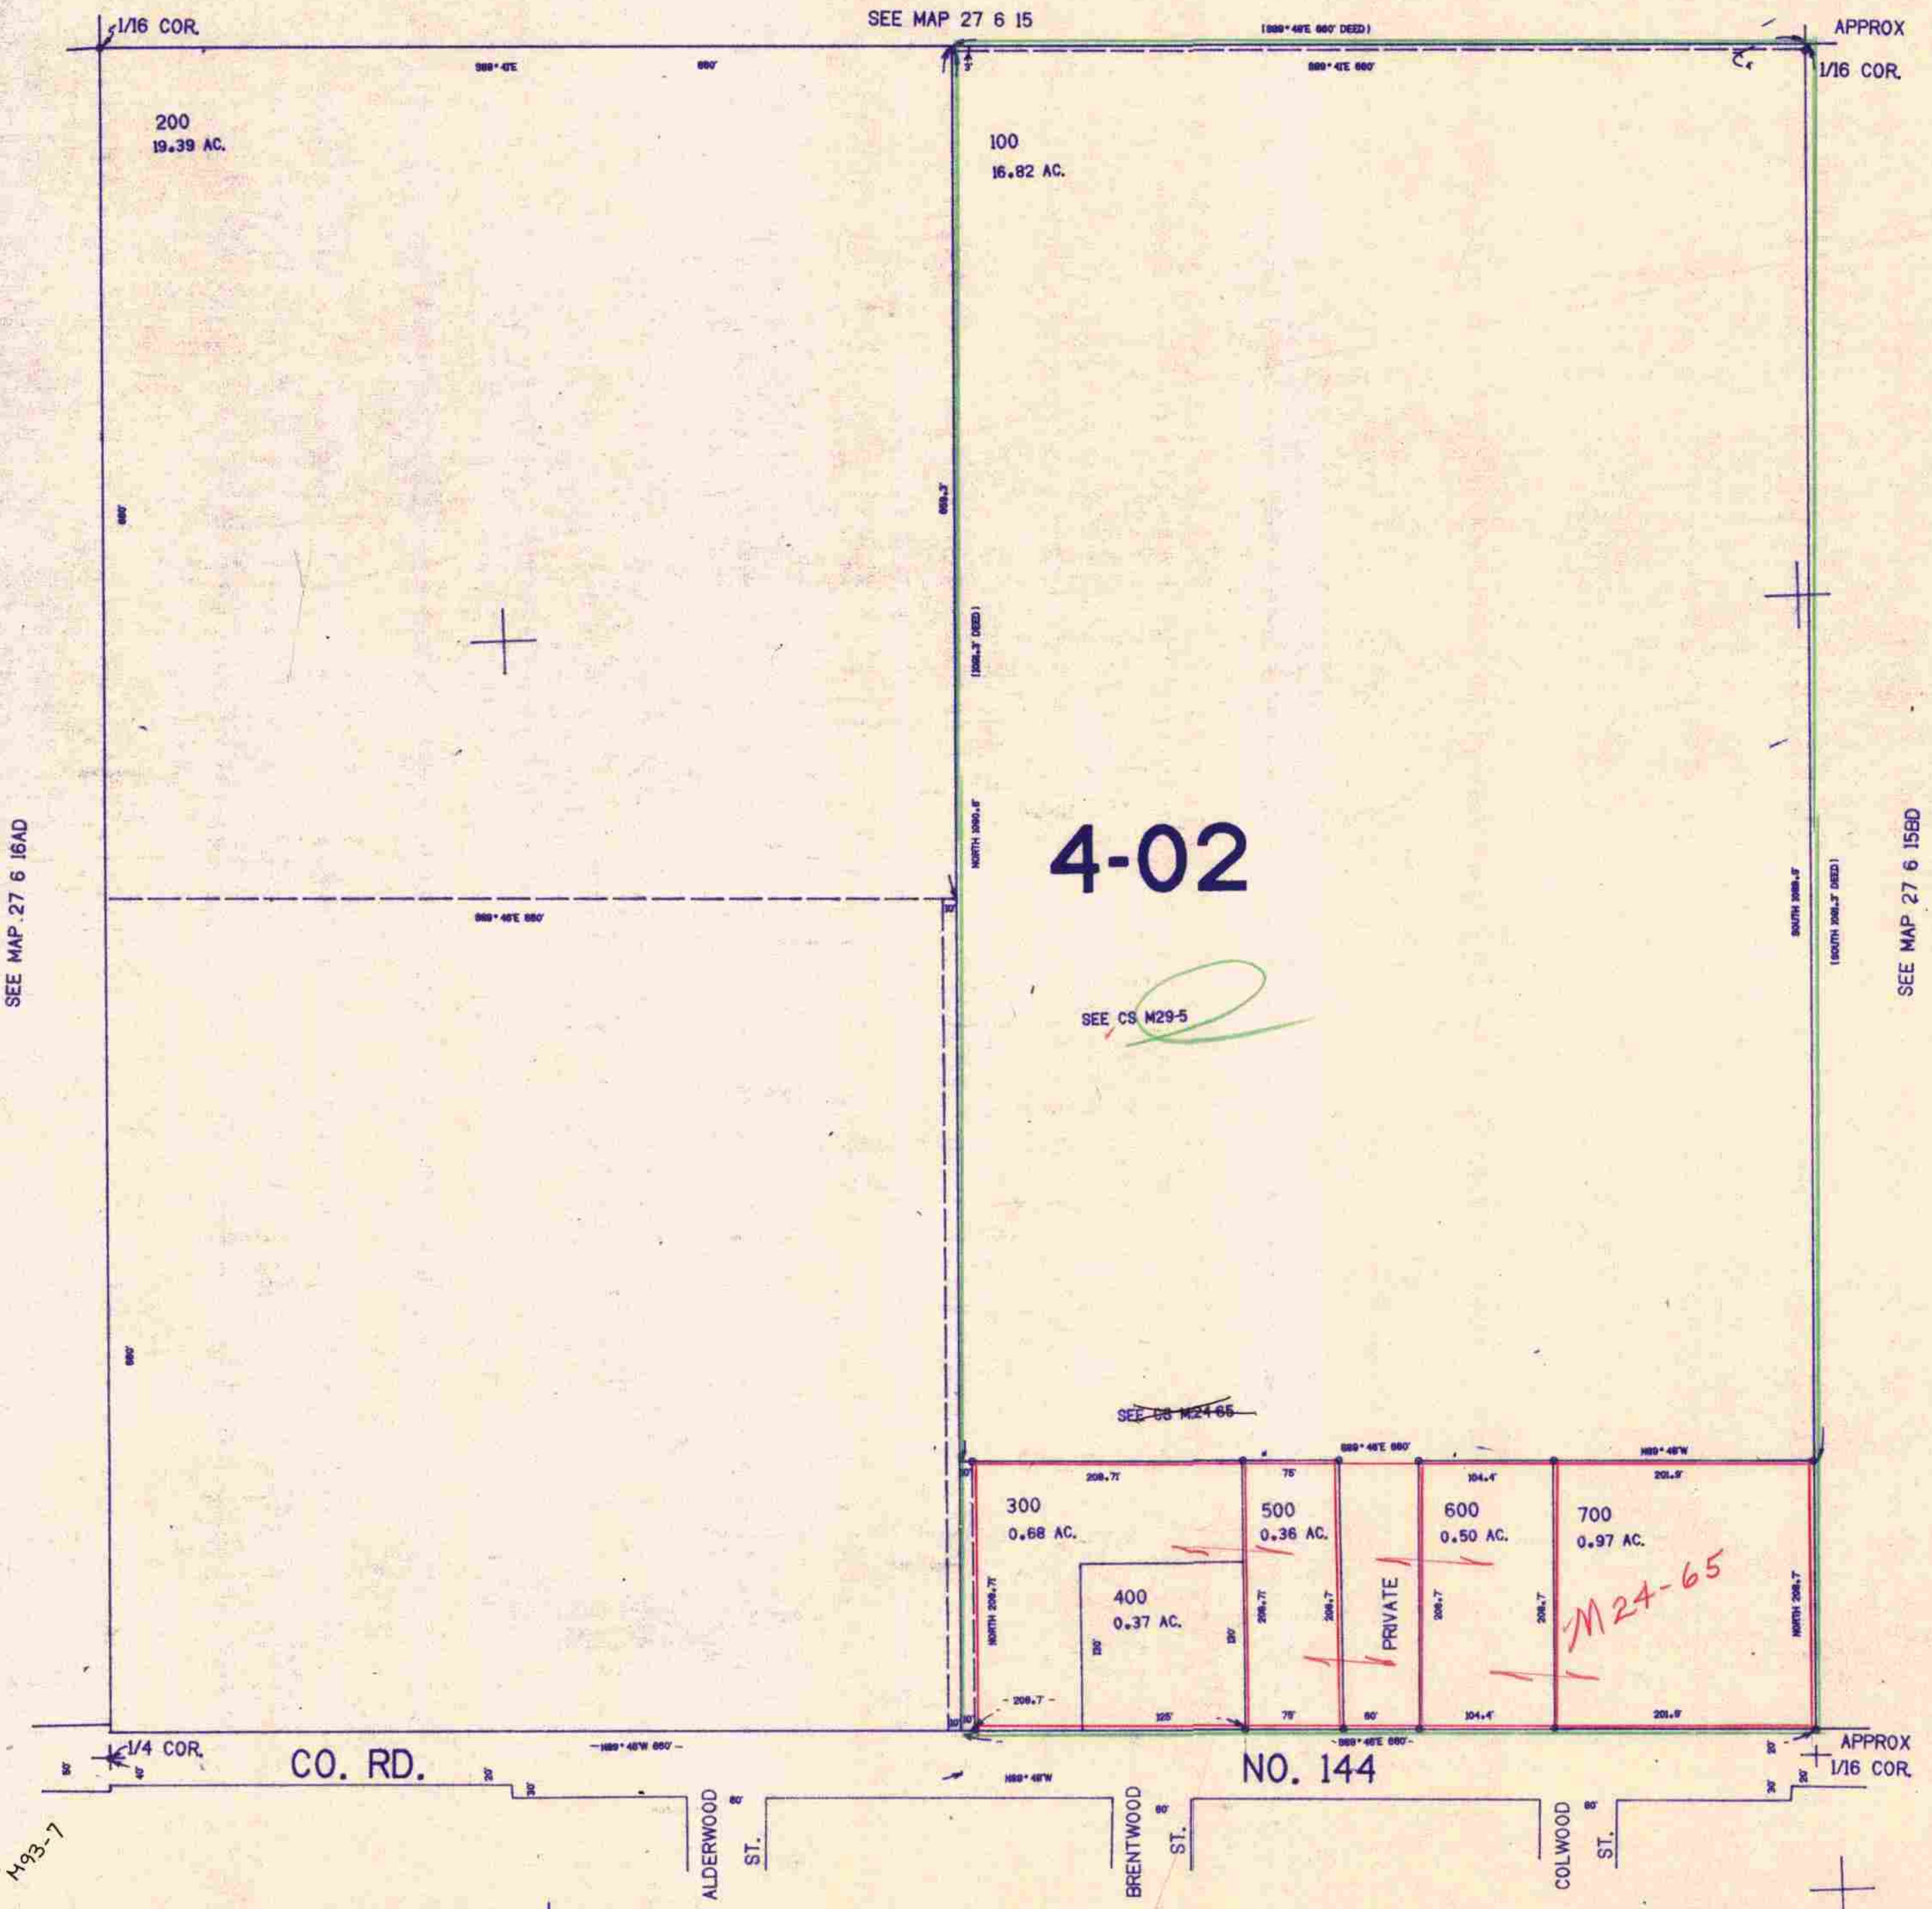

581.000

CONTROL LAYOUT CHECKED

SEE MAP 27 6 15CB

27 6 15BC

5/81

H93-7

1.226.000