

NE1/4 SW1/4 SEC. 15 T.27S. R.6W. W.M.  
DOUGLAS COUNTY

27 6 15CA

THIS MAP WAS PREPARED FOR  
ASSESSMENT PURPOSE ONLY.

1"=100'


SEE MAP 27 6 15BD

SEE MAP 27 6 15CB

SEE MAP 27 6 15

SEE MAP 27 6 15DB

SEE MAP 27 6 15CD

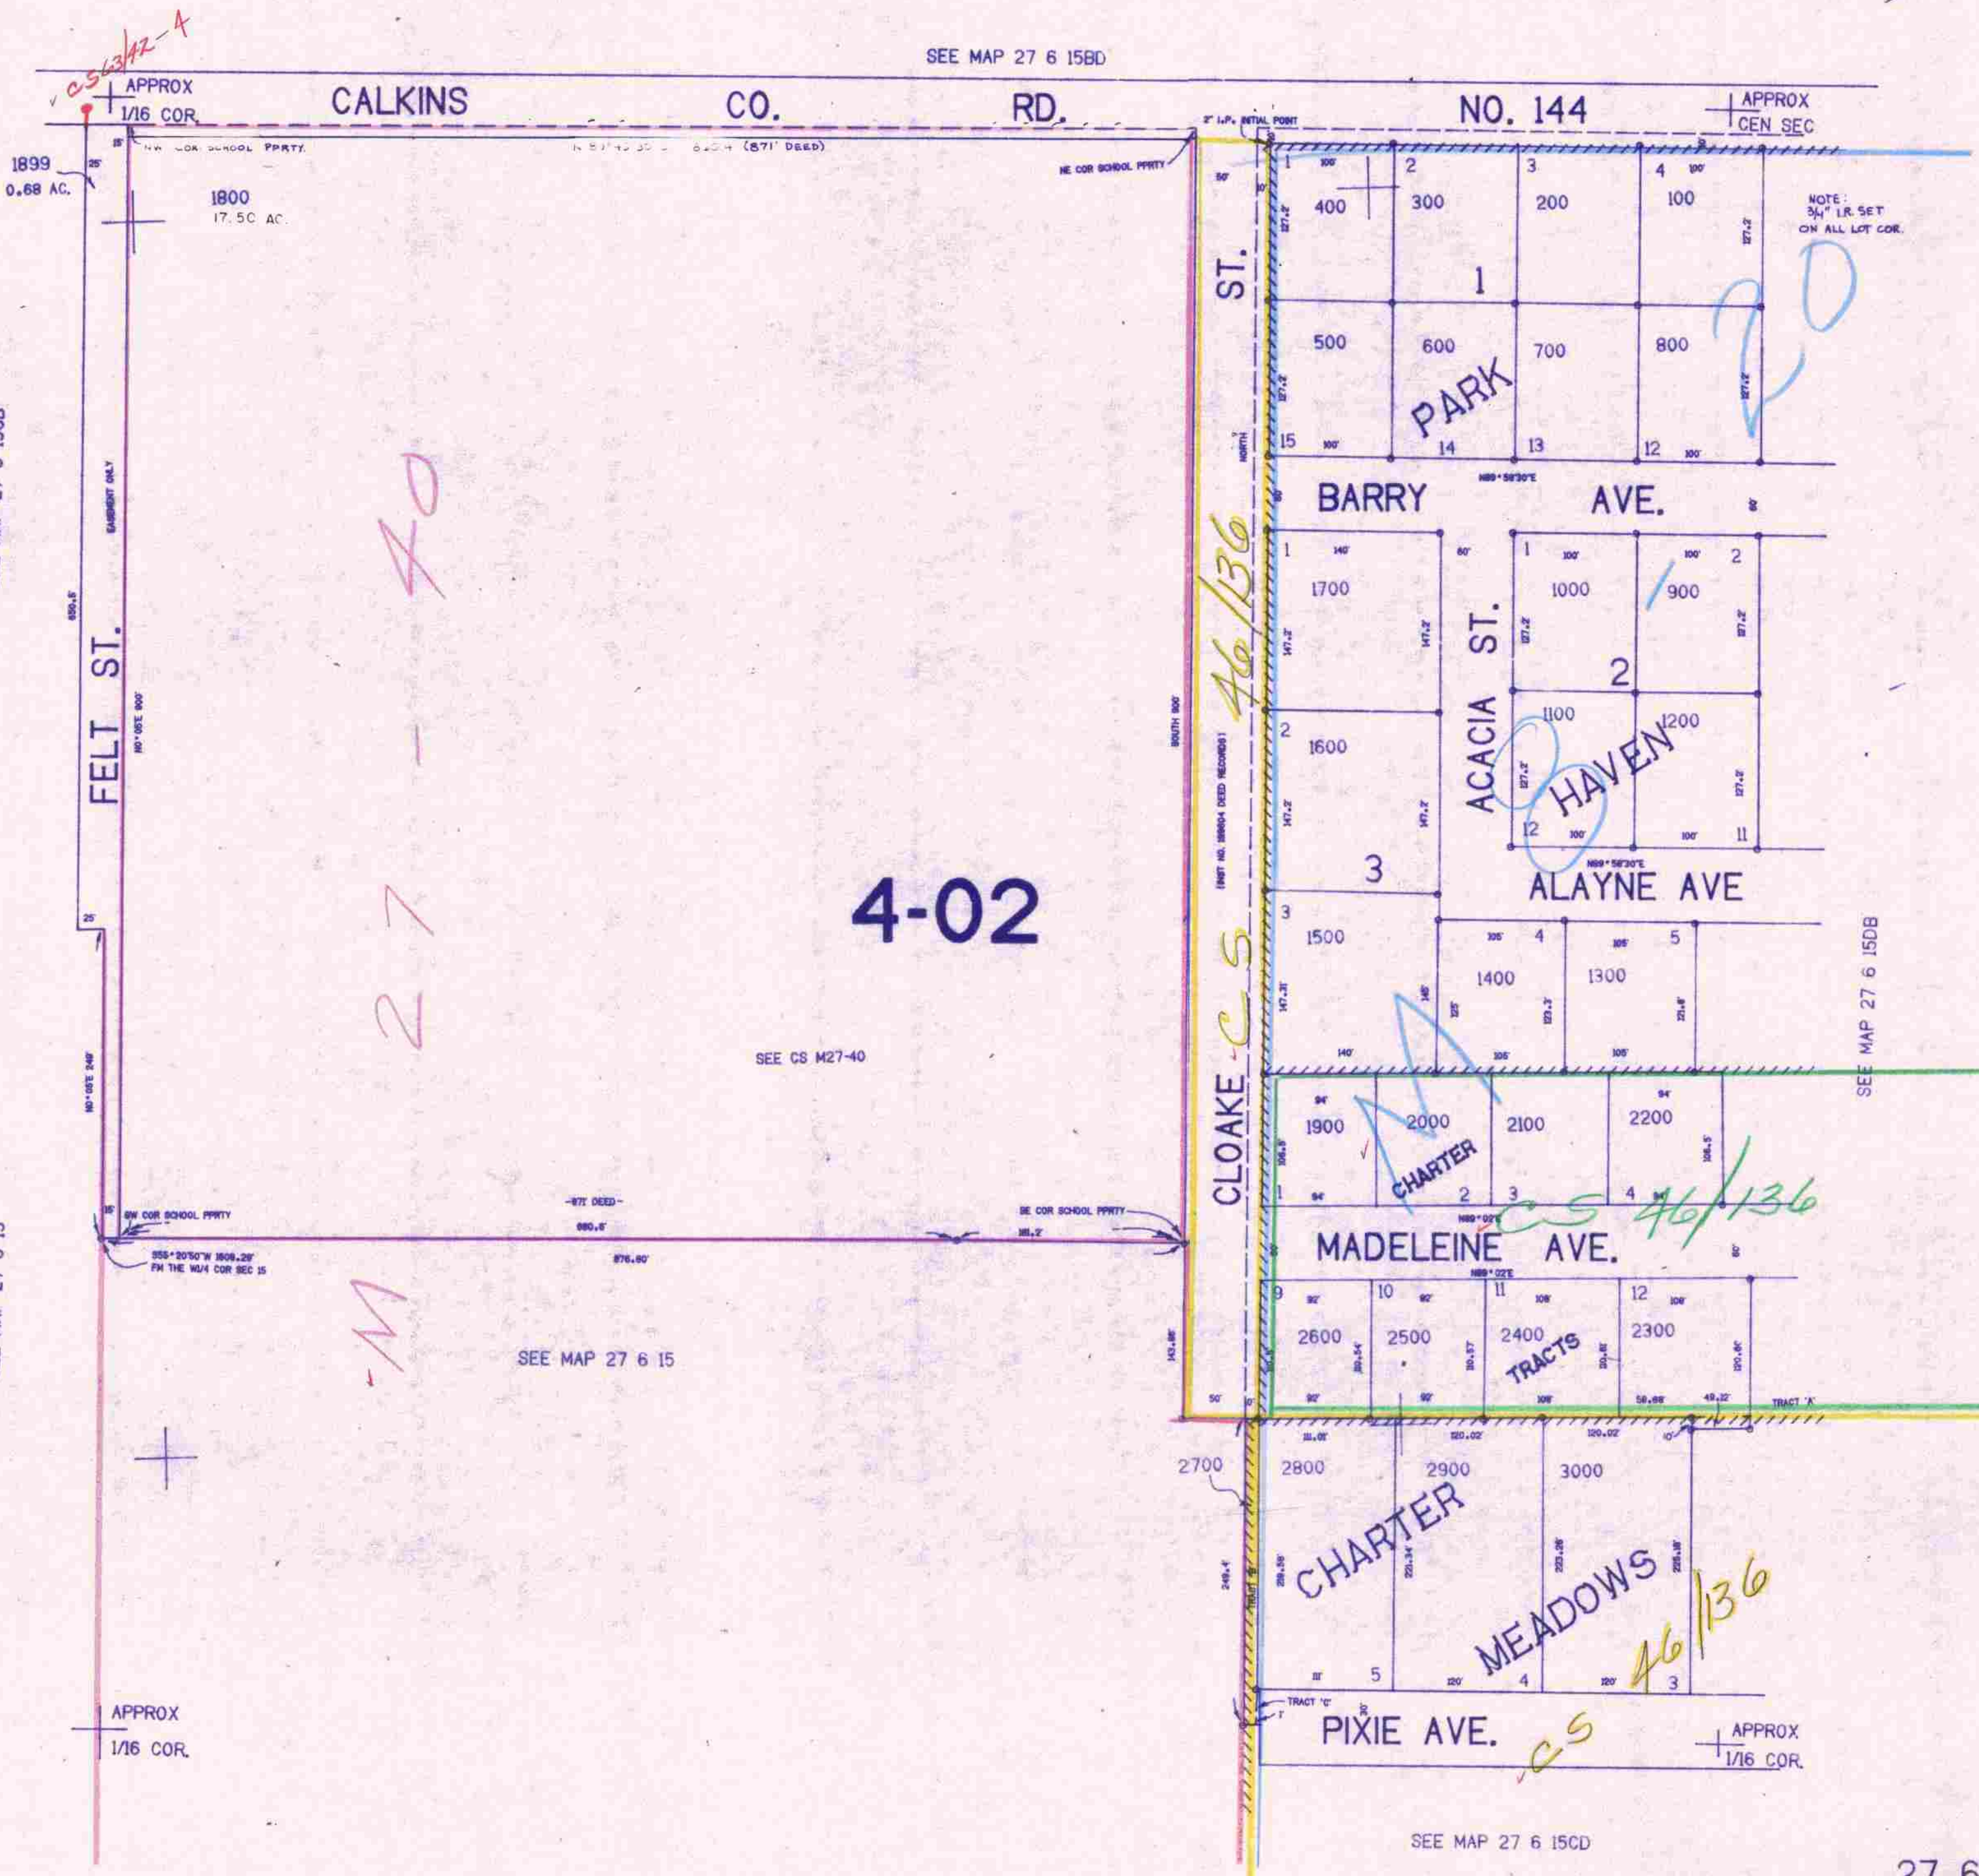

CALKINS CO. RD.

NO. 144

1899  
0.68 AC.

1800  
17.50 AC.

FELT ST.

ST.

BARRY AVE.

AVE.

4-02

CLOAKE ST.

ACACIA ST.

ALAYNE AVE.

MADELEINE AVE.

PIXIE AVE.

NOTE:  
34" I.R. SET  
ON ALL LOT COR.

SEE CS M27-40

SEE MAP 27 6 15

579000

228,000

27 6 15CA

CHECKED  
LAYOUT  
CONTROL