


THIS MAP WAS PREPARED FOR ASSESSMENT PURPOSE ONLY.

SEC.16 T.27S. R.6W. W.M. DOUGLAS COUNTY

REVISED ON 6-2-05

27 6 16 & INDEX

1" = 400'

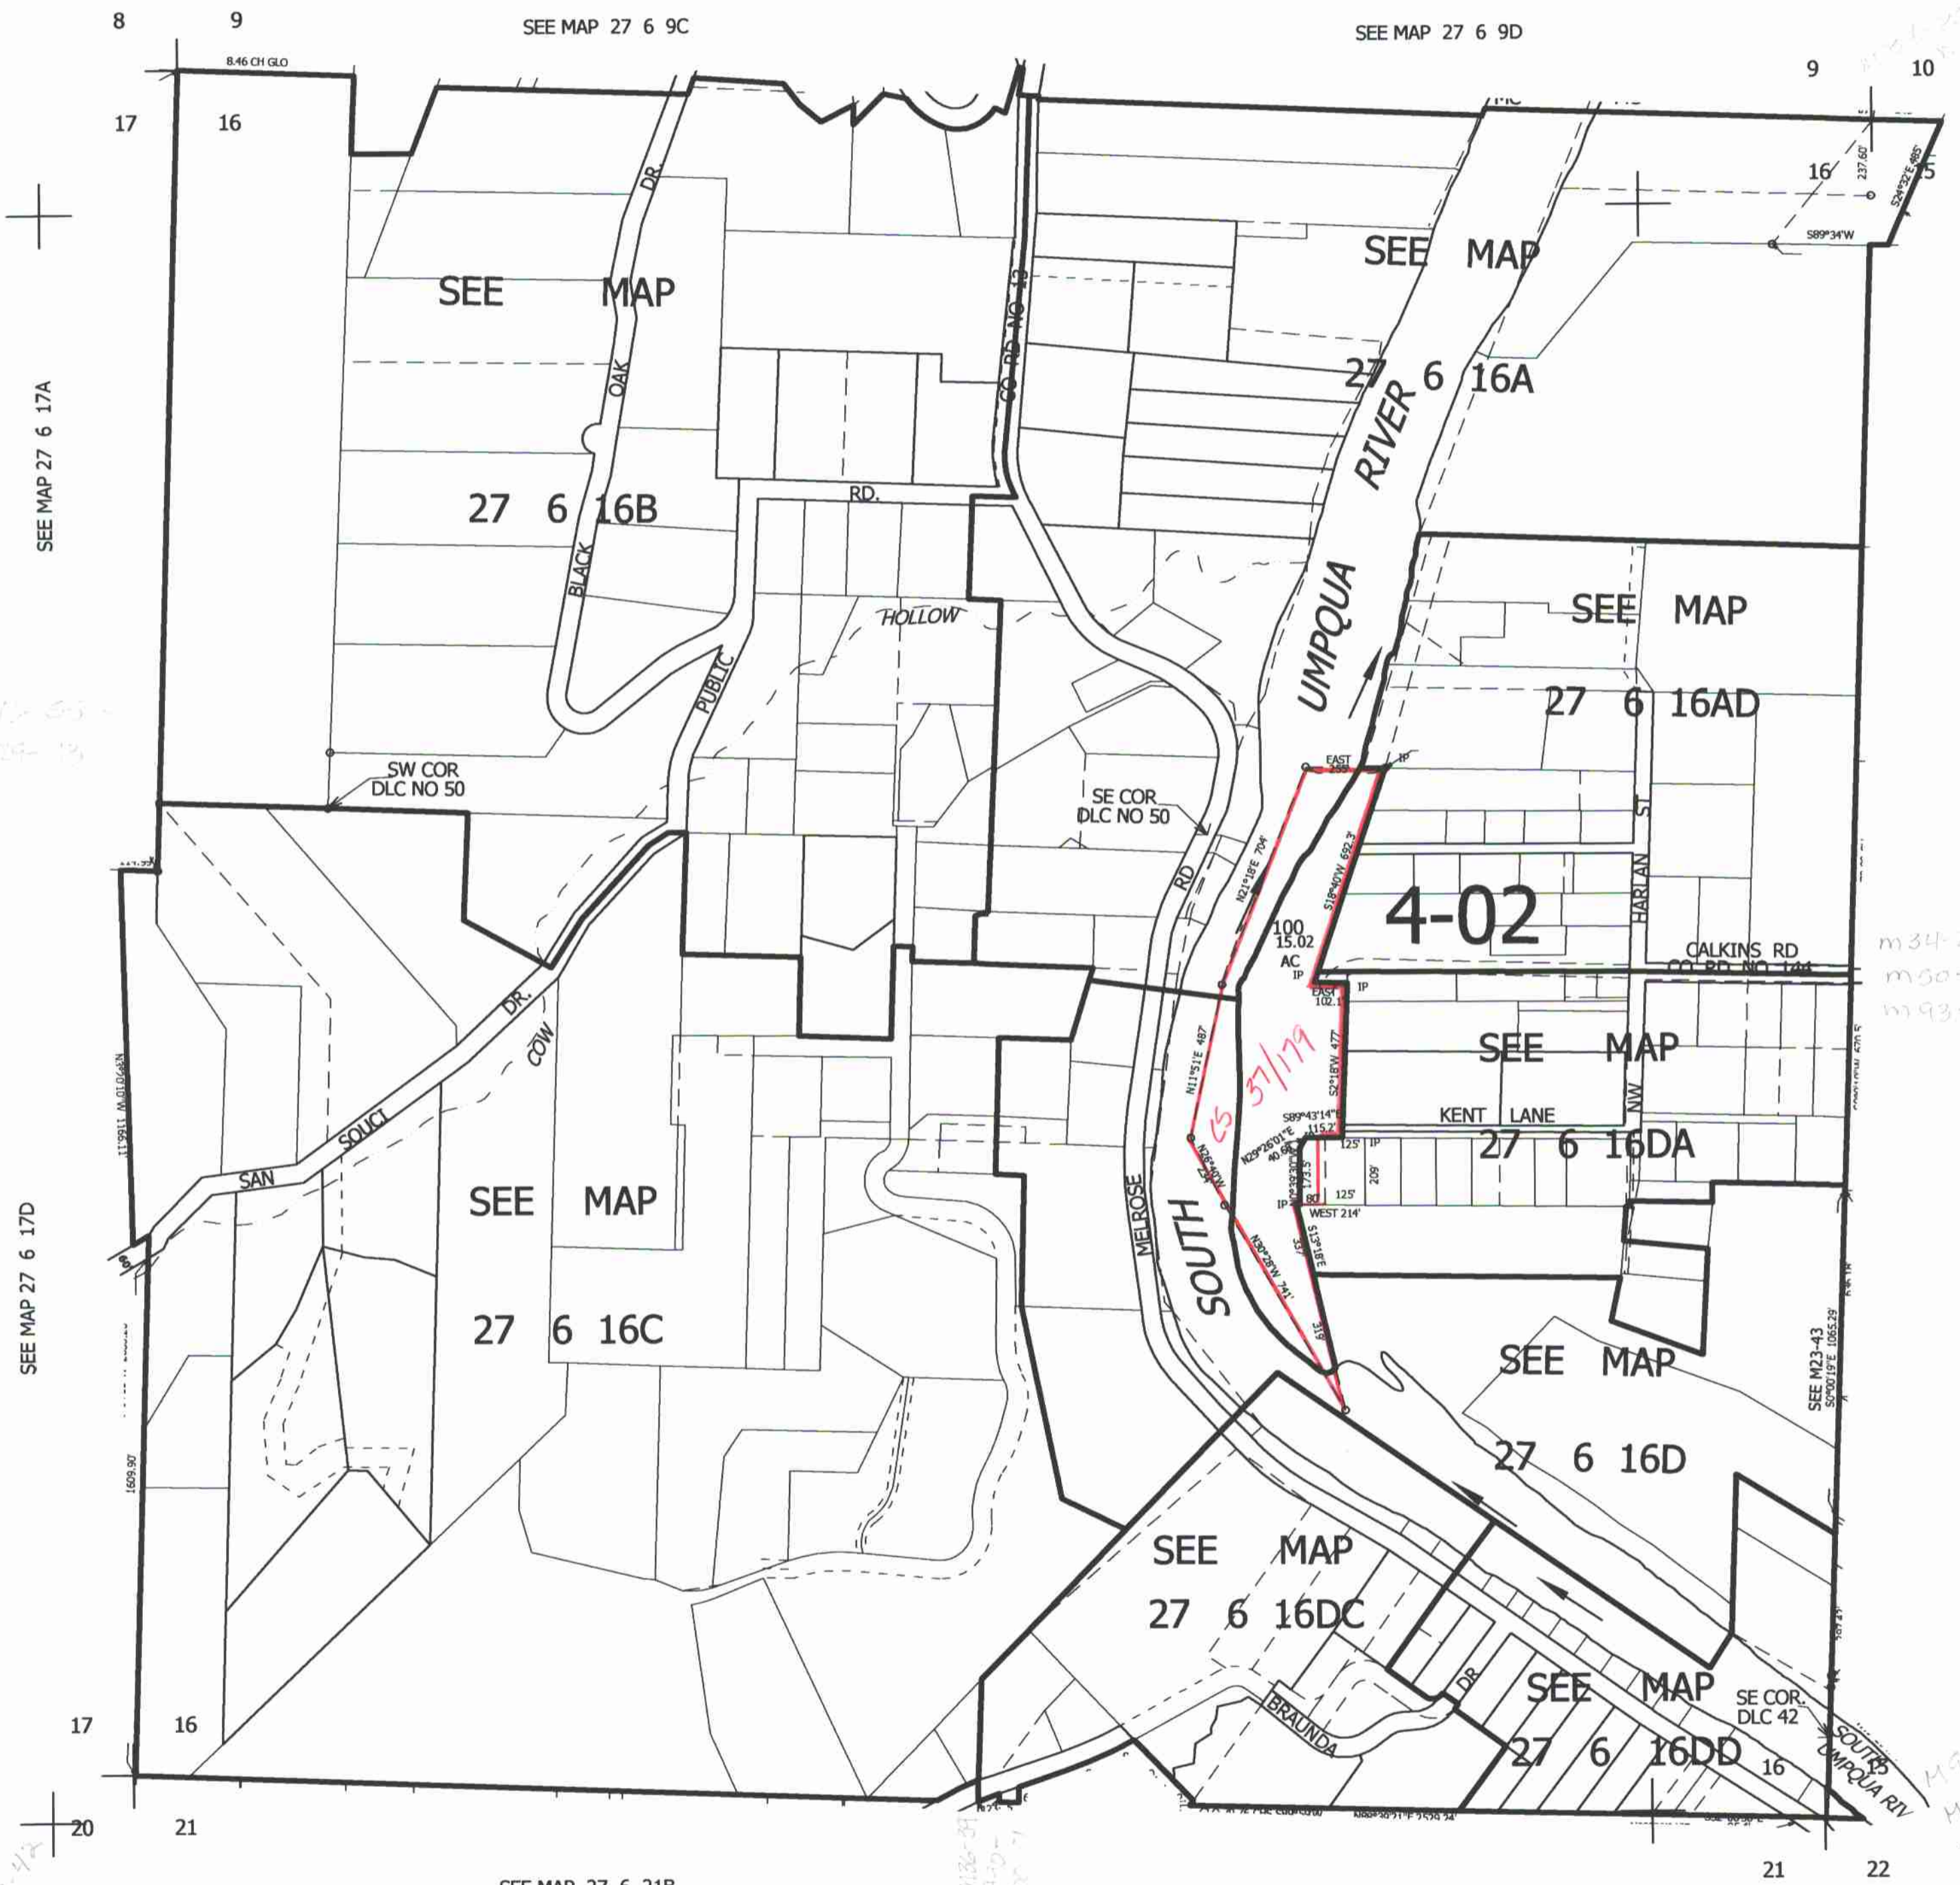

CANCELLED NO'S 101

SEE MAP 27 6 15

SEE MAP 27 6 15BC

SEE MAP 27 6 15CB

SEE MAP 27 6 15

m34-28
m50-14
m93-7

M99-23
M108-22
1995-2017

577,500

27 6 16 & INDEX

SEE MAP 27 6 17A

SEE MAP 27 6 17D

SEE MAP 27 6 9C

SEE MAP 27 6 9D

SEE MAP 27 6 21B

SEE MAP 27 6 21

4,146,000