


SECTION 19 T.27S. R.7W. W.M.  
DOUGLAS COUNTY

27 7 19

THIS MAP WAS PREPARED FOR  
ASSESSMENT PURPOSE ONLY.

1"=400'

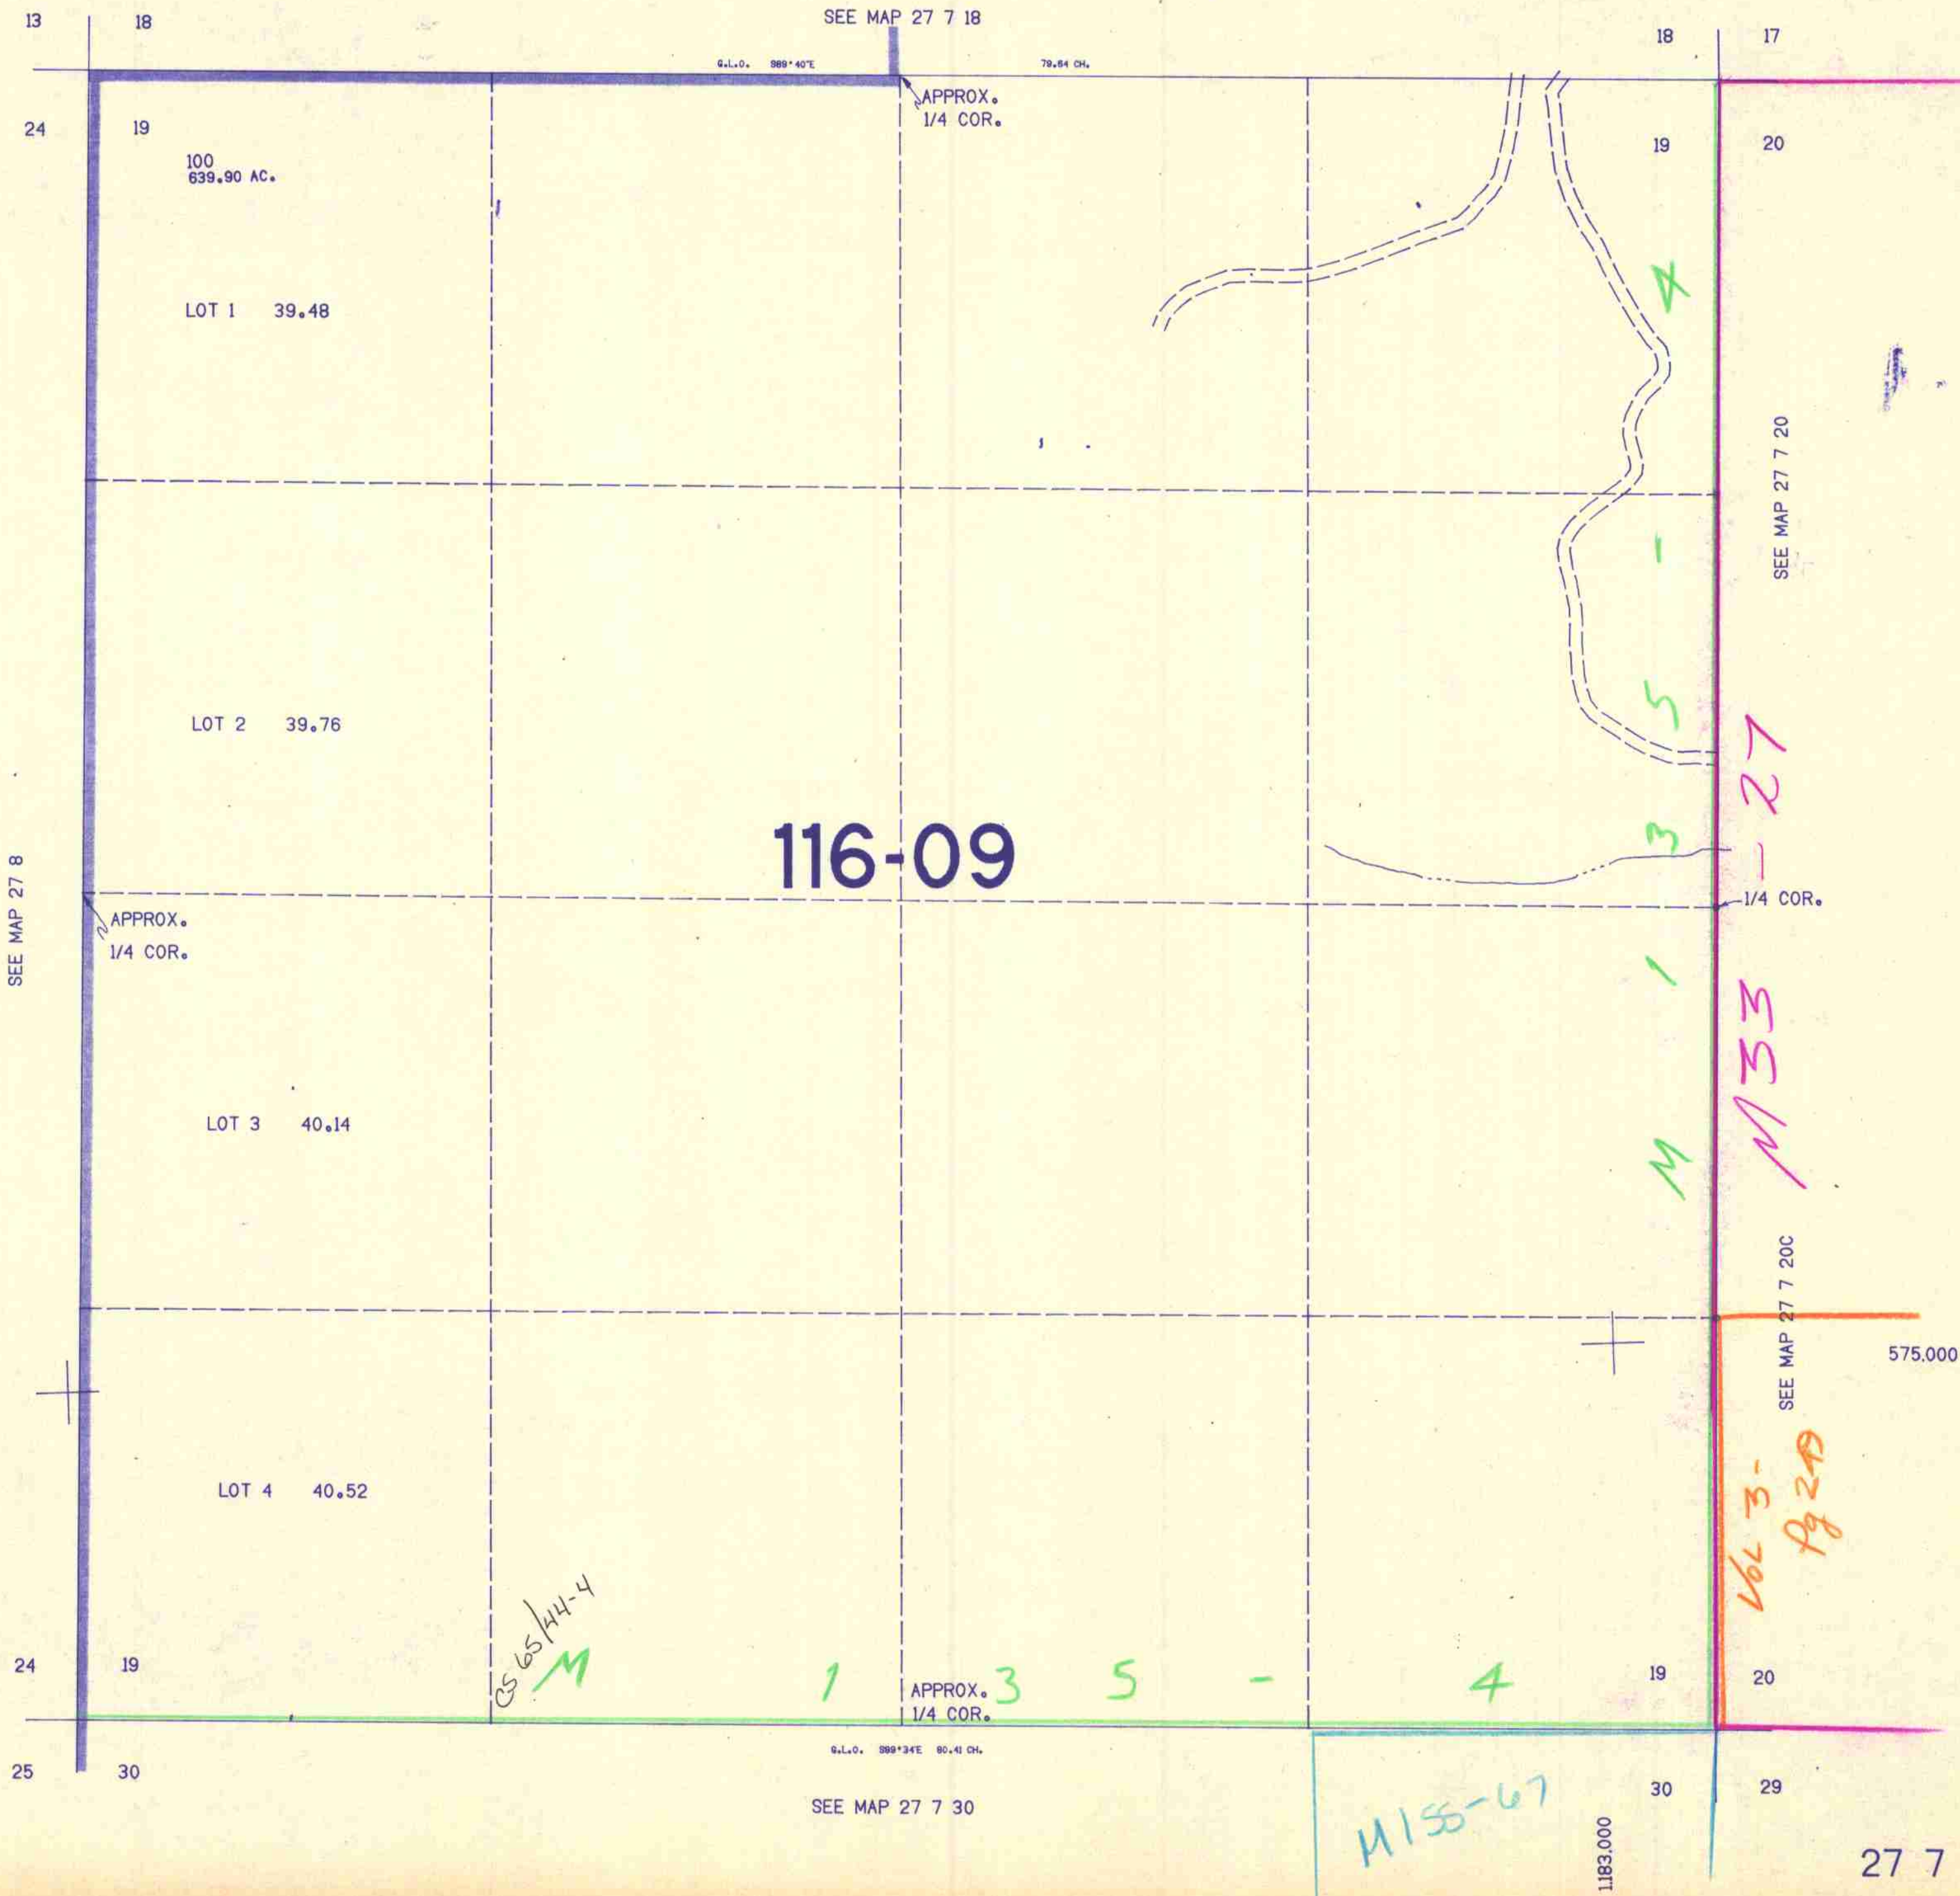

CONTROL — LAYOUT — TRACED — CHECKED

27 7 19

6/85