
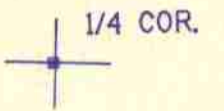


NW1/4 SEC. 25 T.27S. R.7W. W.M.  
DOUGLAS COUNTY


27 7 25B

THIS MAP WAS PREPARED FOR  
ASSESSMENT PURPOSE ONLY.

1"=200'

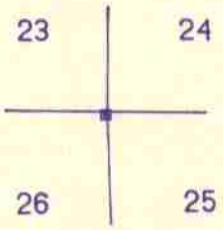

SEE MAP 27 7 25

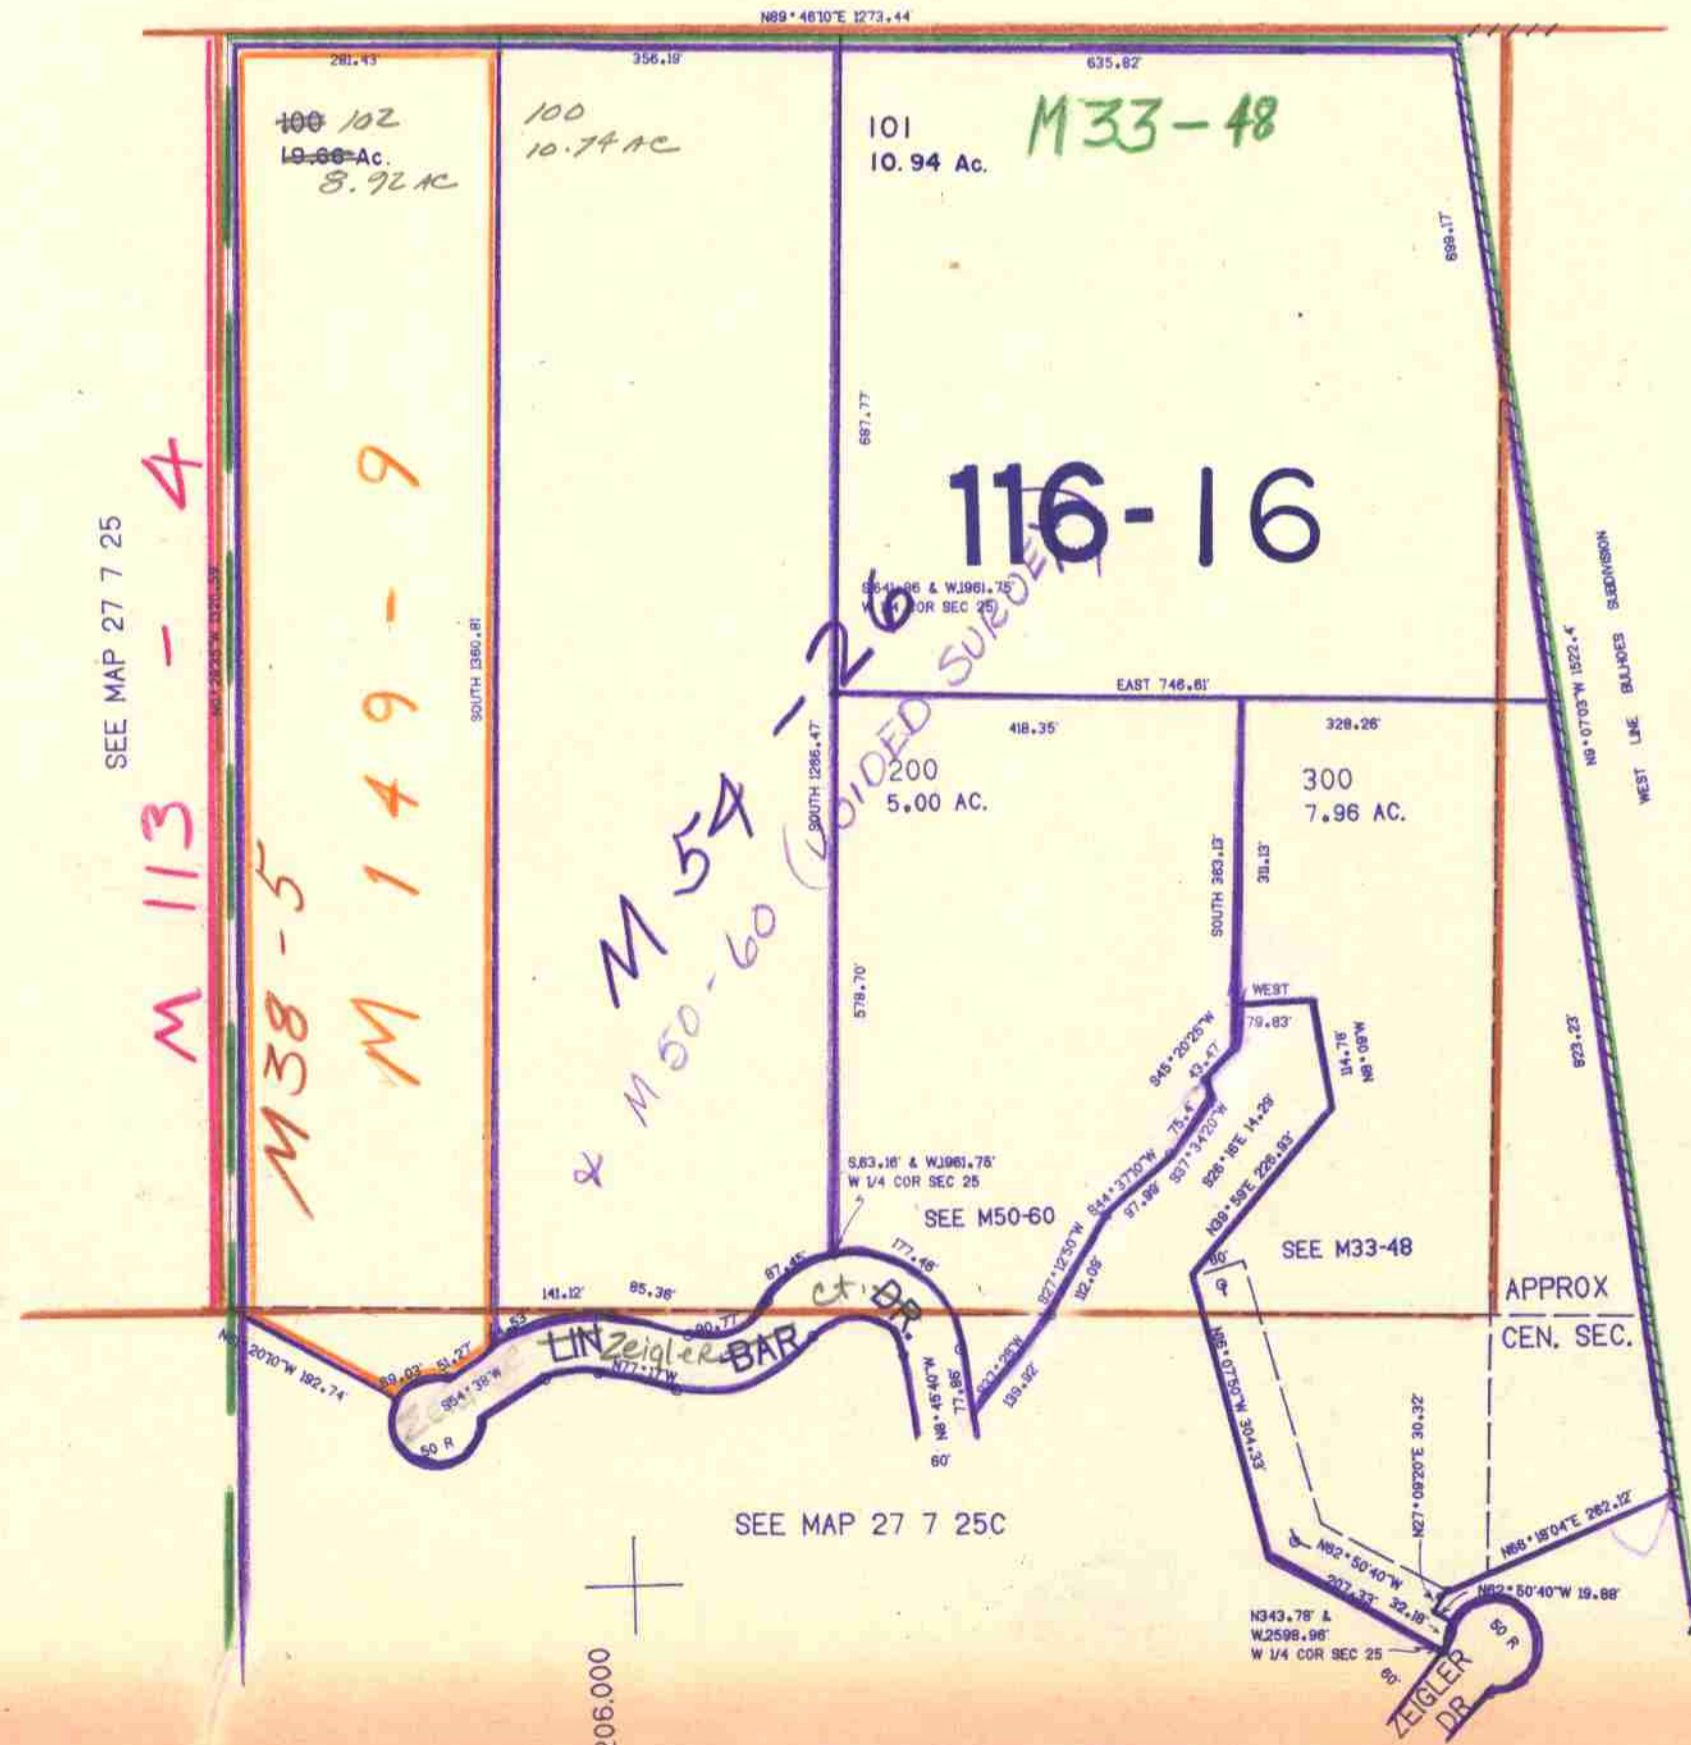

SEE MAP 27 7 25A

SEE MAP 27 7 25C

27 7 25B

CONTROL LAYOUT TRACED CHECKED

6/85  
cm