


T.28S. R.5 1/2 & 6E. W.W.
DOUGLAS COUNTY

THIS MAP WAS PREPARED FOR
ASSESSMENT PURPOSE ONLY.

1"=2000'

SEE MAP 27 6E

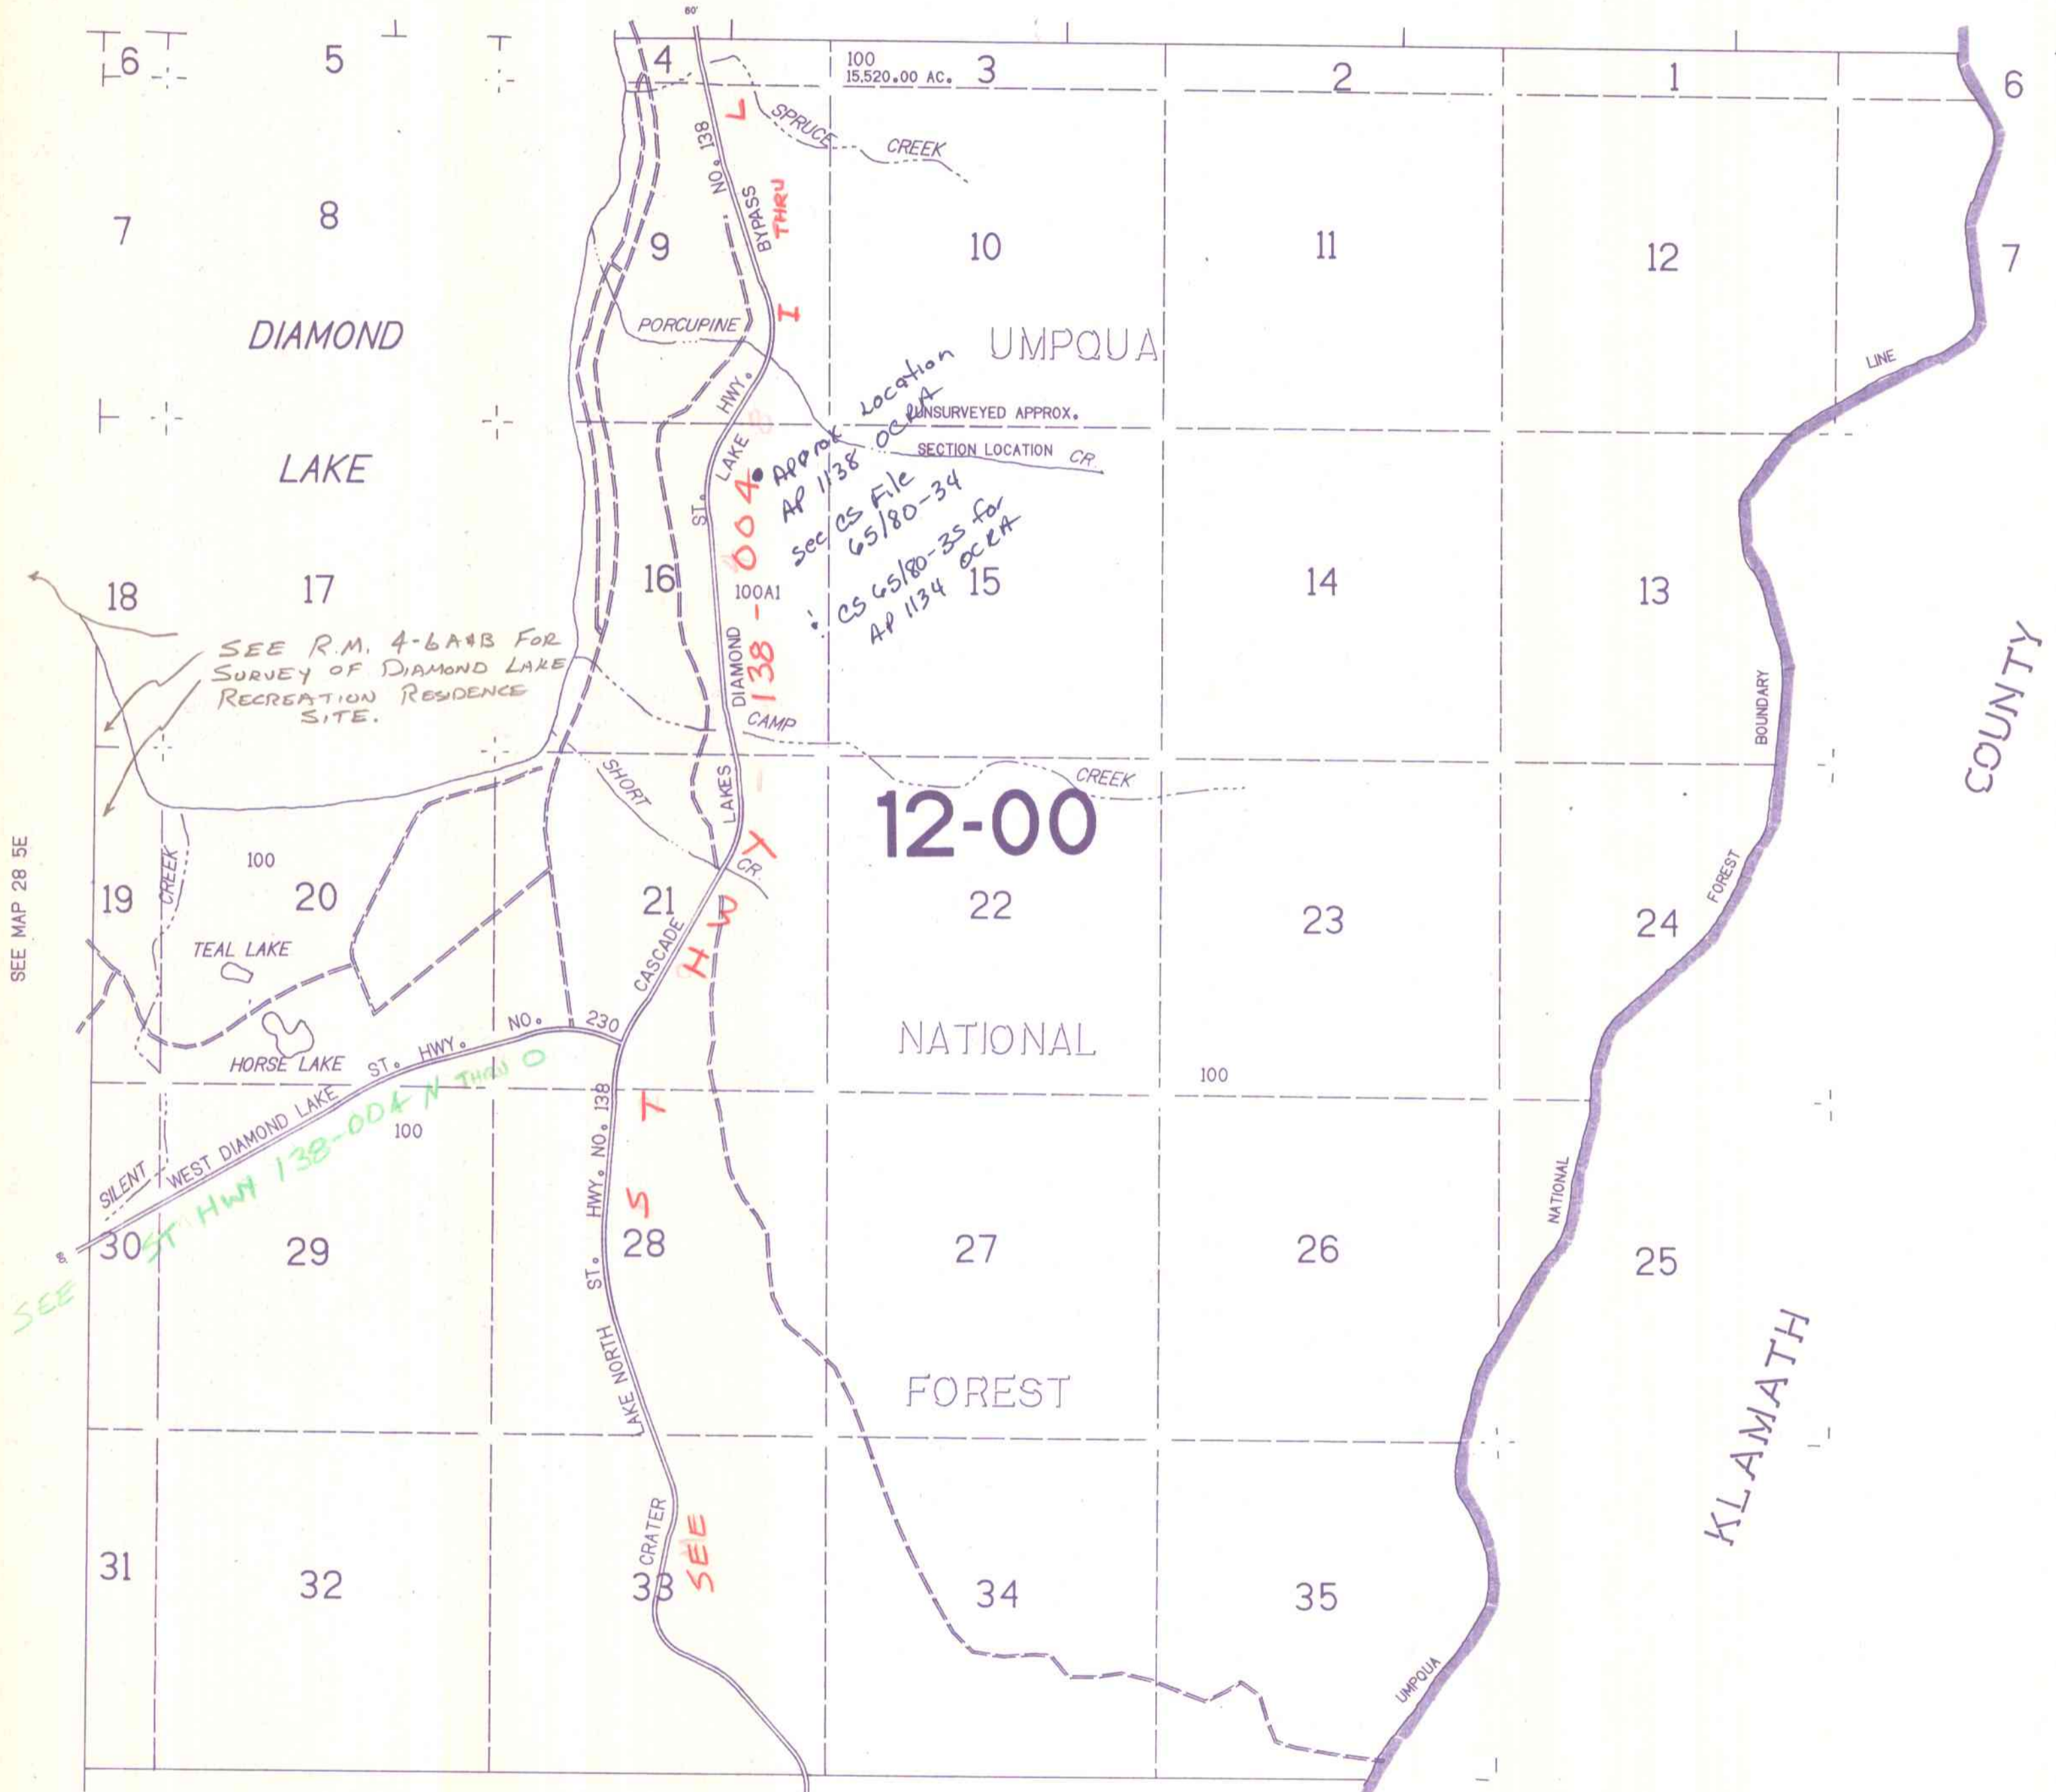

SEE MAP 29 6E
5 1/2 E