


THIS MAP WAS PREPARED FOR
ASSESSMENT PURPOSE ONLY
AVAILABLE FROM DCGIS

SECTION 24 T28S R5W WM
DOUGLAS COUNTY

28 5 24

REVISED ON
7/09/92

1" = 400'

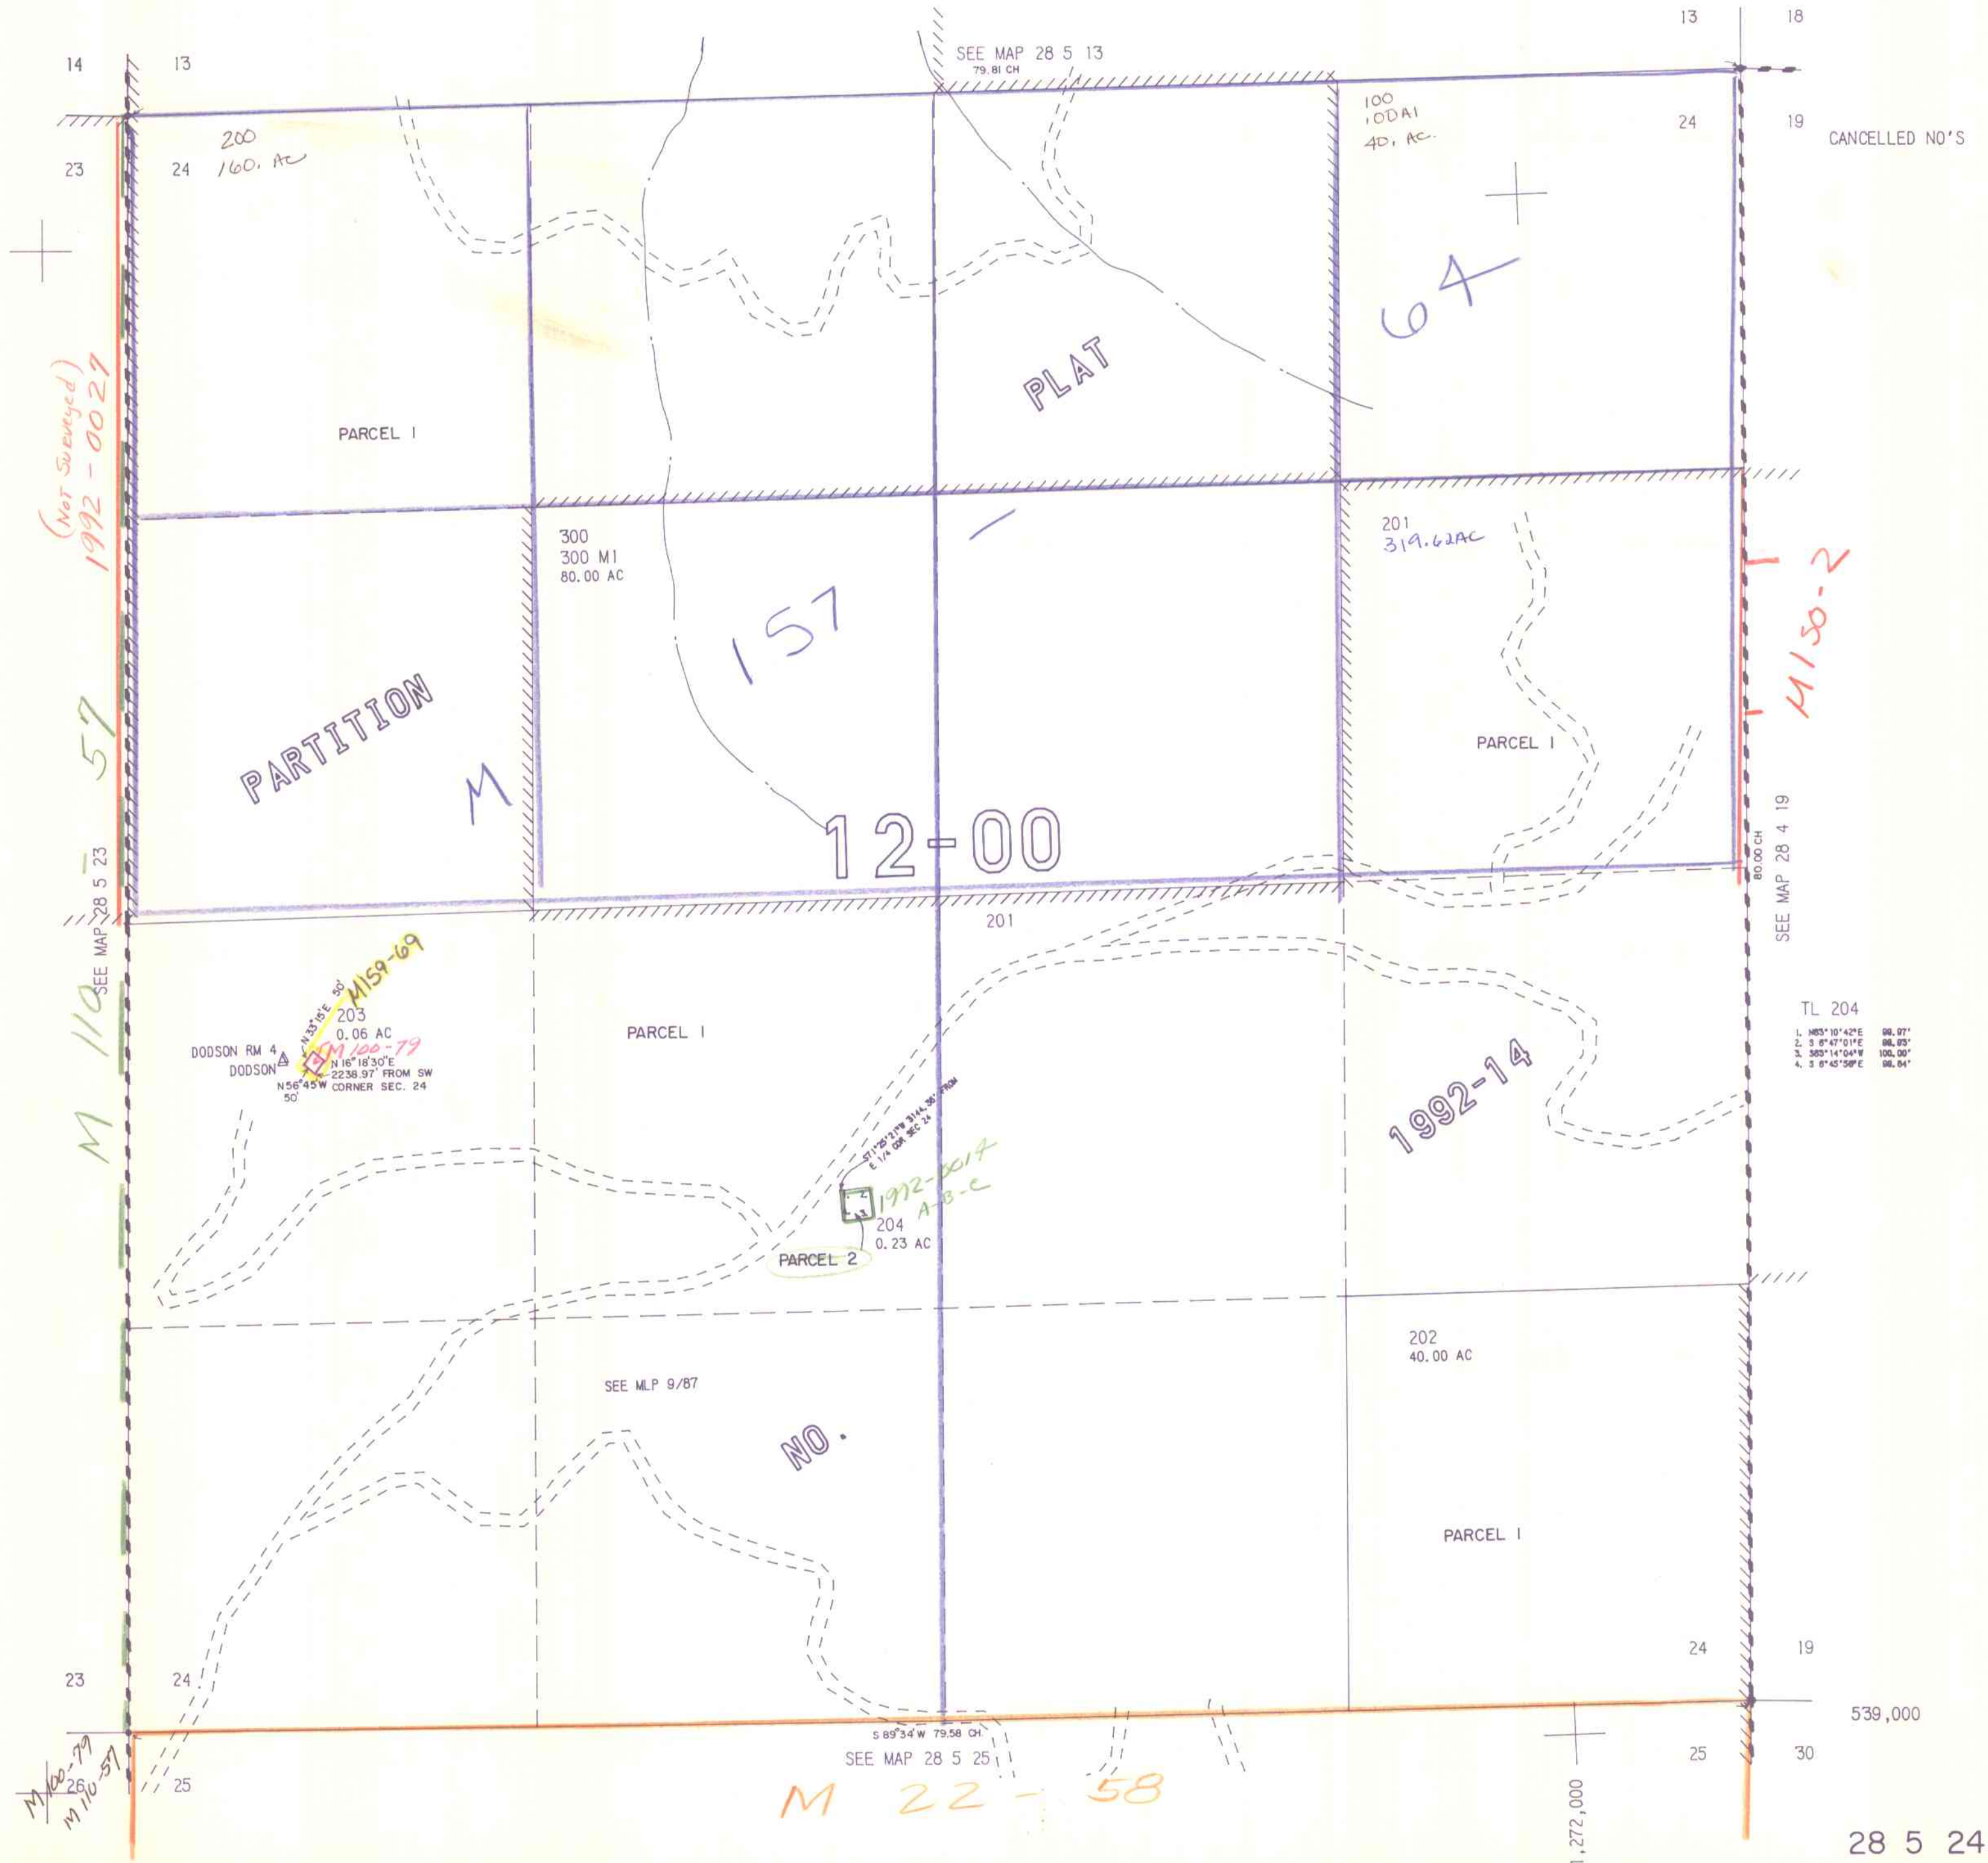

CANCELLED NO'S

M 150-2

(Not Surveyed)
1992-0029

57

M 110

M 105-79
M 110-57

M 22-58

1992-14

SEE MAP 28 4 19

TL 204
1. N85°10'42"E 98.97'
2. S 8°47'01"E 98.85'
3. S85°14'04"W 100.00'
4. S 8°45'59"E 98.84'

539,000

1,272,000

28 5 24

7/12/92