


THIS MAP WAS PREPARED FOR ASSESSMENT PURPOSE ONLY.

SECTION 9 T.28S. R.6W. W.M.
DOUGLAS COUNTY

REVISED ON
7-10-91

28 6 9

1" = 400'

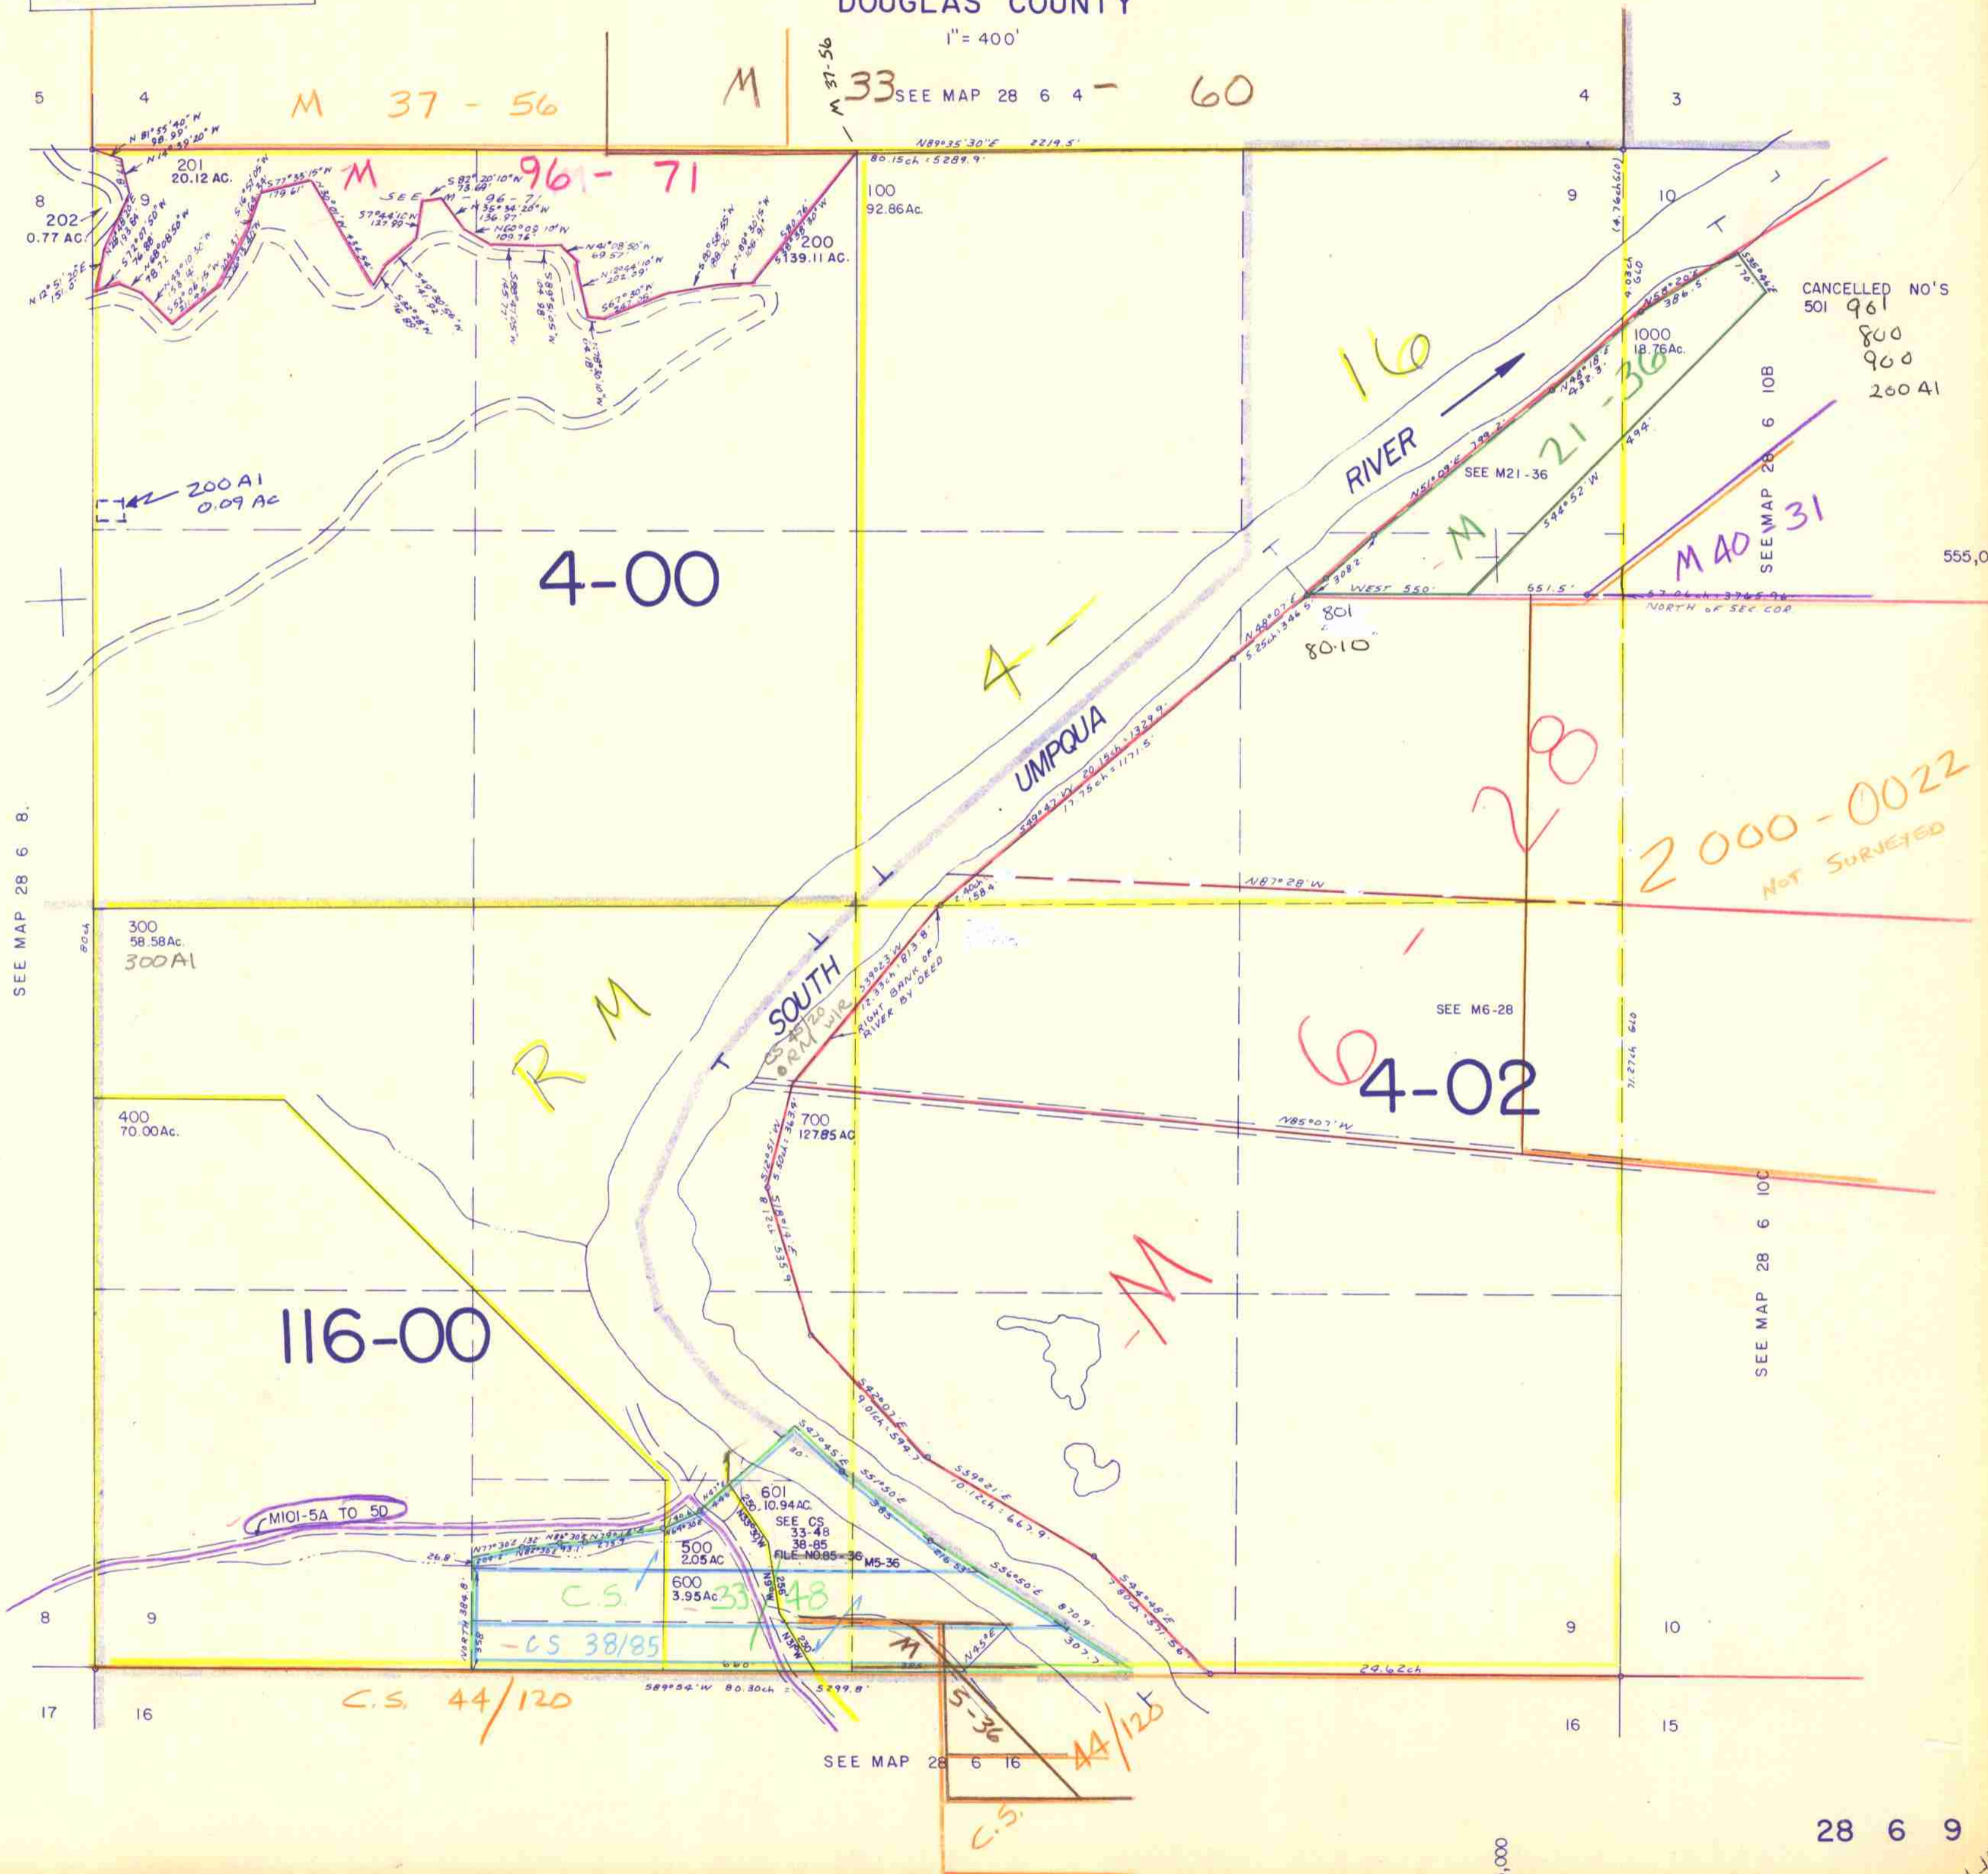

28 6 9

7-91-JP