


THIS MAP WAS PREPARED FOR ASSESSMENT PURPOSE ONLY.

SEC.10 T.28S. R.6W. W.M. DOUGLAS COUNTY

REVISED ON 11-15-07

28 6 10 & INDEX

1" = 400'

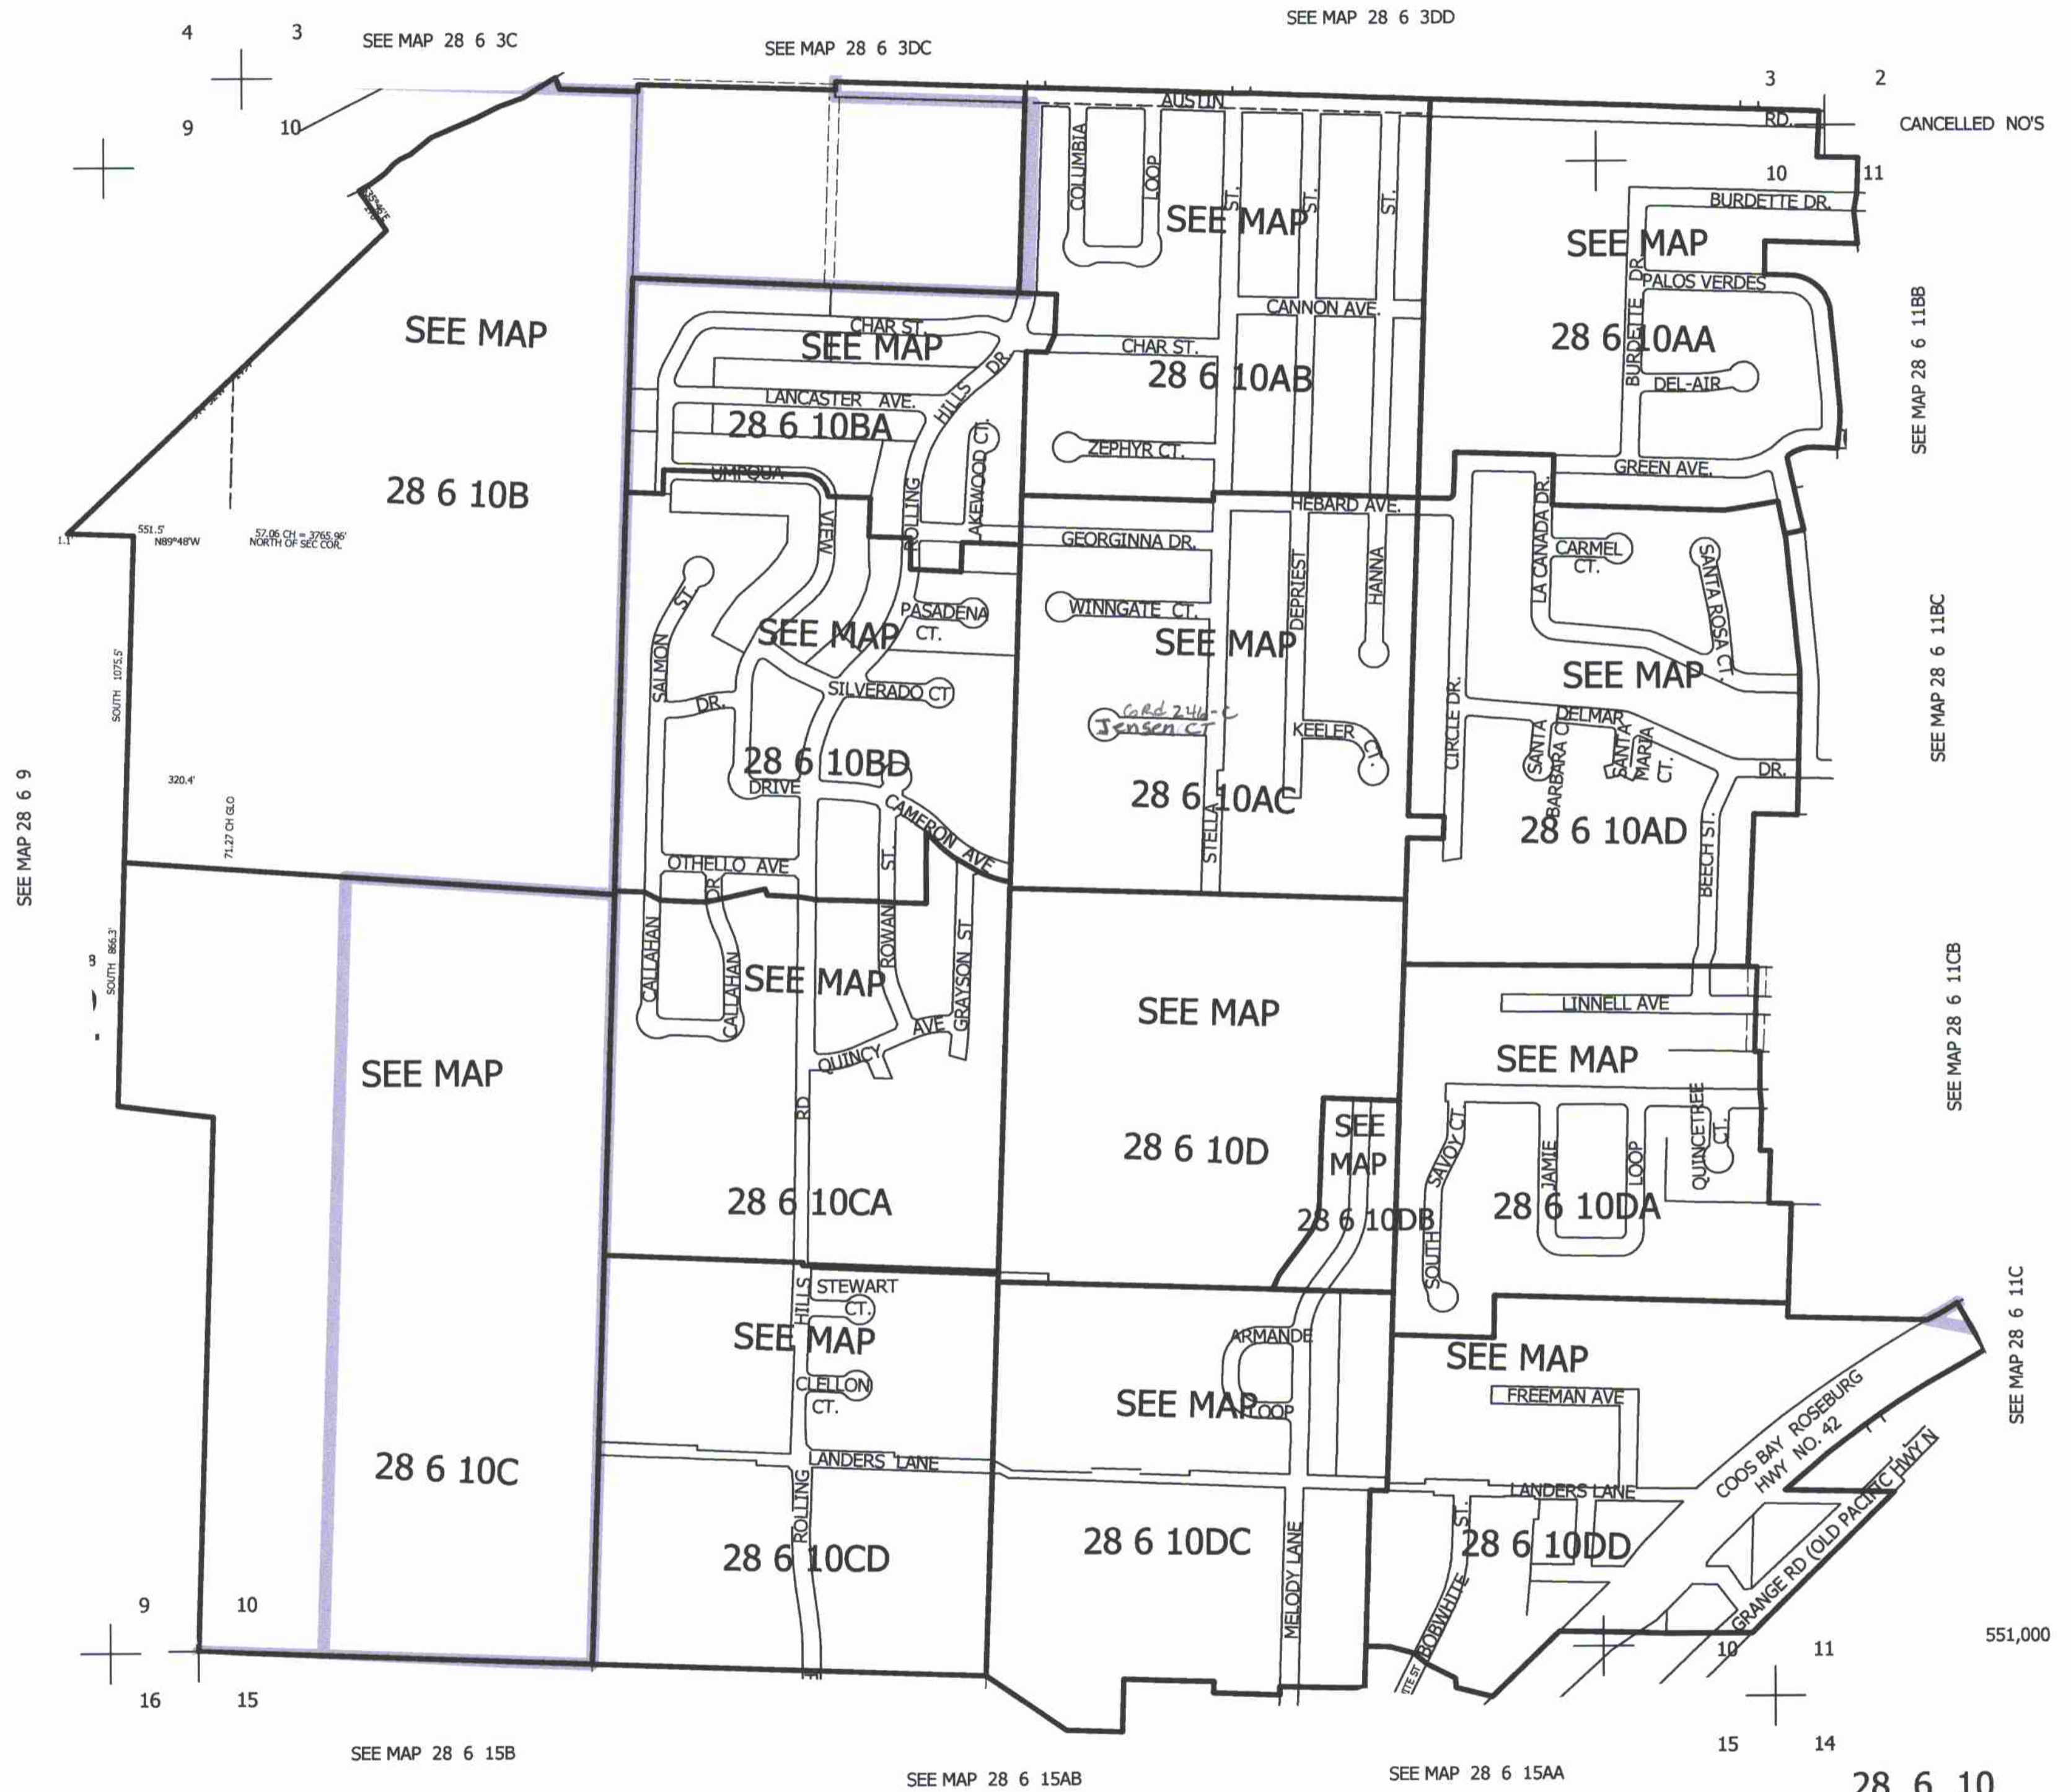

28 6 10 & INDEX

4,151,000

551,000