


SEC.24 T.28S. R.6W. W.M.  
DOUGLAS COUNTY

REVISED ON  
6-19-18

28 6 24  
& INDEX

THIS MAP WAS PREPARED FOR  
ASSESSMENT PURPOSE ONLY.

1" = 400'

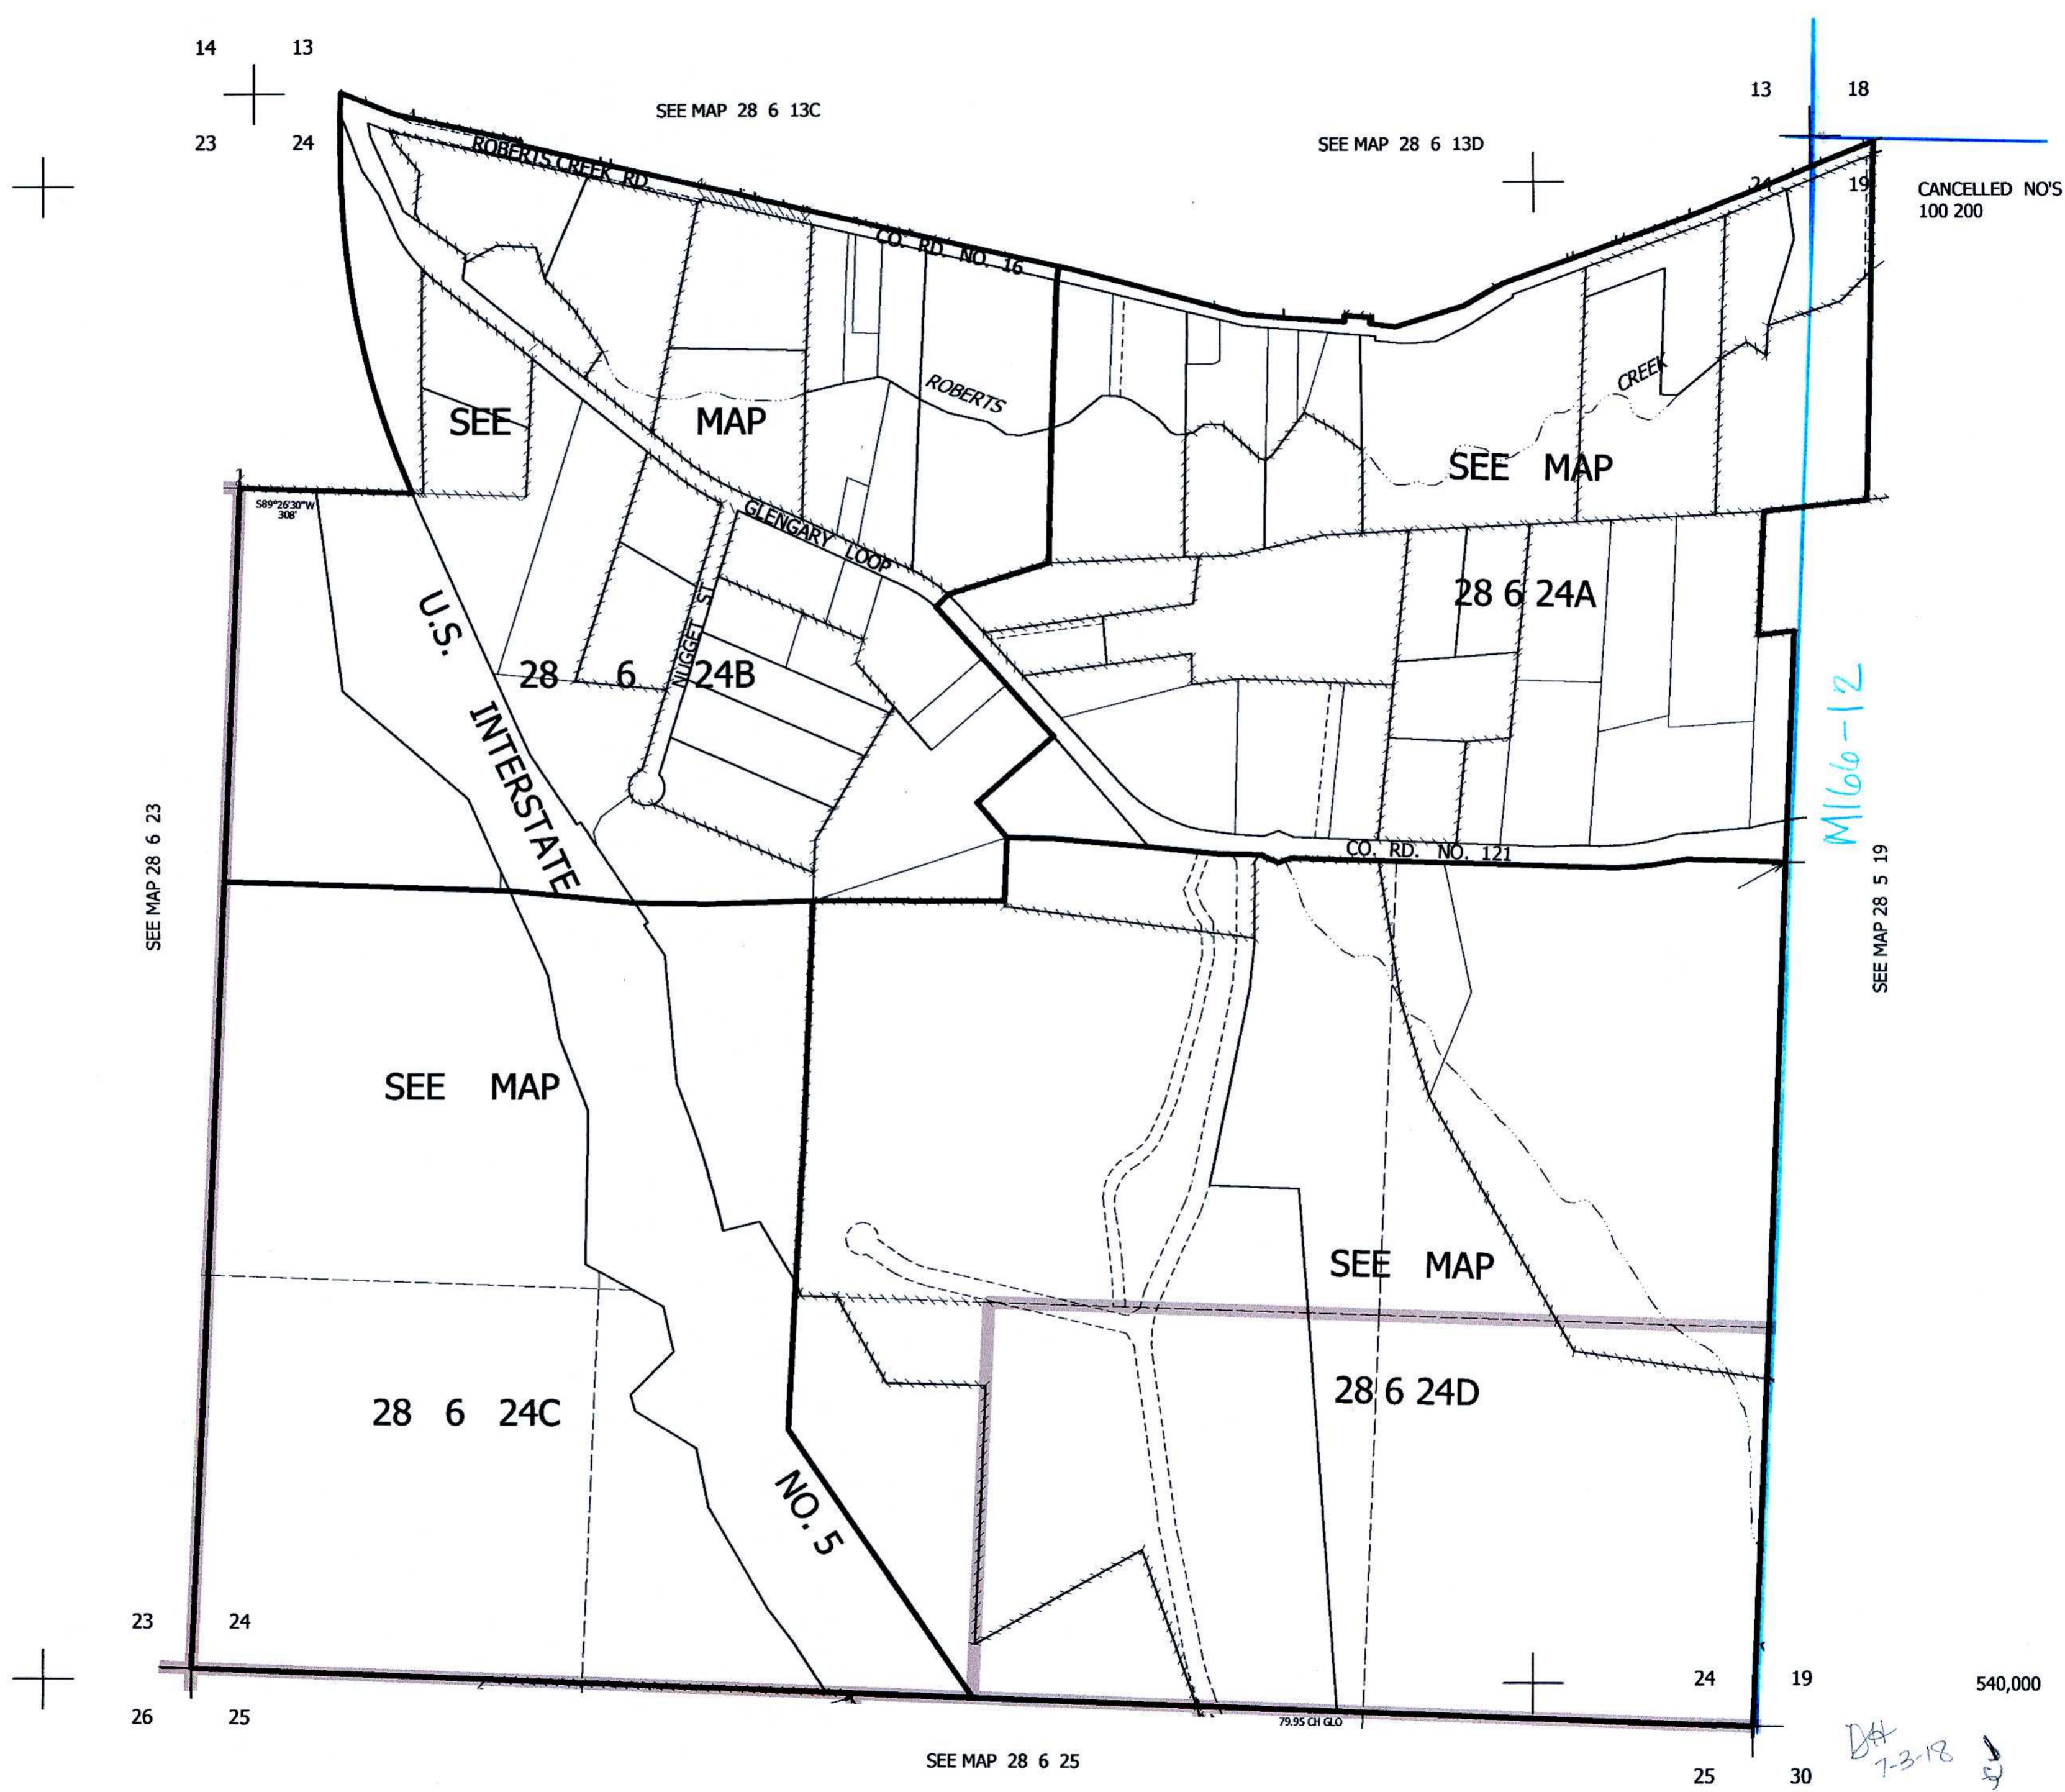

SEE MAP 28 6 23

SEE MAP 28 6 13C

SEE MAP 28 6 13D

CANCELLED NO'S  
100 200

M166-12

SEE MAP 28 5 19

SEE MAP

SEE MAP

SEE MAP 28 6 25

4,161,000

540,000

DAK  
7-3-18

28 6 24  
& INDEX