

THIS MAP WAS PREPARED FOR ASSESSMENT PURPOSE ONLY.


NW1/4 NW1/4 SEC. 27 T.28S. R.6W. W.M.
DOUGLAS COUNTY

28 6 27BB
WINSTON

1"=100'

SEE MAP 28 6 22CC

109-24

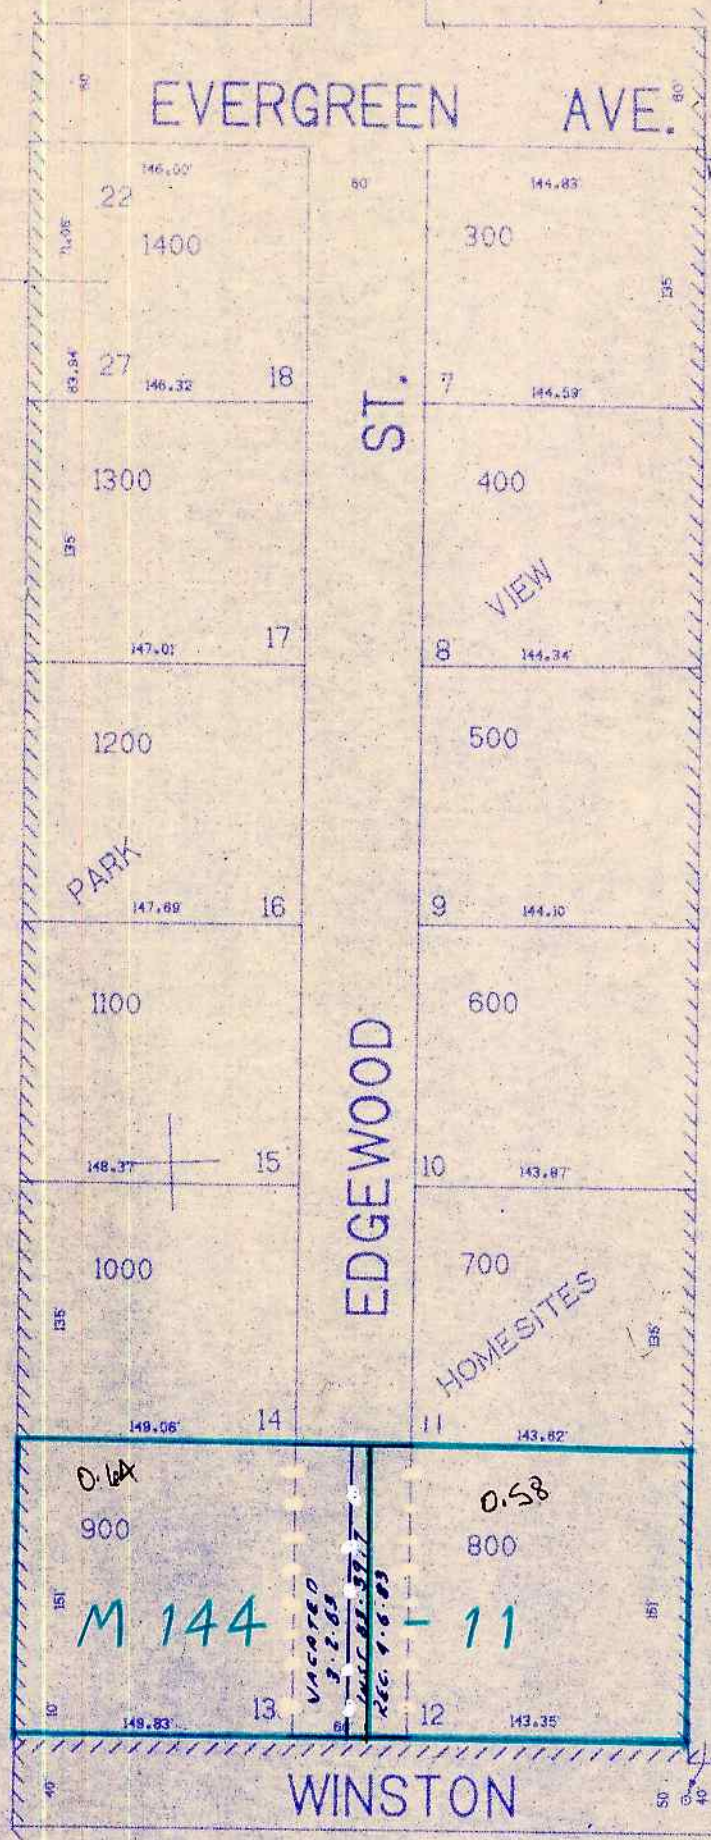


SEE MAP 28 6 28

WINSTON ROAD

116-02


ROSEBURG

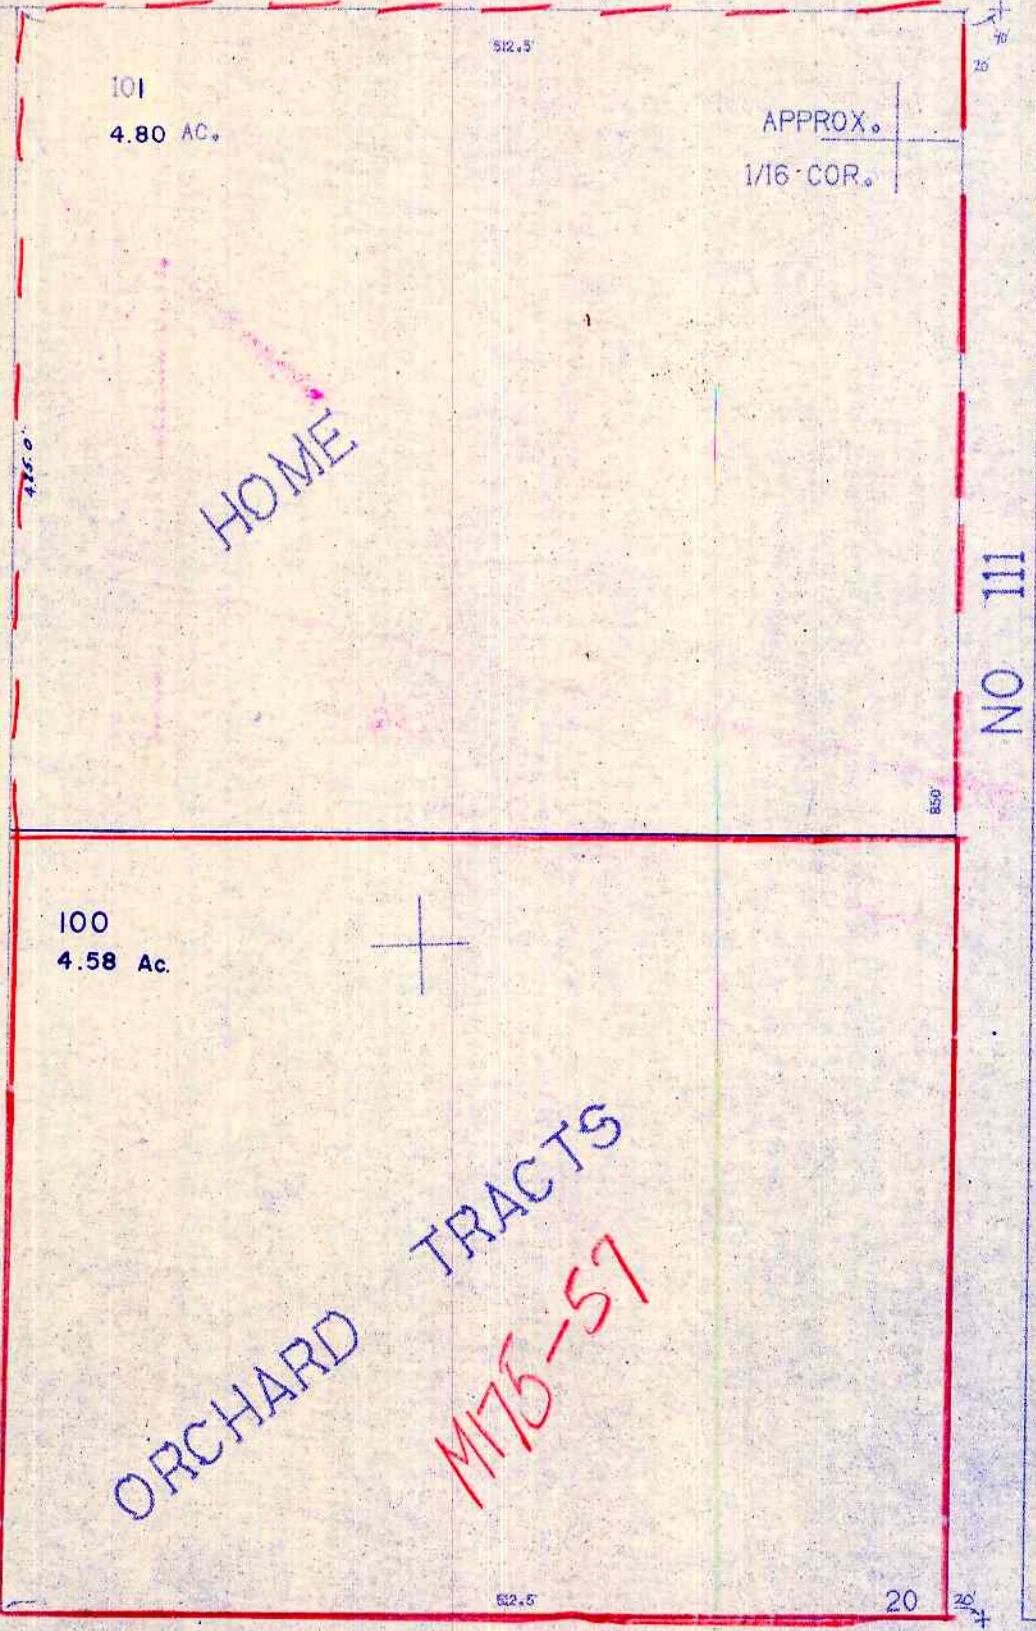

NO 111

SEE MAP 28 6 27B

SEE MAP 28 6 27B

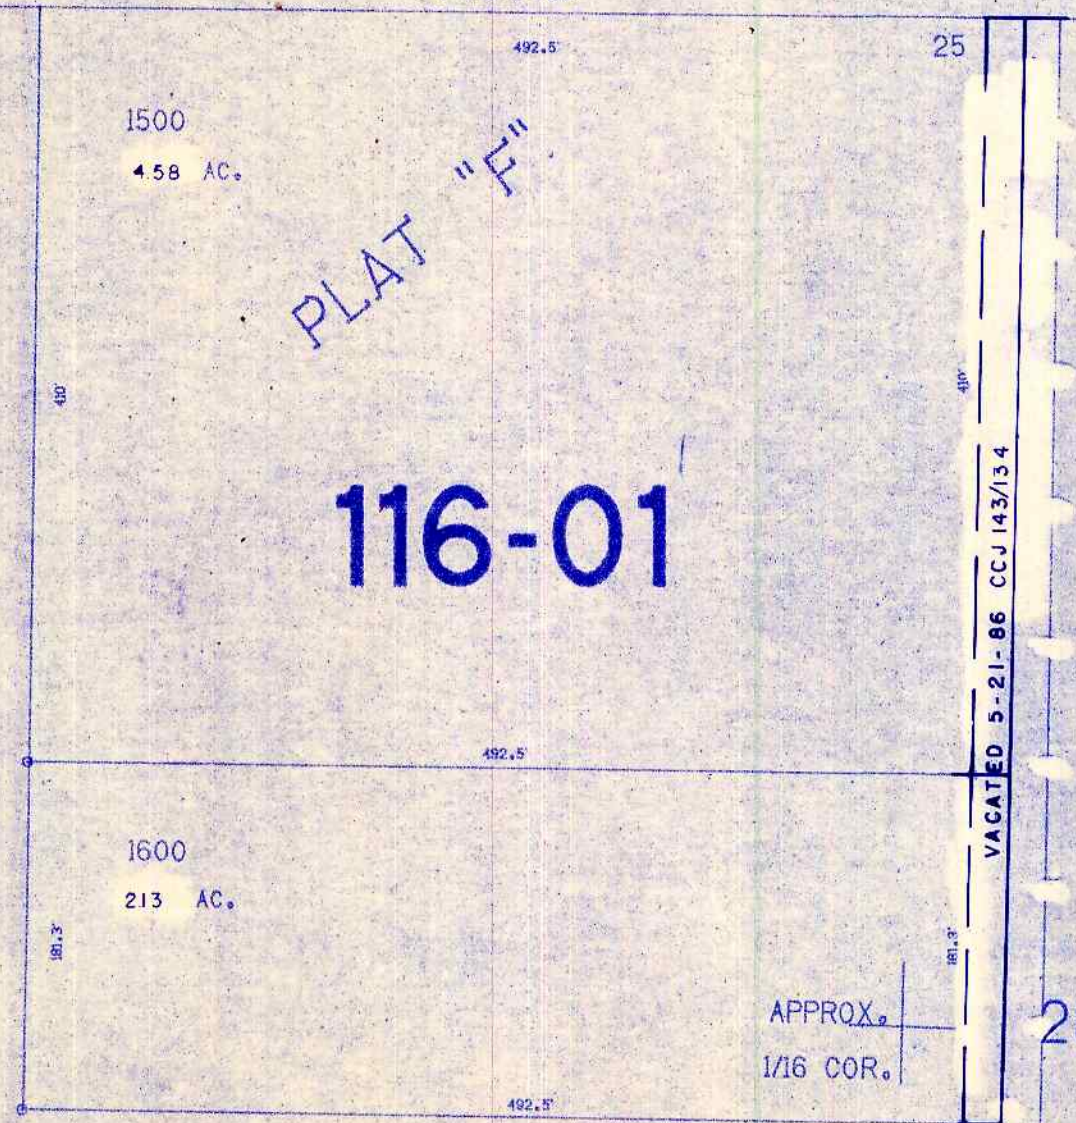

28 6 27BB
WINSTON

APPROX. 1/16 COR.

APPROX. 1/16 COR.

VACATED 5-21-86 CCJ 143/134

1,226,000

539,000

3-88

CONTROL LAYOUT CHECKED