


SE 1/4 SEC. 32 T. 28 S. R. 6 W. W.M.
DOUGLAS COUNTY

28 6 32D

THIS MAP WAS PREPARED FOR
ASSESSMENT PURPOSE ONLY.

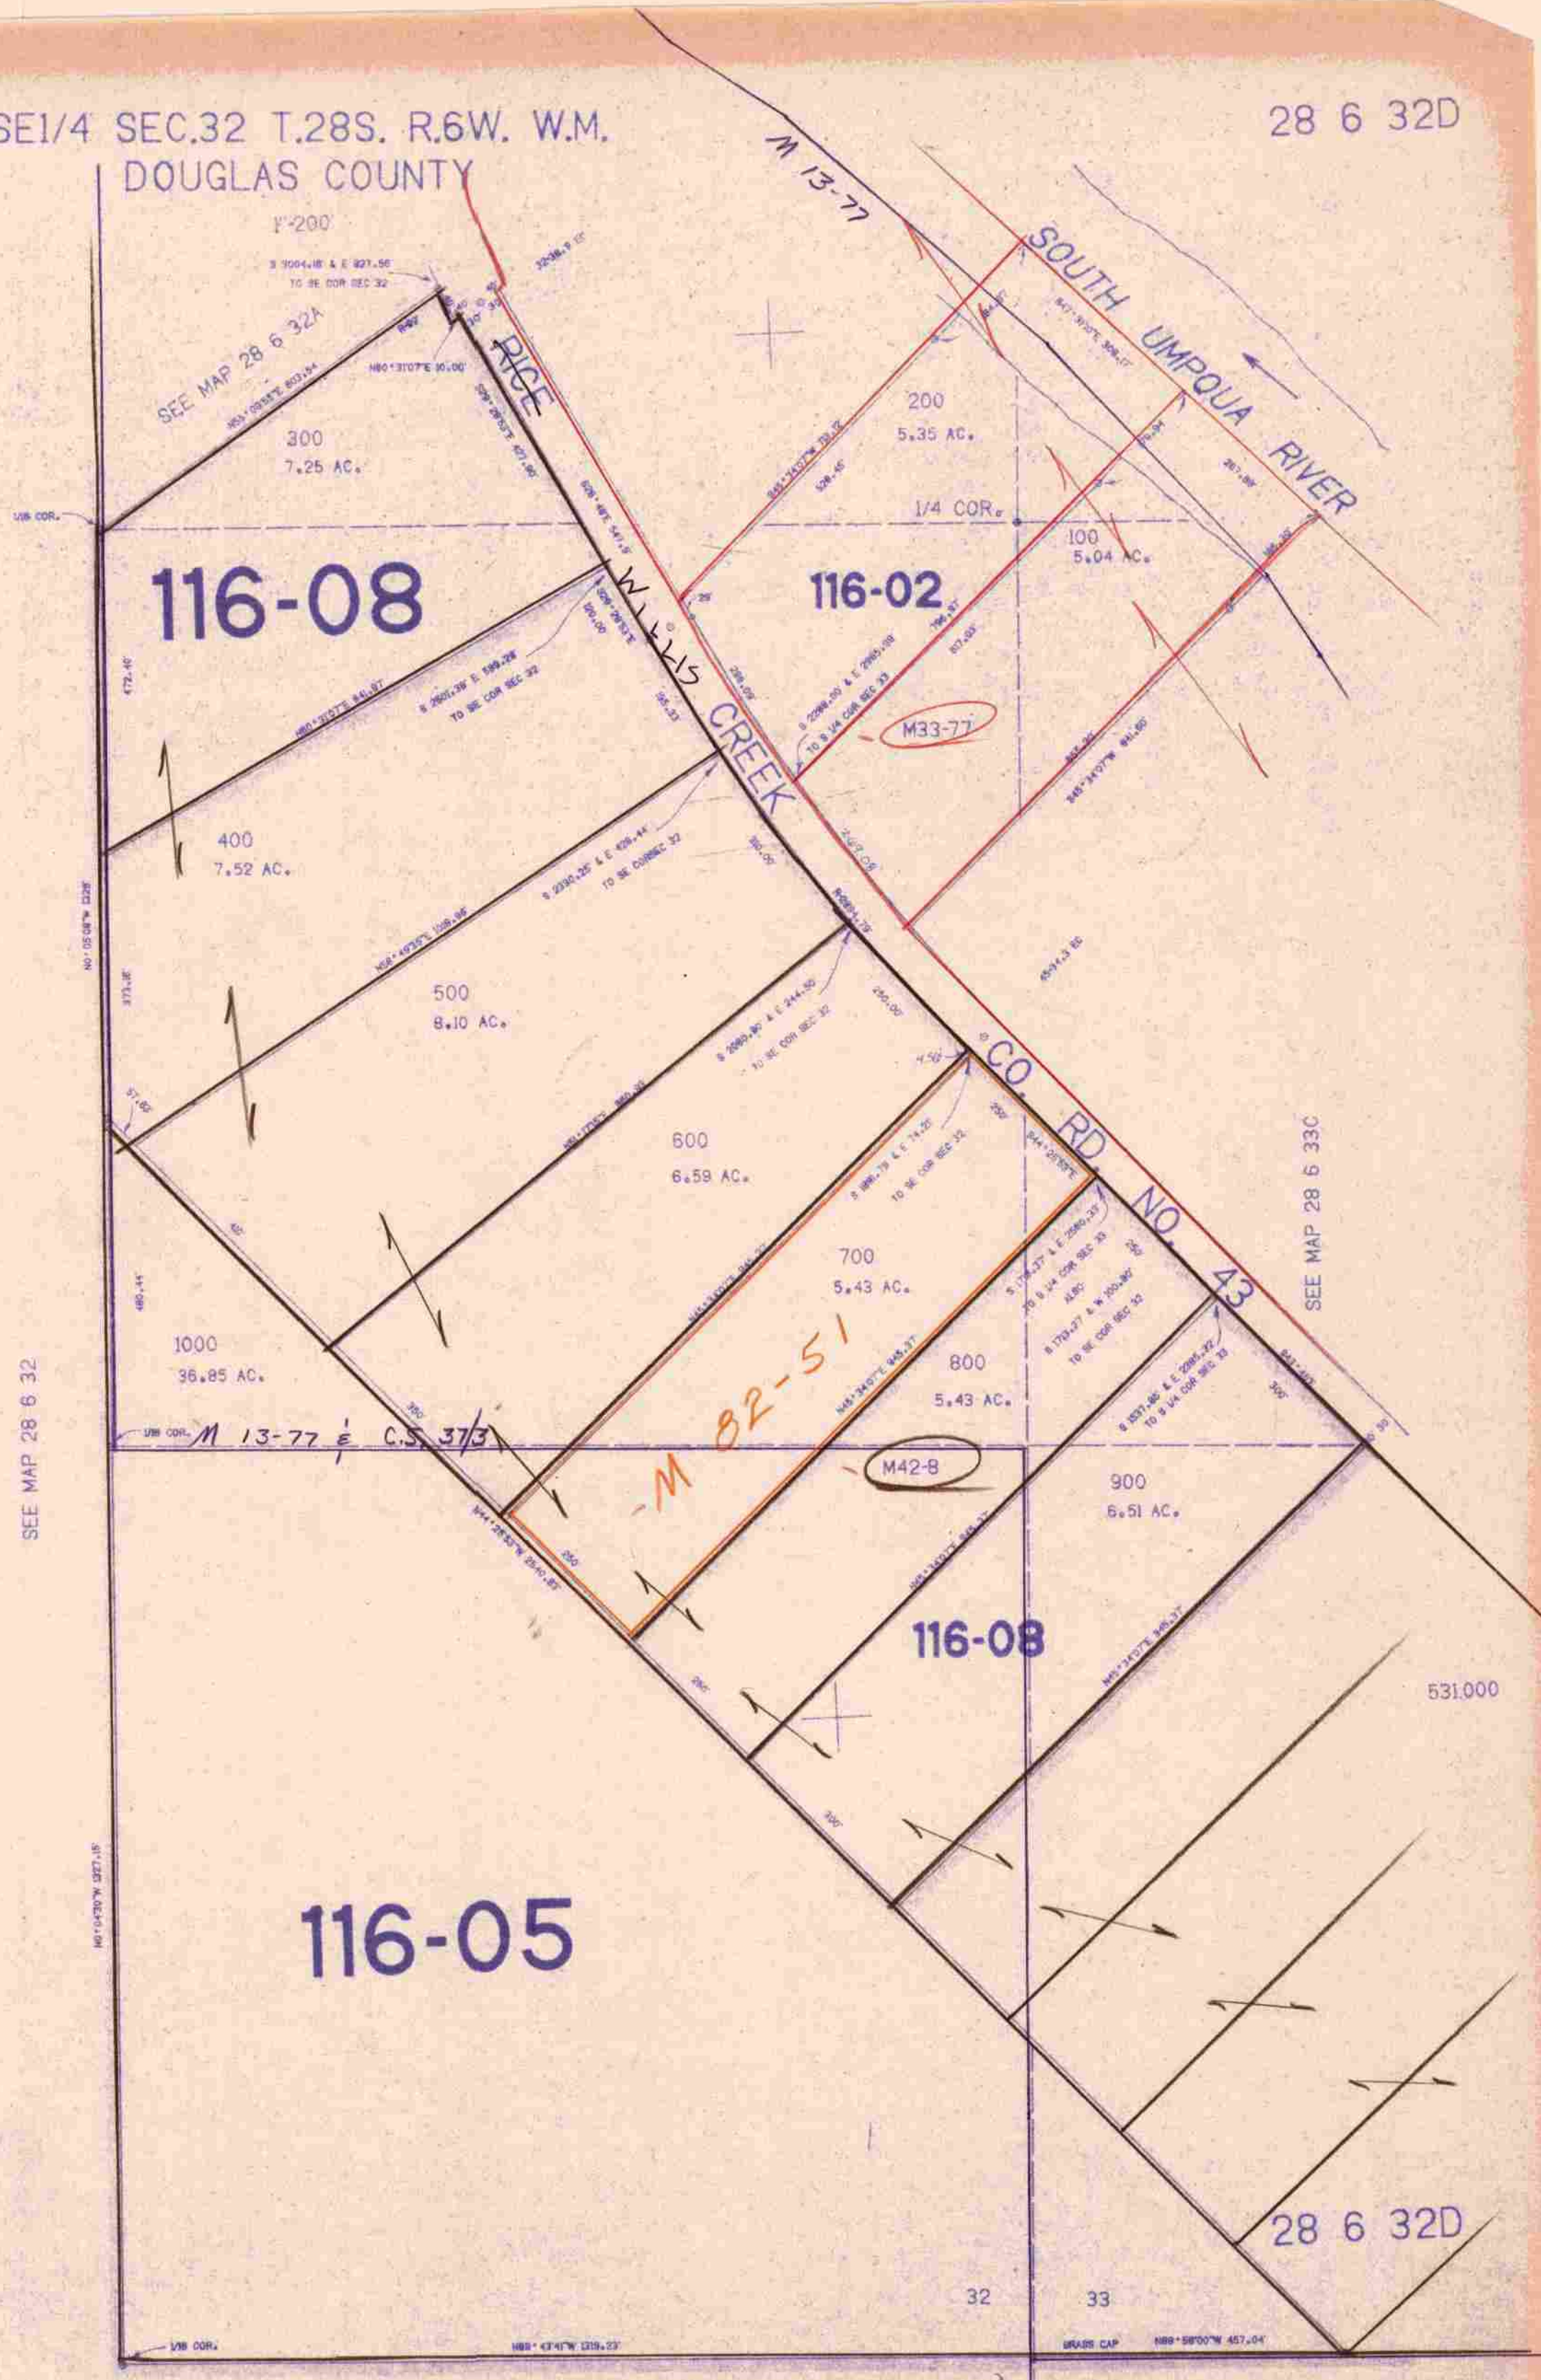

SEE MAP 28 6 32

SEE MAP 28 6 33C

1/4 COR.

1,000

28 6 32D

3/82

CHECKED
LAYOUT
CONTROL