


SECTION 30 T.28S. R.7W. W.M.
SECTION 30 T.28S. R.7 1/2W. W.M.
DOUGLAS COUNTY

28 7 30
& INDEX

THIS MAP WAS PREPARED FOR
ASSESSMENT PURPOSE ONLY.

Cancelled 130's
401 501 601

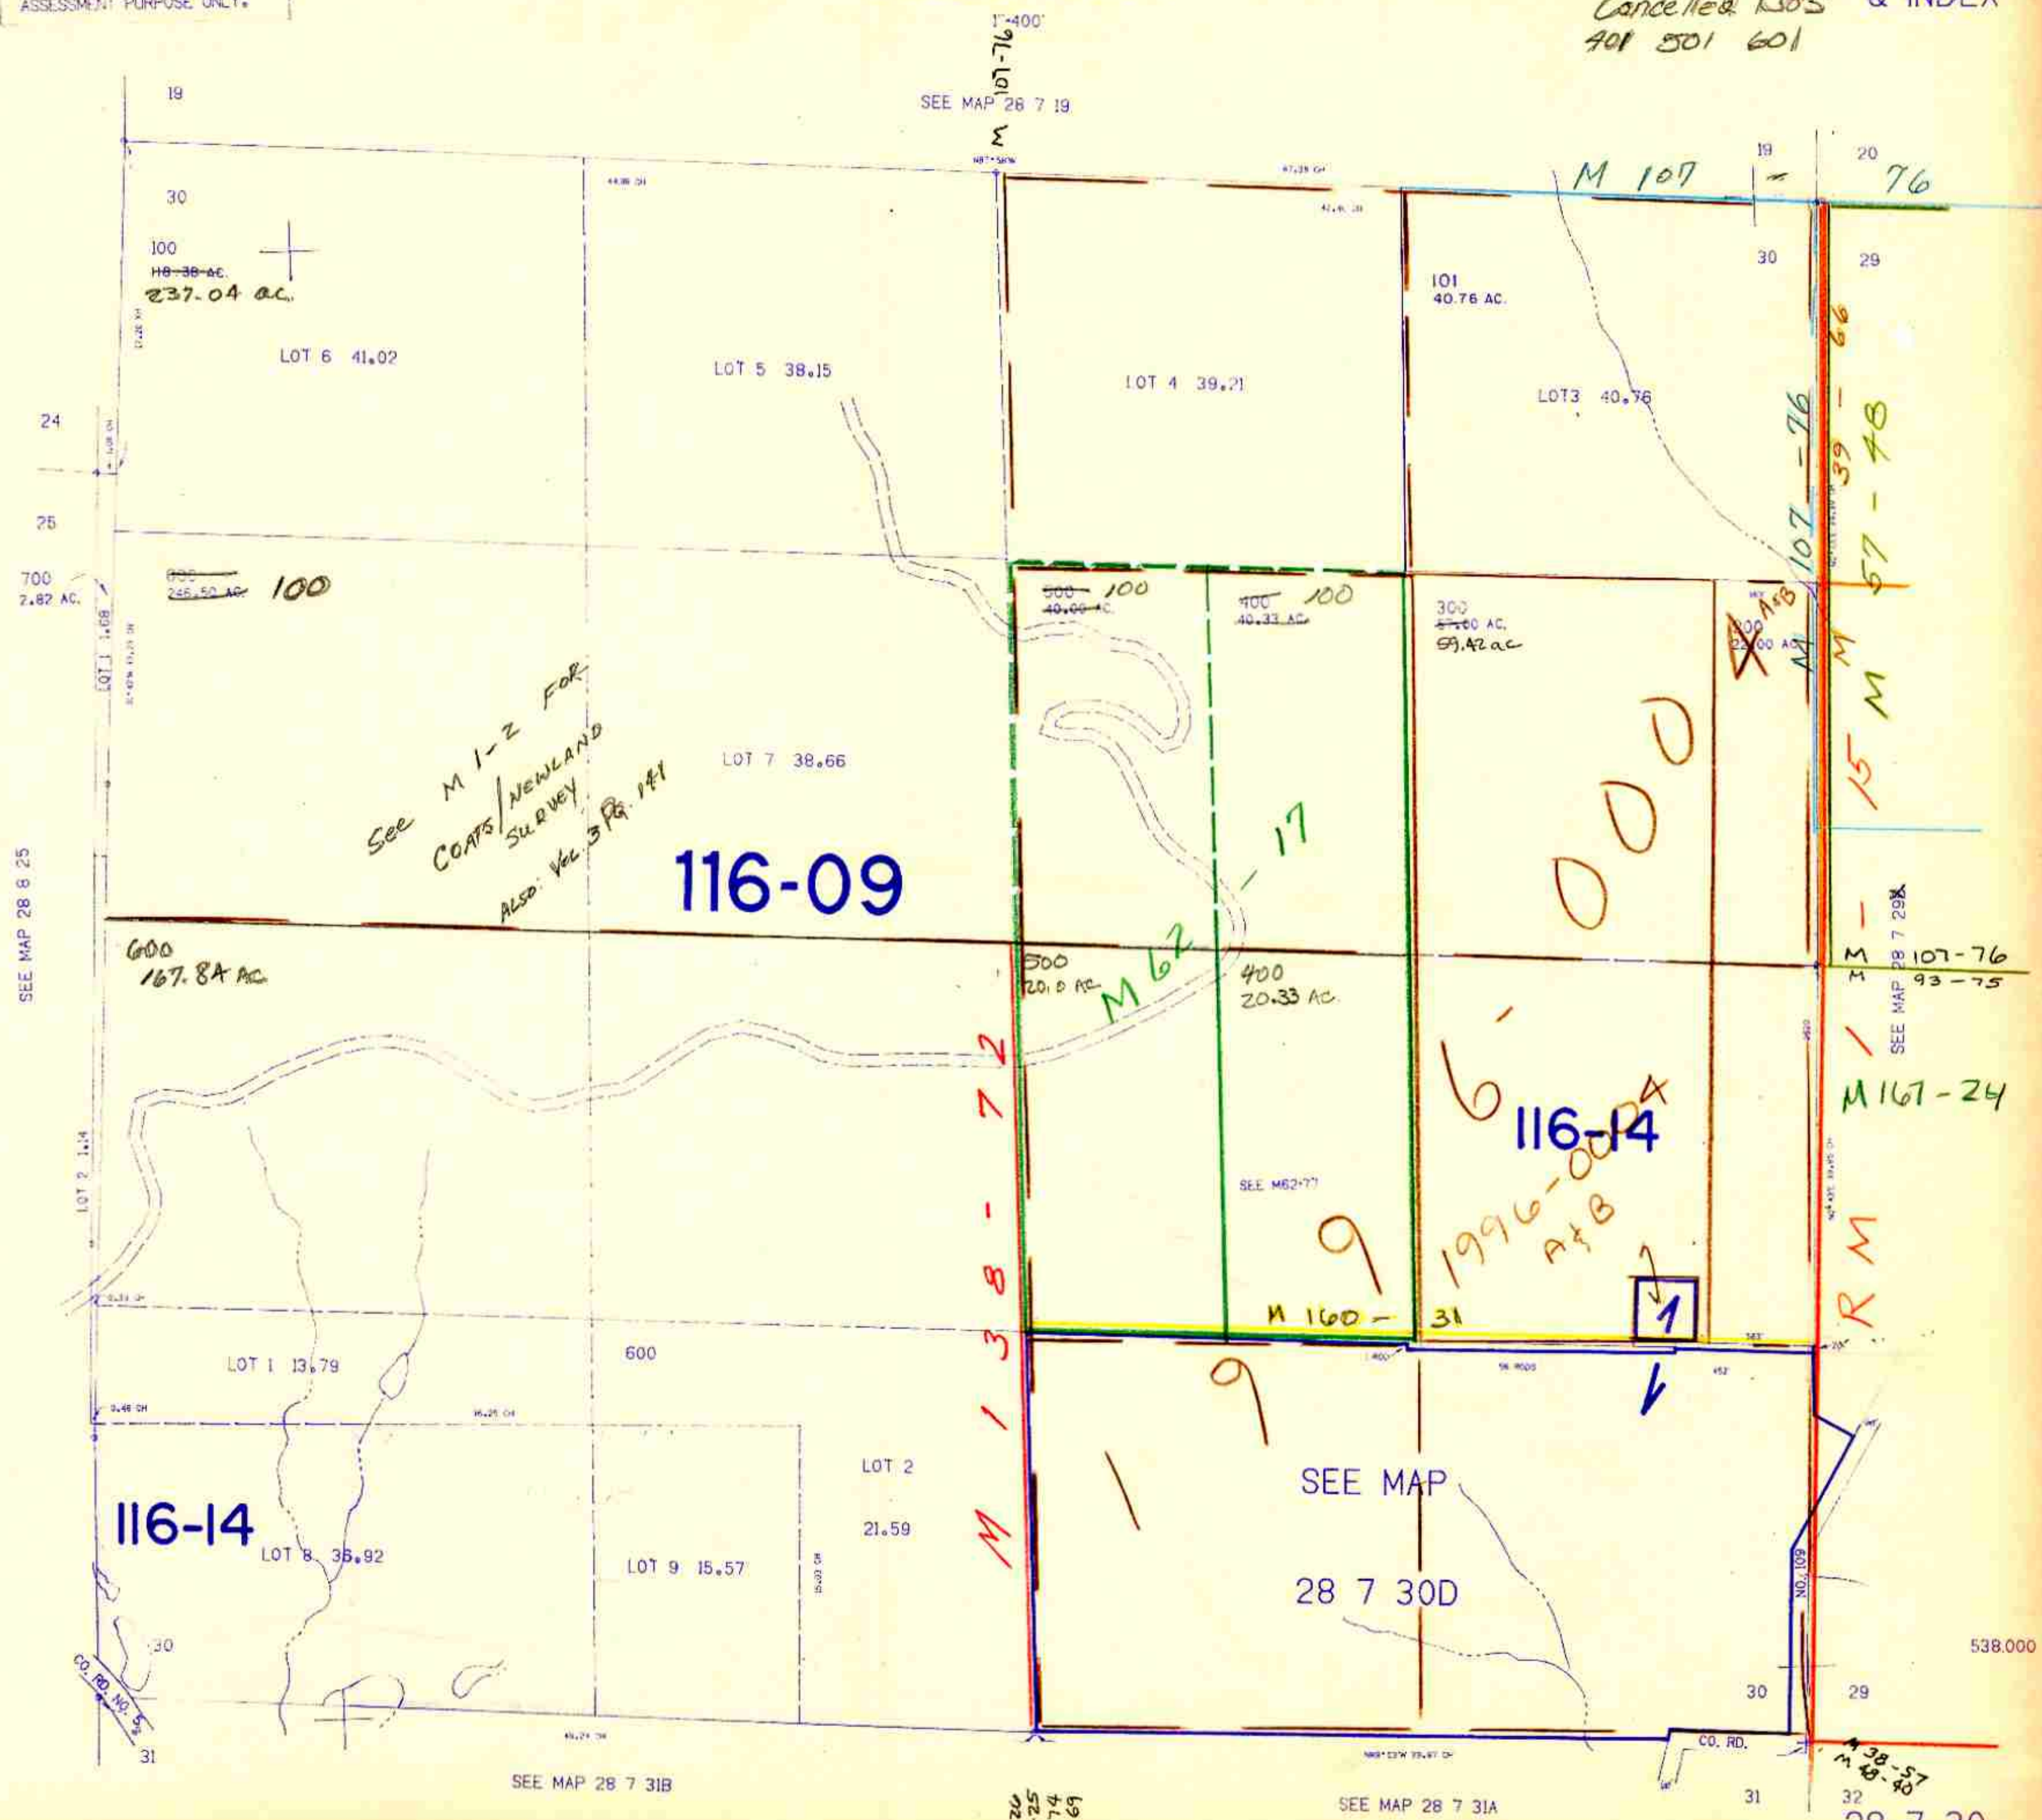

SEE MAP 28 8 25

SEE MAP 28 7 19

116-09

116-14

SEE MAP
28 7 30D

28 7 30
& INDEX

M 89-20
M 98-25
M 94-74
M 96-69

M 38-57
M 48-80

179,000

5/10/24