

THIS MAP WAS PREPARED FOR ASSESSMENT PURPOSE ONLY.

Upper Left:
123°16'21"W 43°1'41"N
4180068E 5084018 N

NE 1/4 NE 1/4 SEC. 27 T. 29S. R. 05W. W.M.
DOUGLAS COUNTY
1" = 100'


Date Exported 2023-06-27

Myrtle Creek

CANCELLED NOS:
1700 1602 3201
2003 3301 2801

SEE MAP
2905W22

2006-0006

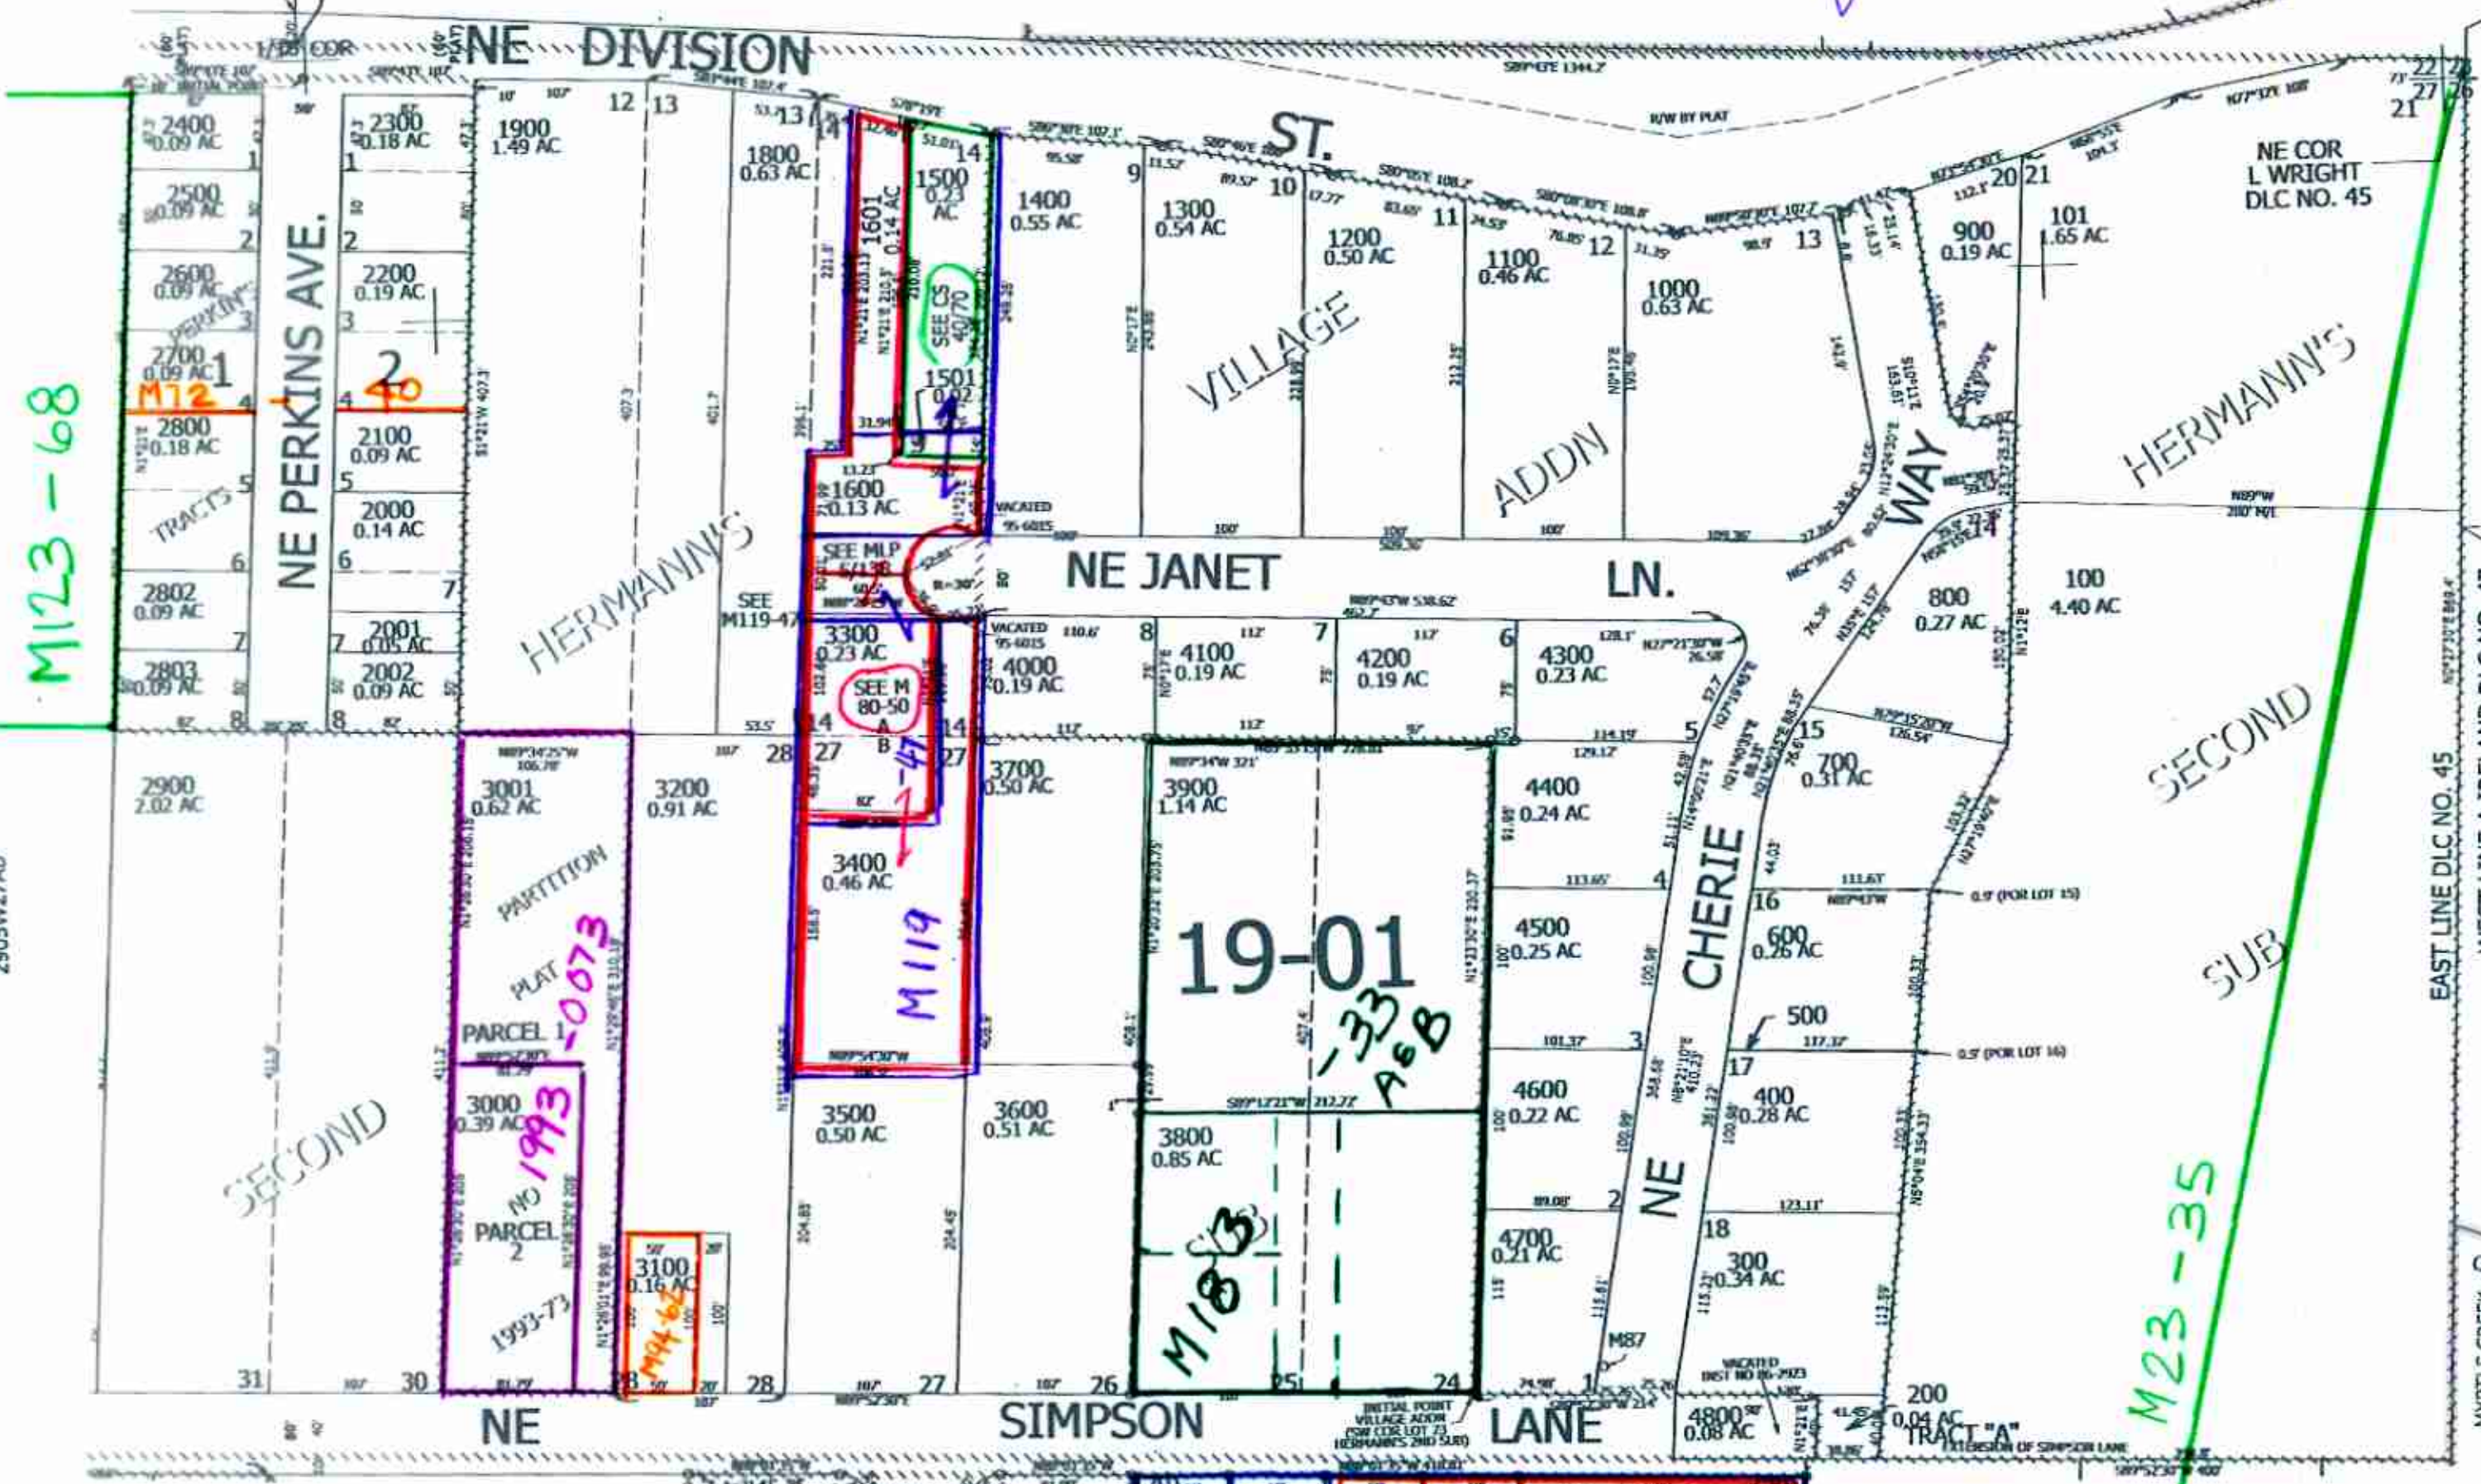

SEE MAP
2905W27AB

SEE MAP
2905W23C

SEE MAP
2905W26B

SEE MAP
2905W27

SEE MAP
2905W27

SEE MAP
2905W27AD

1/16 COR

1/16 COR

6/2023 B
JCV

290527A
Myrtle Creek

Lower Right:
123°15'54"W 43°1'24"N
4182031E 506663N ft