

SW1/4 NE1/4 SEC.28 T.29S. R.5W. W.M.
DOUGLAS COUNTY

29 5 28AC
MYRTLE CREEK

THIS MAP WAS PREPARED FOR
ASSESSMENT PURPOSE ONLY.

1"=100'

APPROX.
1/16 COR.
BY G.L.O.

APPROX. 1/16 COR.
BY G.L.O.
APPROX. 1/16 COR.

APPROX. 1/16 COR.

+


19-01

SEE MAP 29 5 28

SEE M4-70

SEE MAP 29 5 28AD

PT. IS 324.8' NORTH
& 800.02' EAST OF
THE SW COR. OF
LAZARUS WRIGHT
DLD NO. 45

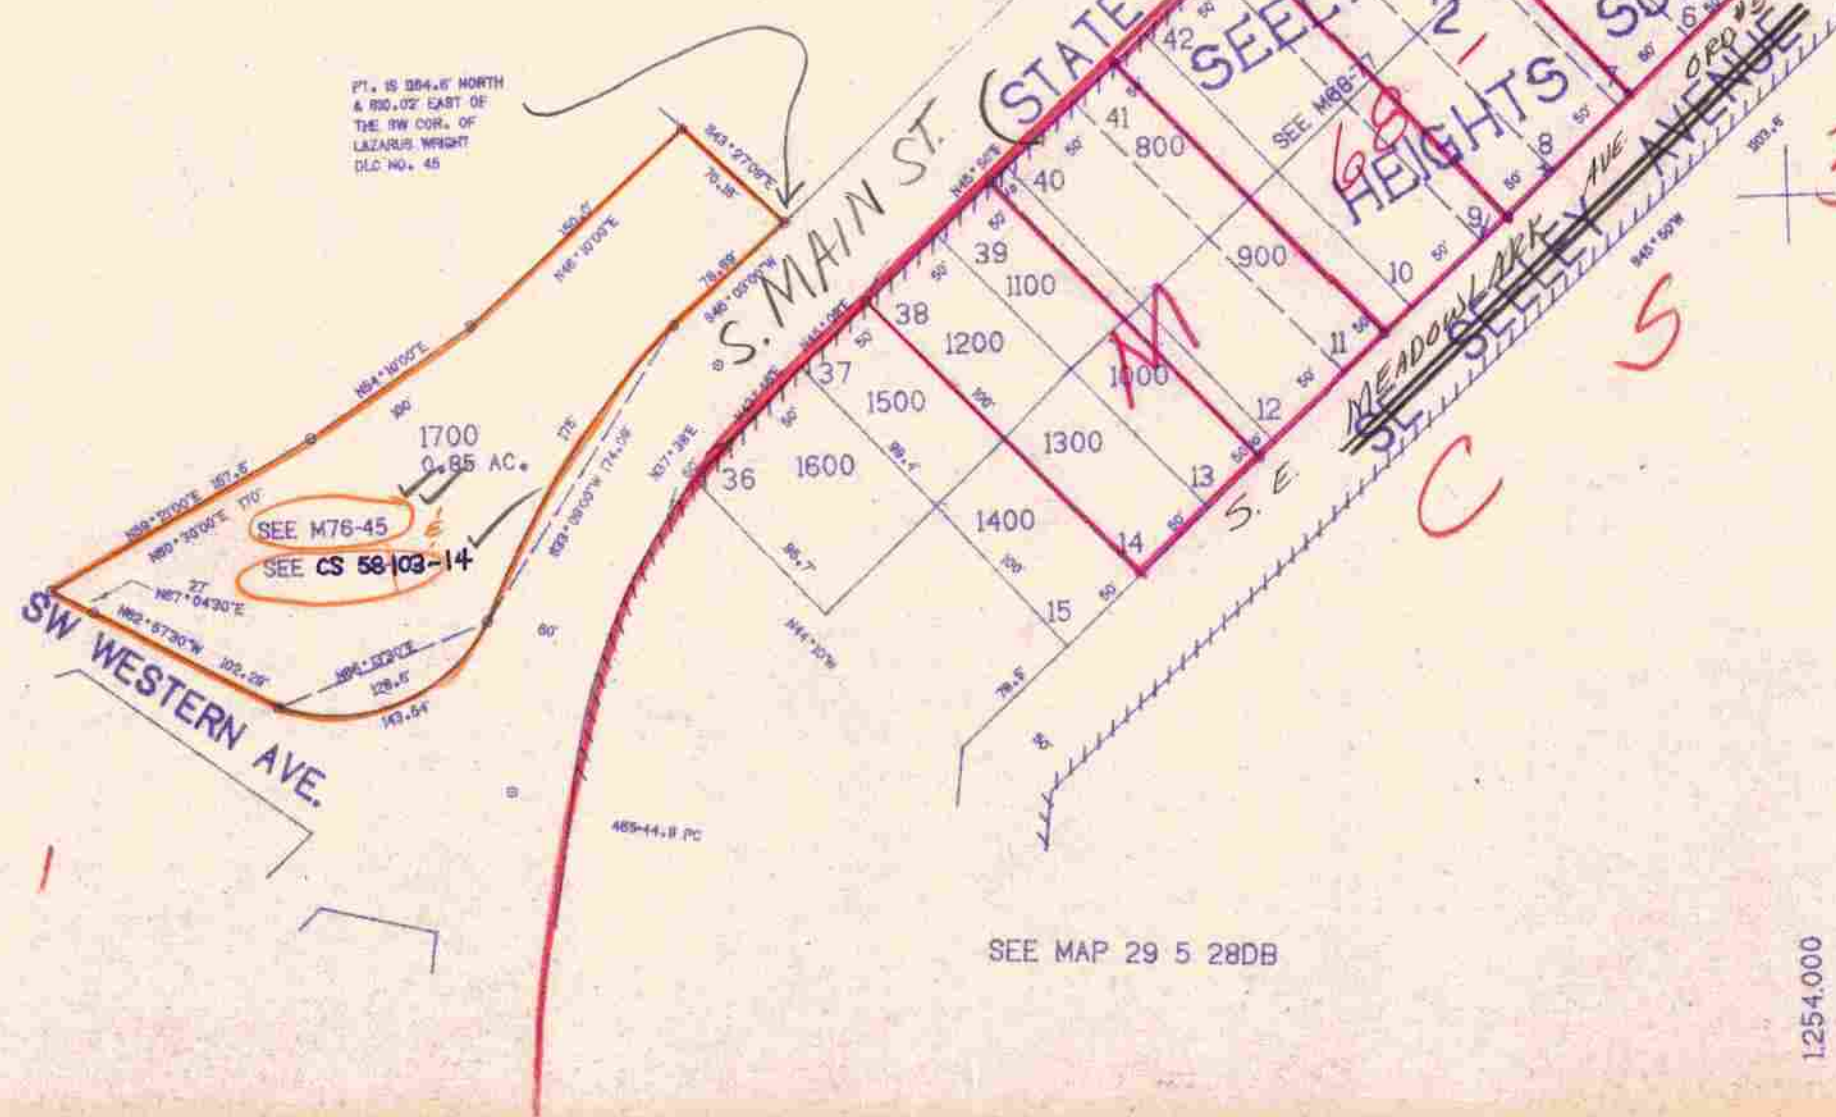

APPROX. CEN. SEC.
BY G.L.O.

APPROX.
1/16 COR. BY G.L.O.

APPROX.
CEN. SEC.

+

APPROX. 1/16 COR.

SEE MAP 29 5 28DB

1254.000

506.000

29 5 28AC
MYRTLE CREEK

CONTROL LAYOUT RACED CHECKED

102/28