

THIS MAP WAS PREPARED FOR ASSESSMENT PURPOSE ONLY.

SEC.2 T30S. R.4W. W.M. DOUGLAS COUNTY


1" = 400'

REVISED ON 1-16-13

30 4 2

CANCELLED NO'S 700

SEE MAP 30 4 1

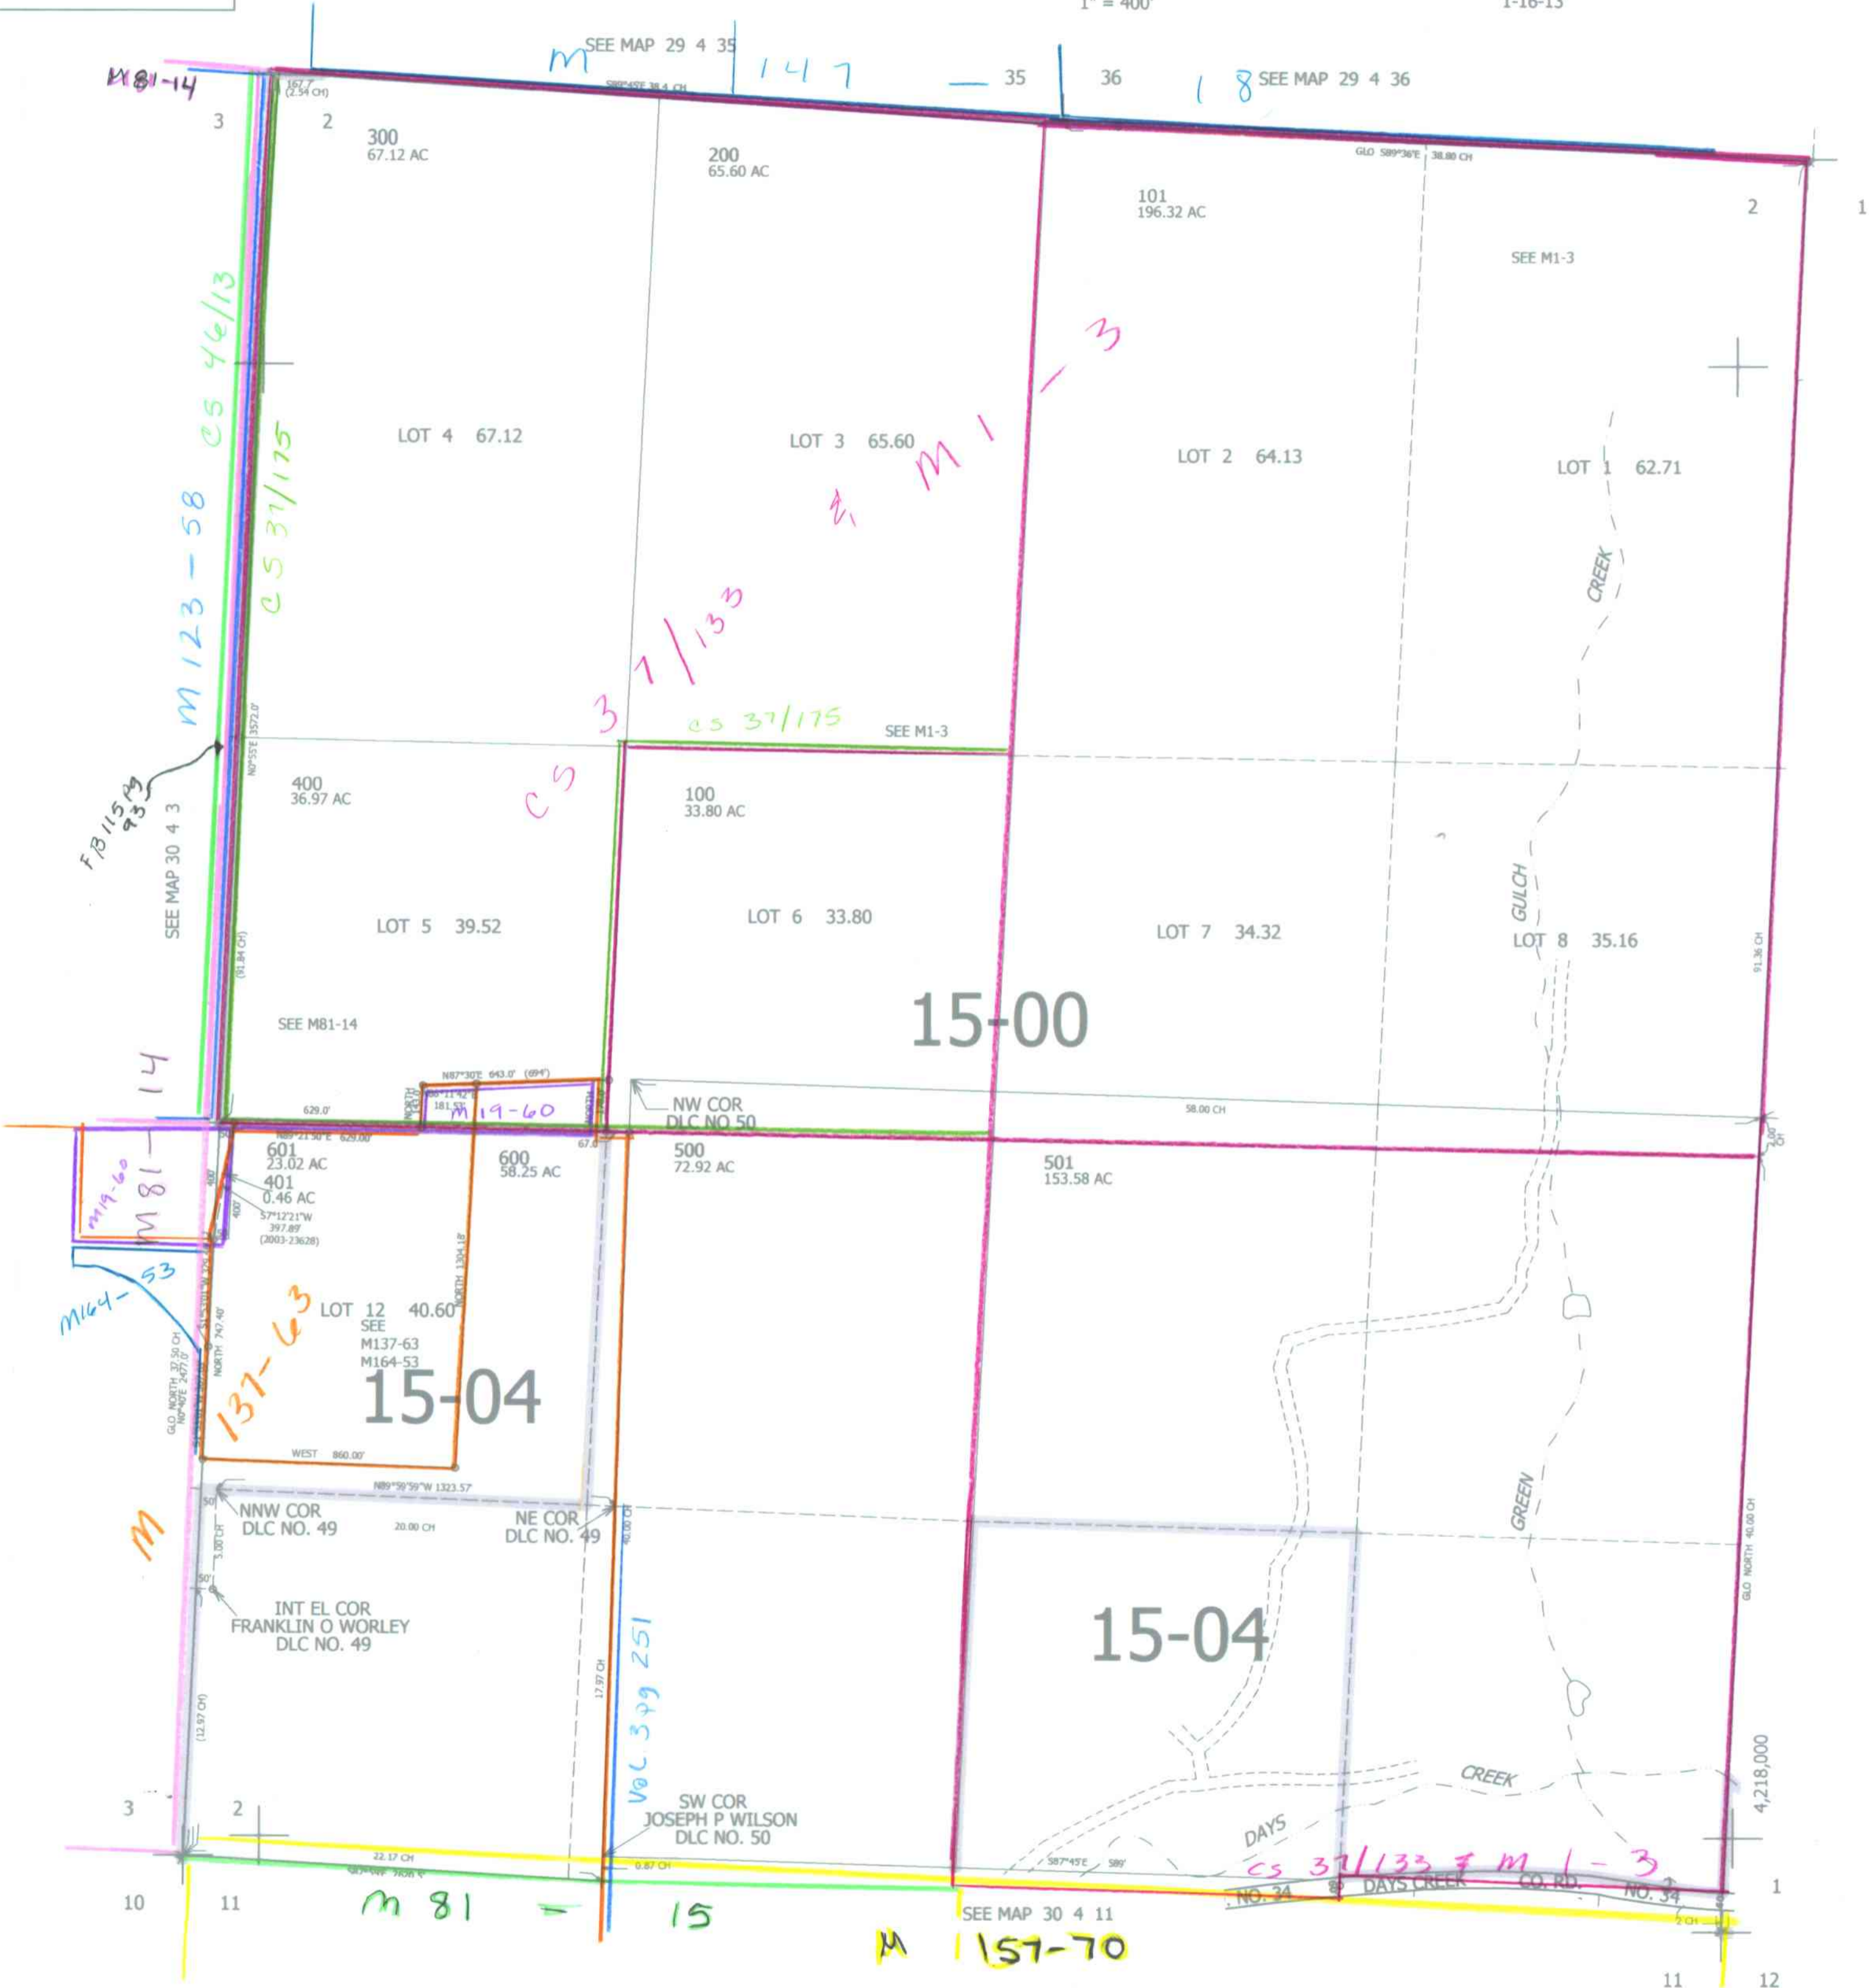

Carmen 03/01/13 491,000

30 4 2

11 12