


THIS MAP WAS PREPARED FOR ASSESSMENT PURPOSE ONLY.

SE1/4 SEC.10 T30S. R.4W. W.M. DOUGLAS COUNTY  
1" = 200'

REVISED ON 8-19-11

30 4 10D

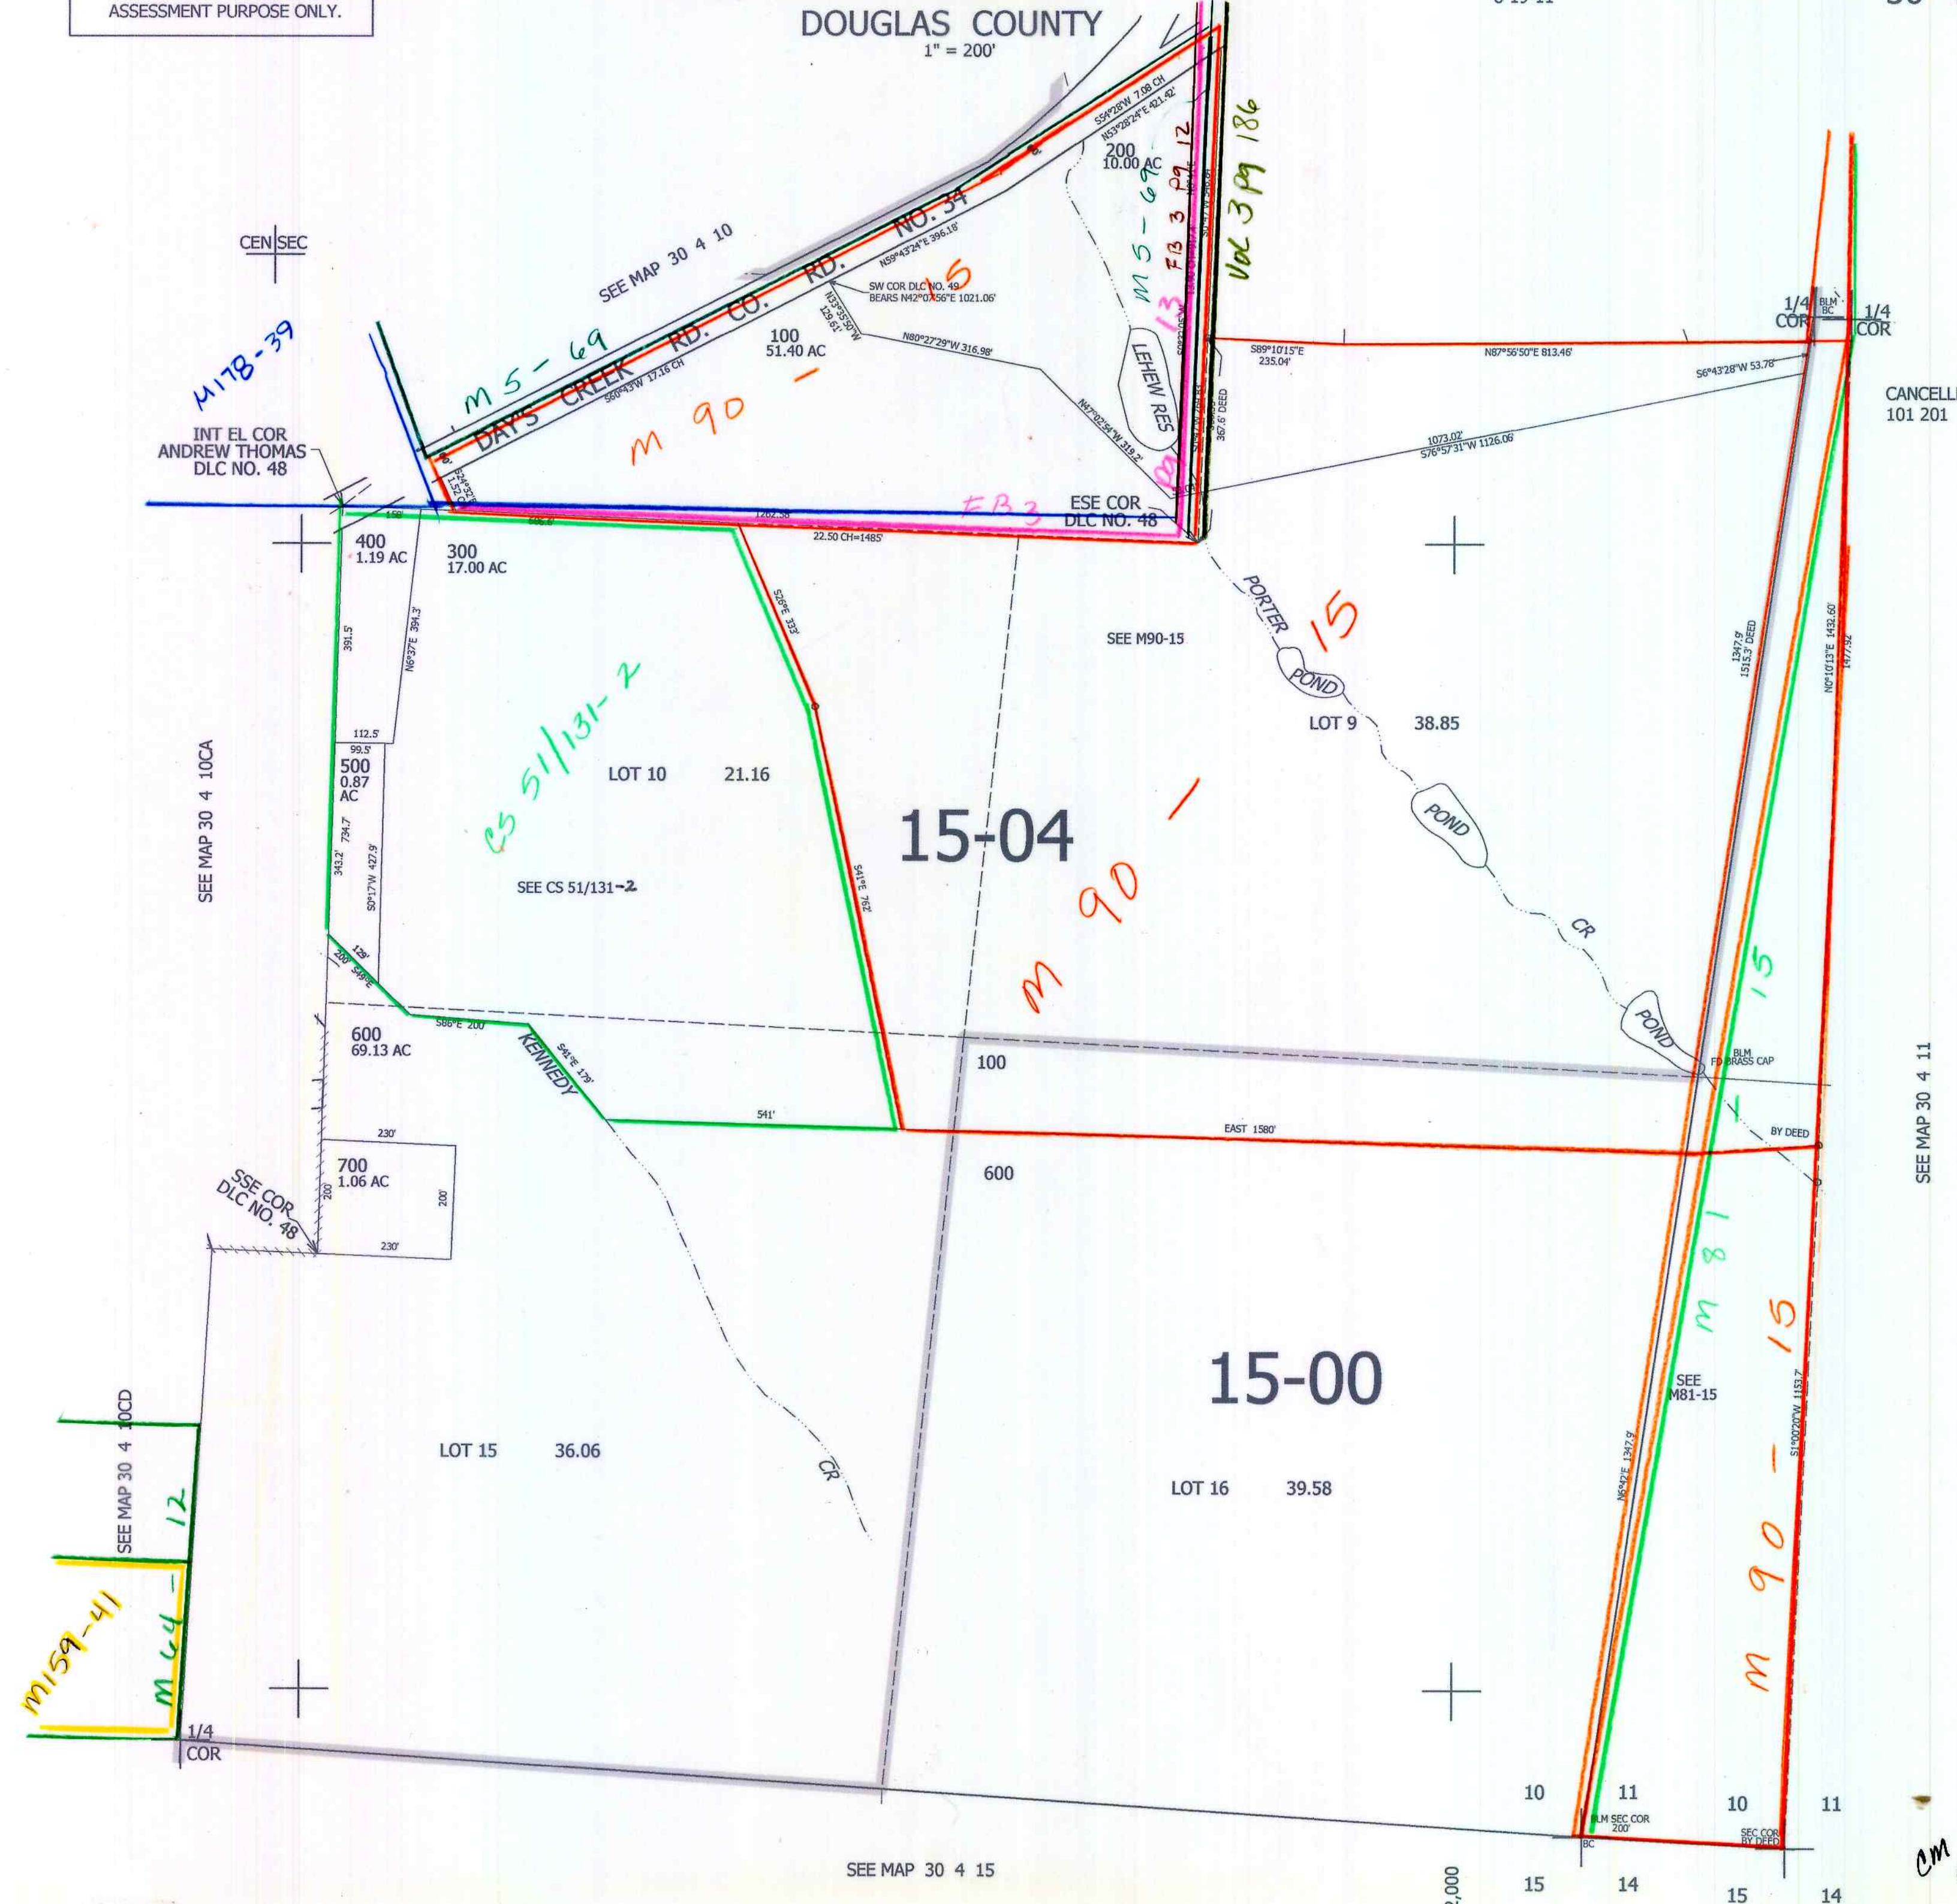

CEN SEC  
M178-39  
INT EL COR  
ANDREW THOMAS  
DLC NO. 48

SEE MAP 30 4 10CA

M159-41  
M64-12  
SEE MAP 30 4 10CD

1/4 COR

SEE MAP 30 4 15

4,212,000

30 4 10D

CANCELLED NO'S  
101 201

SEE MAP 30 4 11

486,000

CM  
9/16/11  
JC