


THIS MAP WAS PREPARED FOR ASSESSMENT PURPOSE ONLY.

SEC.4 T30S. R.5W. W.M.
DOUGLAS COUNTY
1" = 400'

REVISED ON
6-12-13

30 5 4
& INDEX

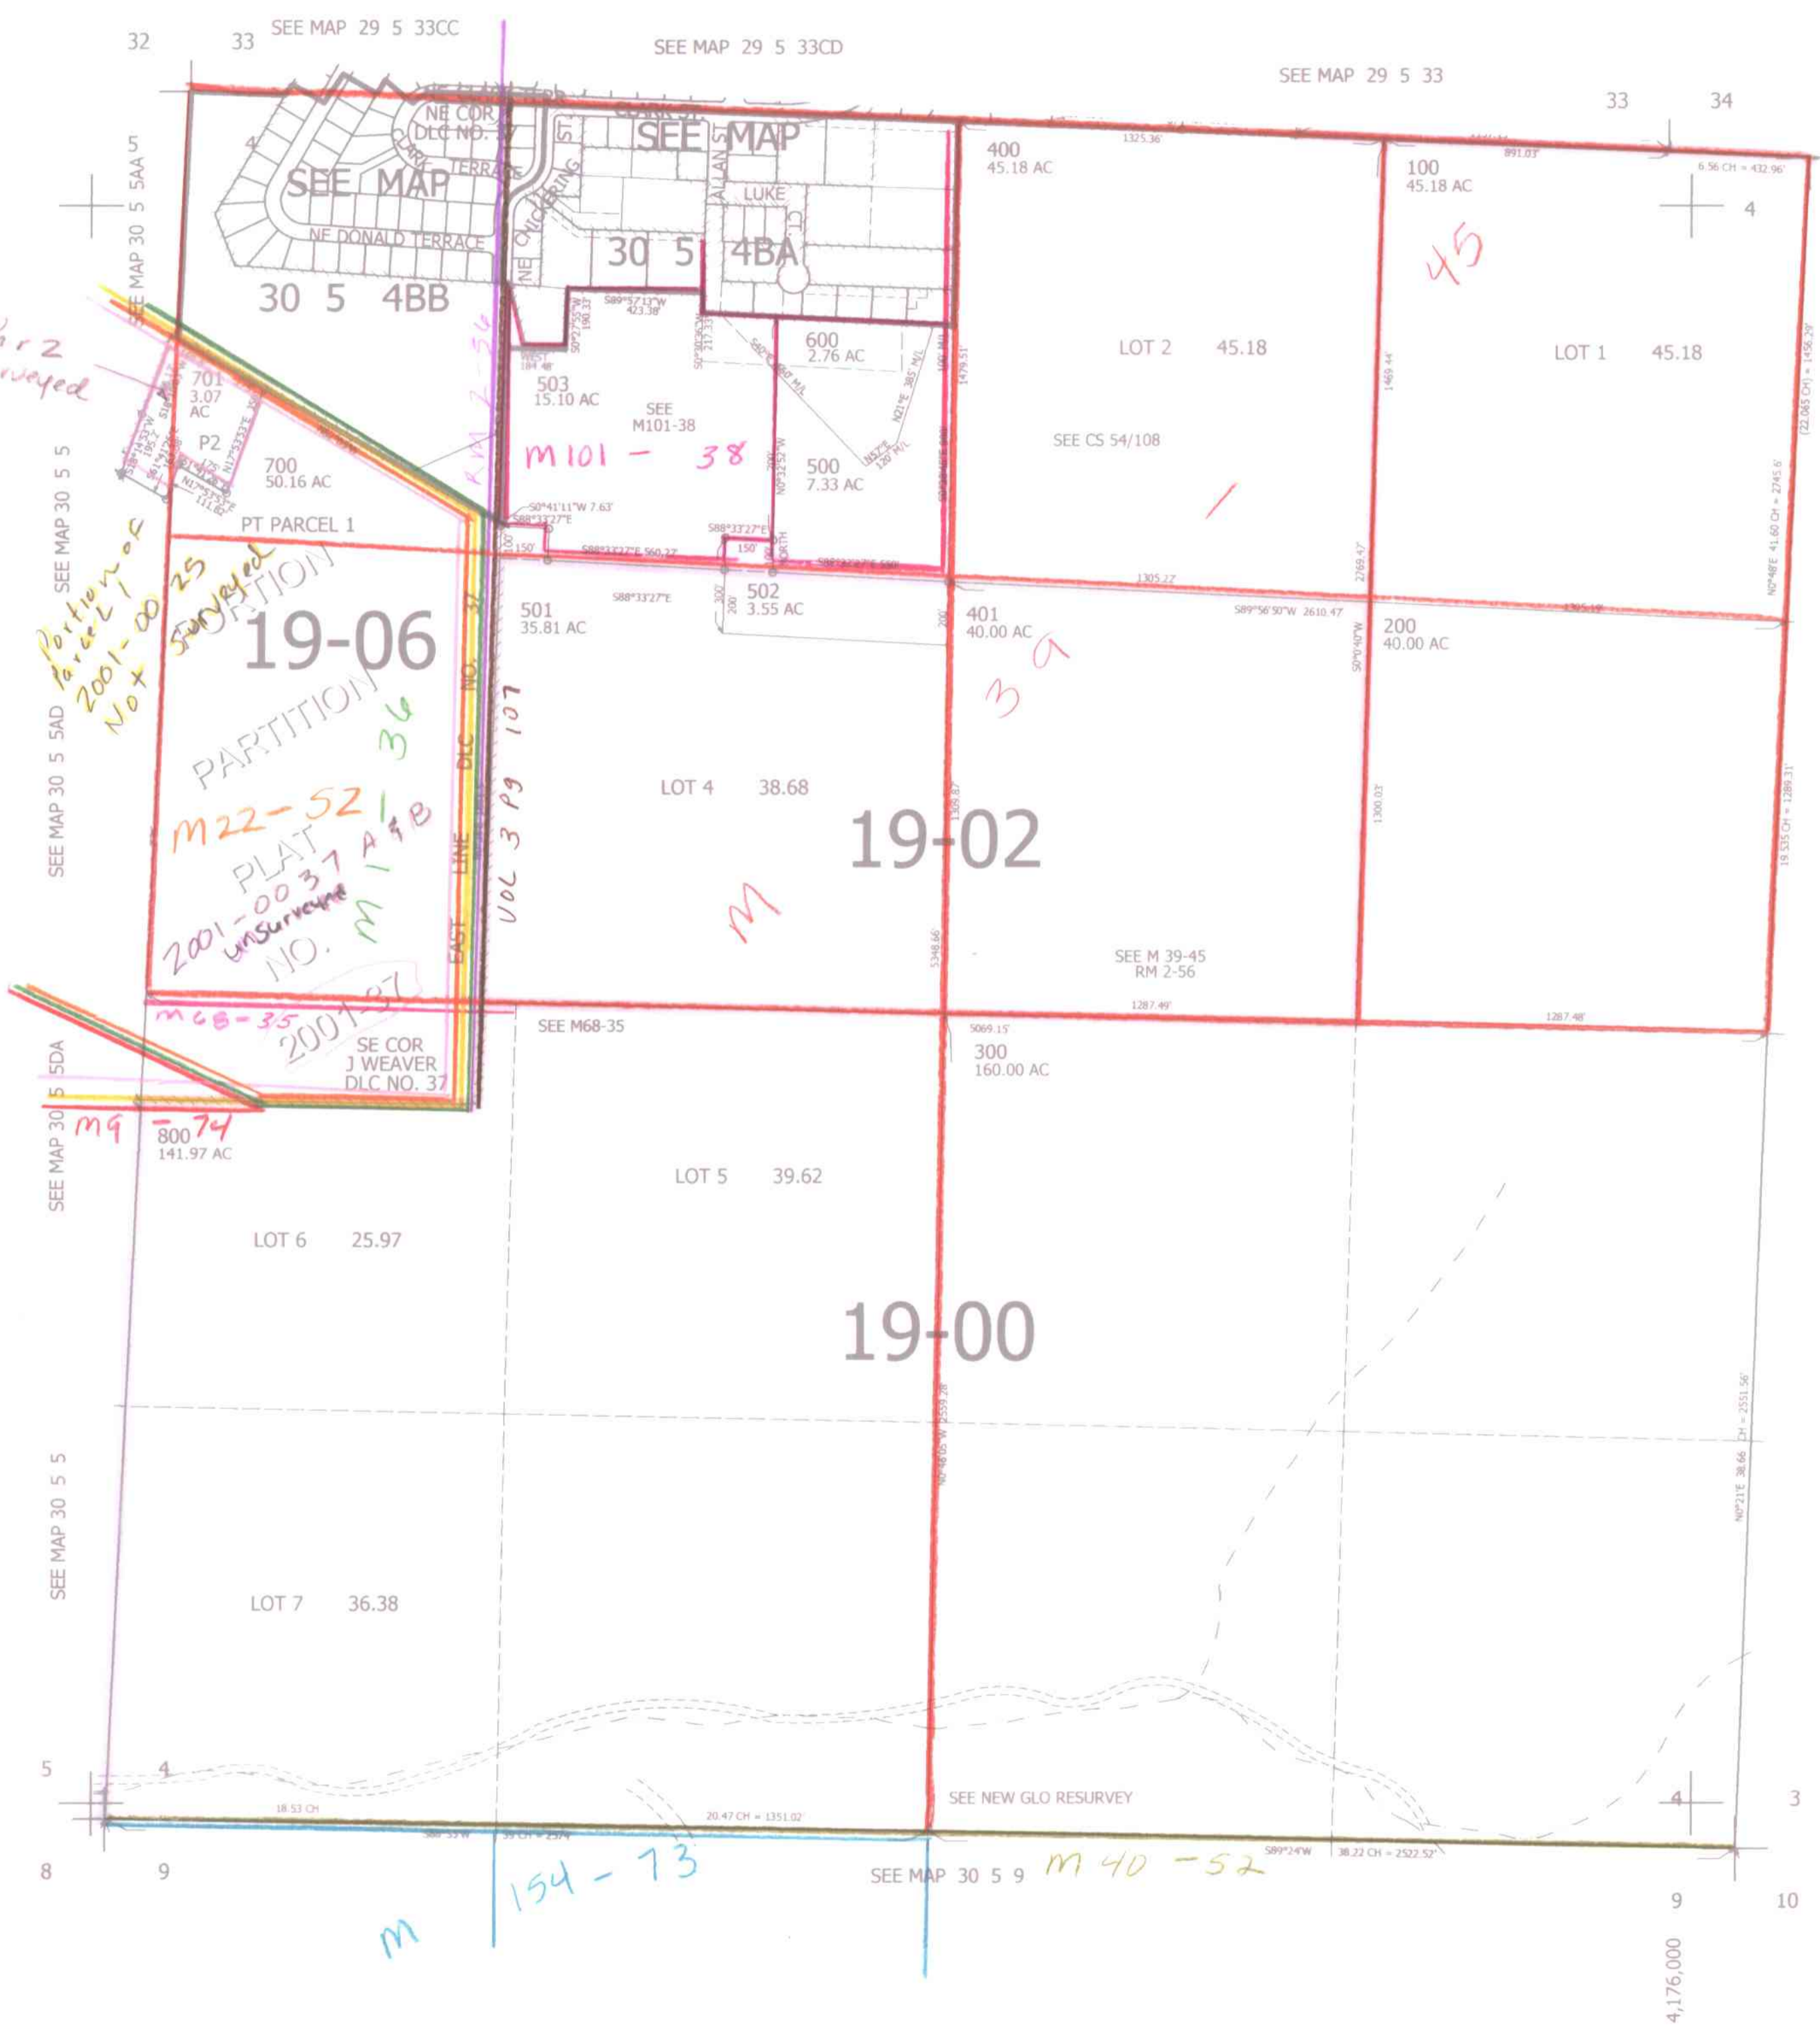

CANCELLED NO'S
601 505

SEE MAP 30 5 3

492,500

30 5 4
& INDEX