

THIS MAP WAS PREPARED FOR ASSESSMENT PURPOSE ONLY.

NE1/4 SEC.20 T30S. R.5W. W.M. DOUGLAS COUNTY

REVISED ON 7-29-13

30 5 20A & INDEX

1" = 200'


SEE MAP 30 5 17DC

SEE MAP 30 5 17DD

17

16

M 16-63

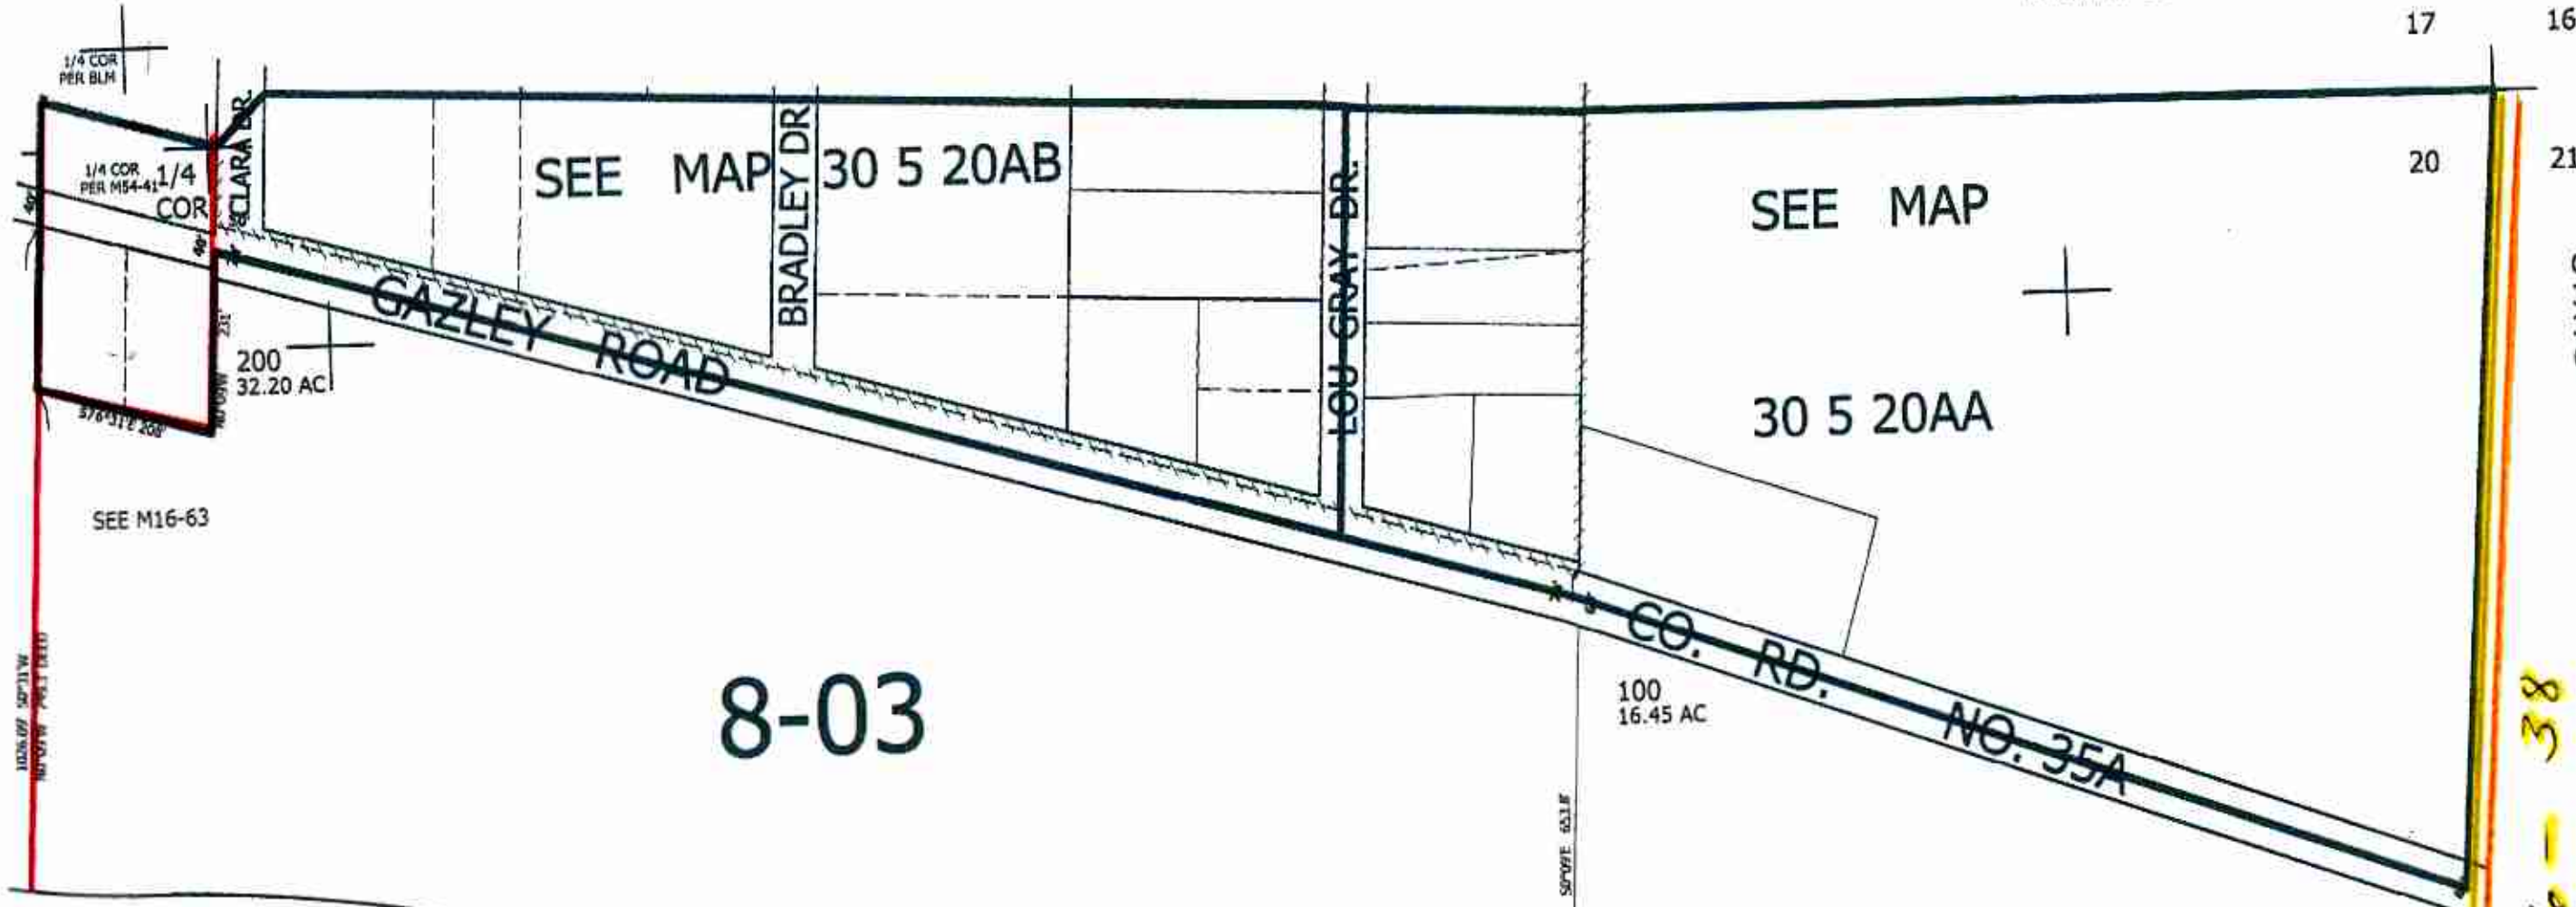


CANCELLED NO'S
301 302 1300
304 800 900
601 602

SEE MAP 30 5 20B



Vol 2
2008-0028A&B
Parcel 3 unsurveyed
PLAT
2008-28

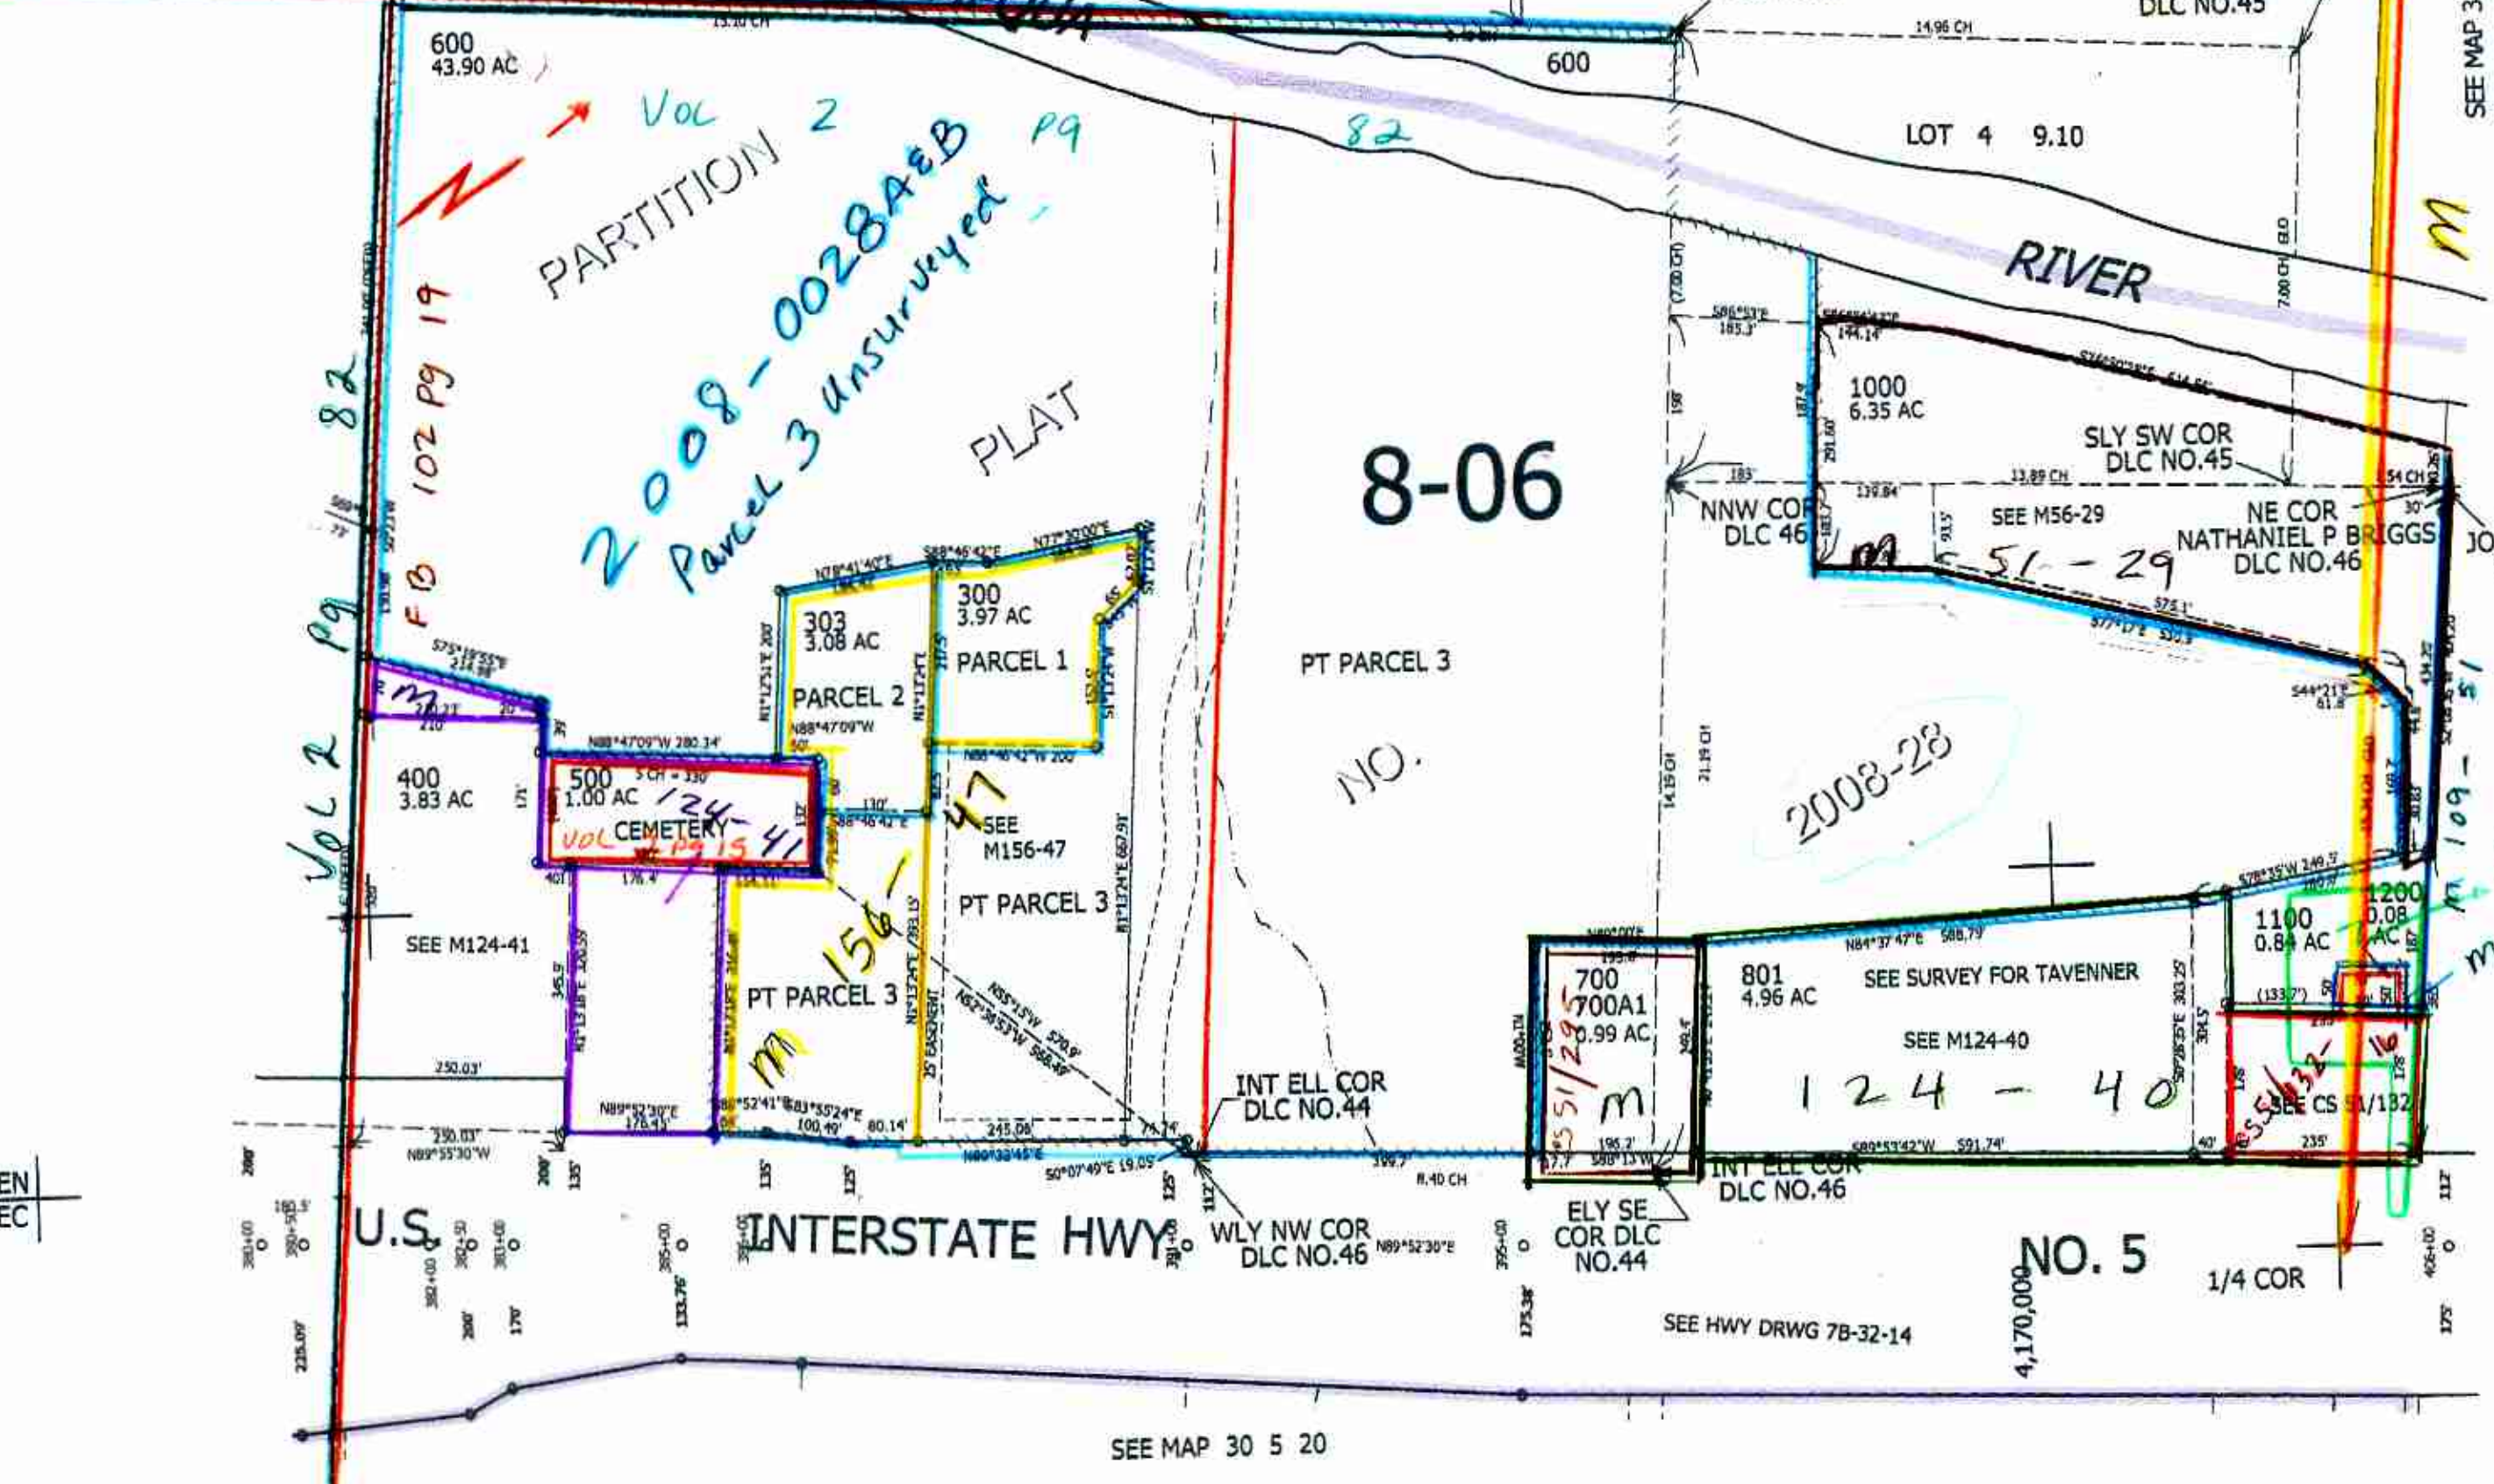

M 146-38
M 112-72 AC

M 109-51
480,000 Y P 35
Vol
M 109-51

30 5 20A & INDEX

SEE MAP 30 5 20