


This map was prepared for assessment purpose only.

SECTION 16 T.30S. R. 6 W. W.M.  
DOUGLAS COUNTY

30 6 16

1"=400

SEE MAP 30 6 9

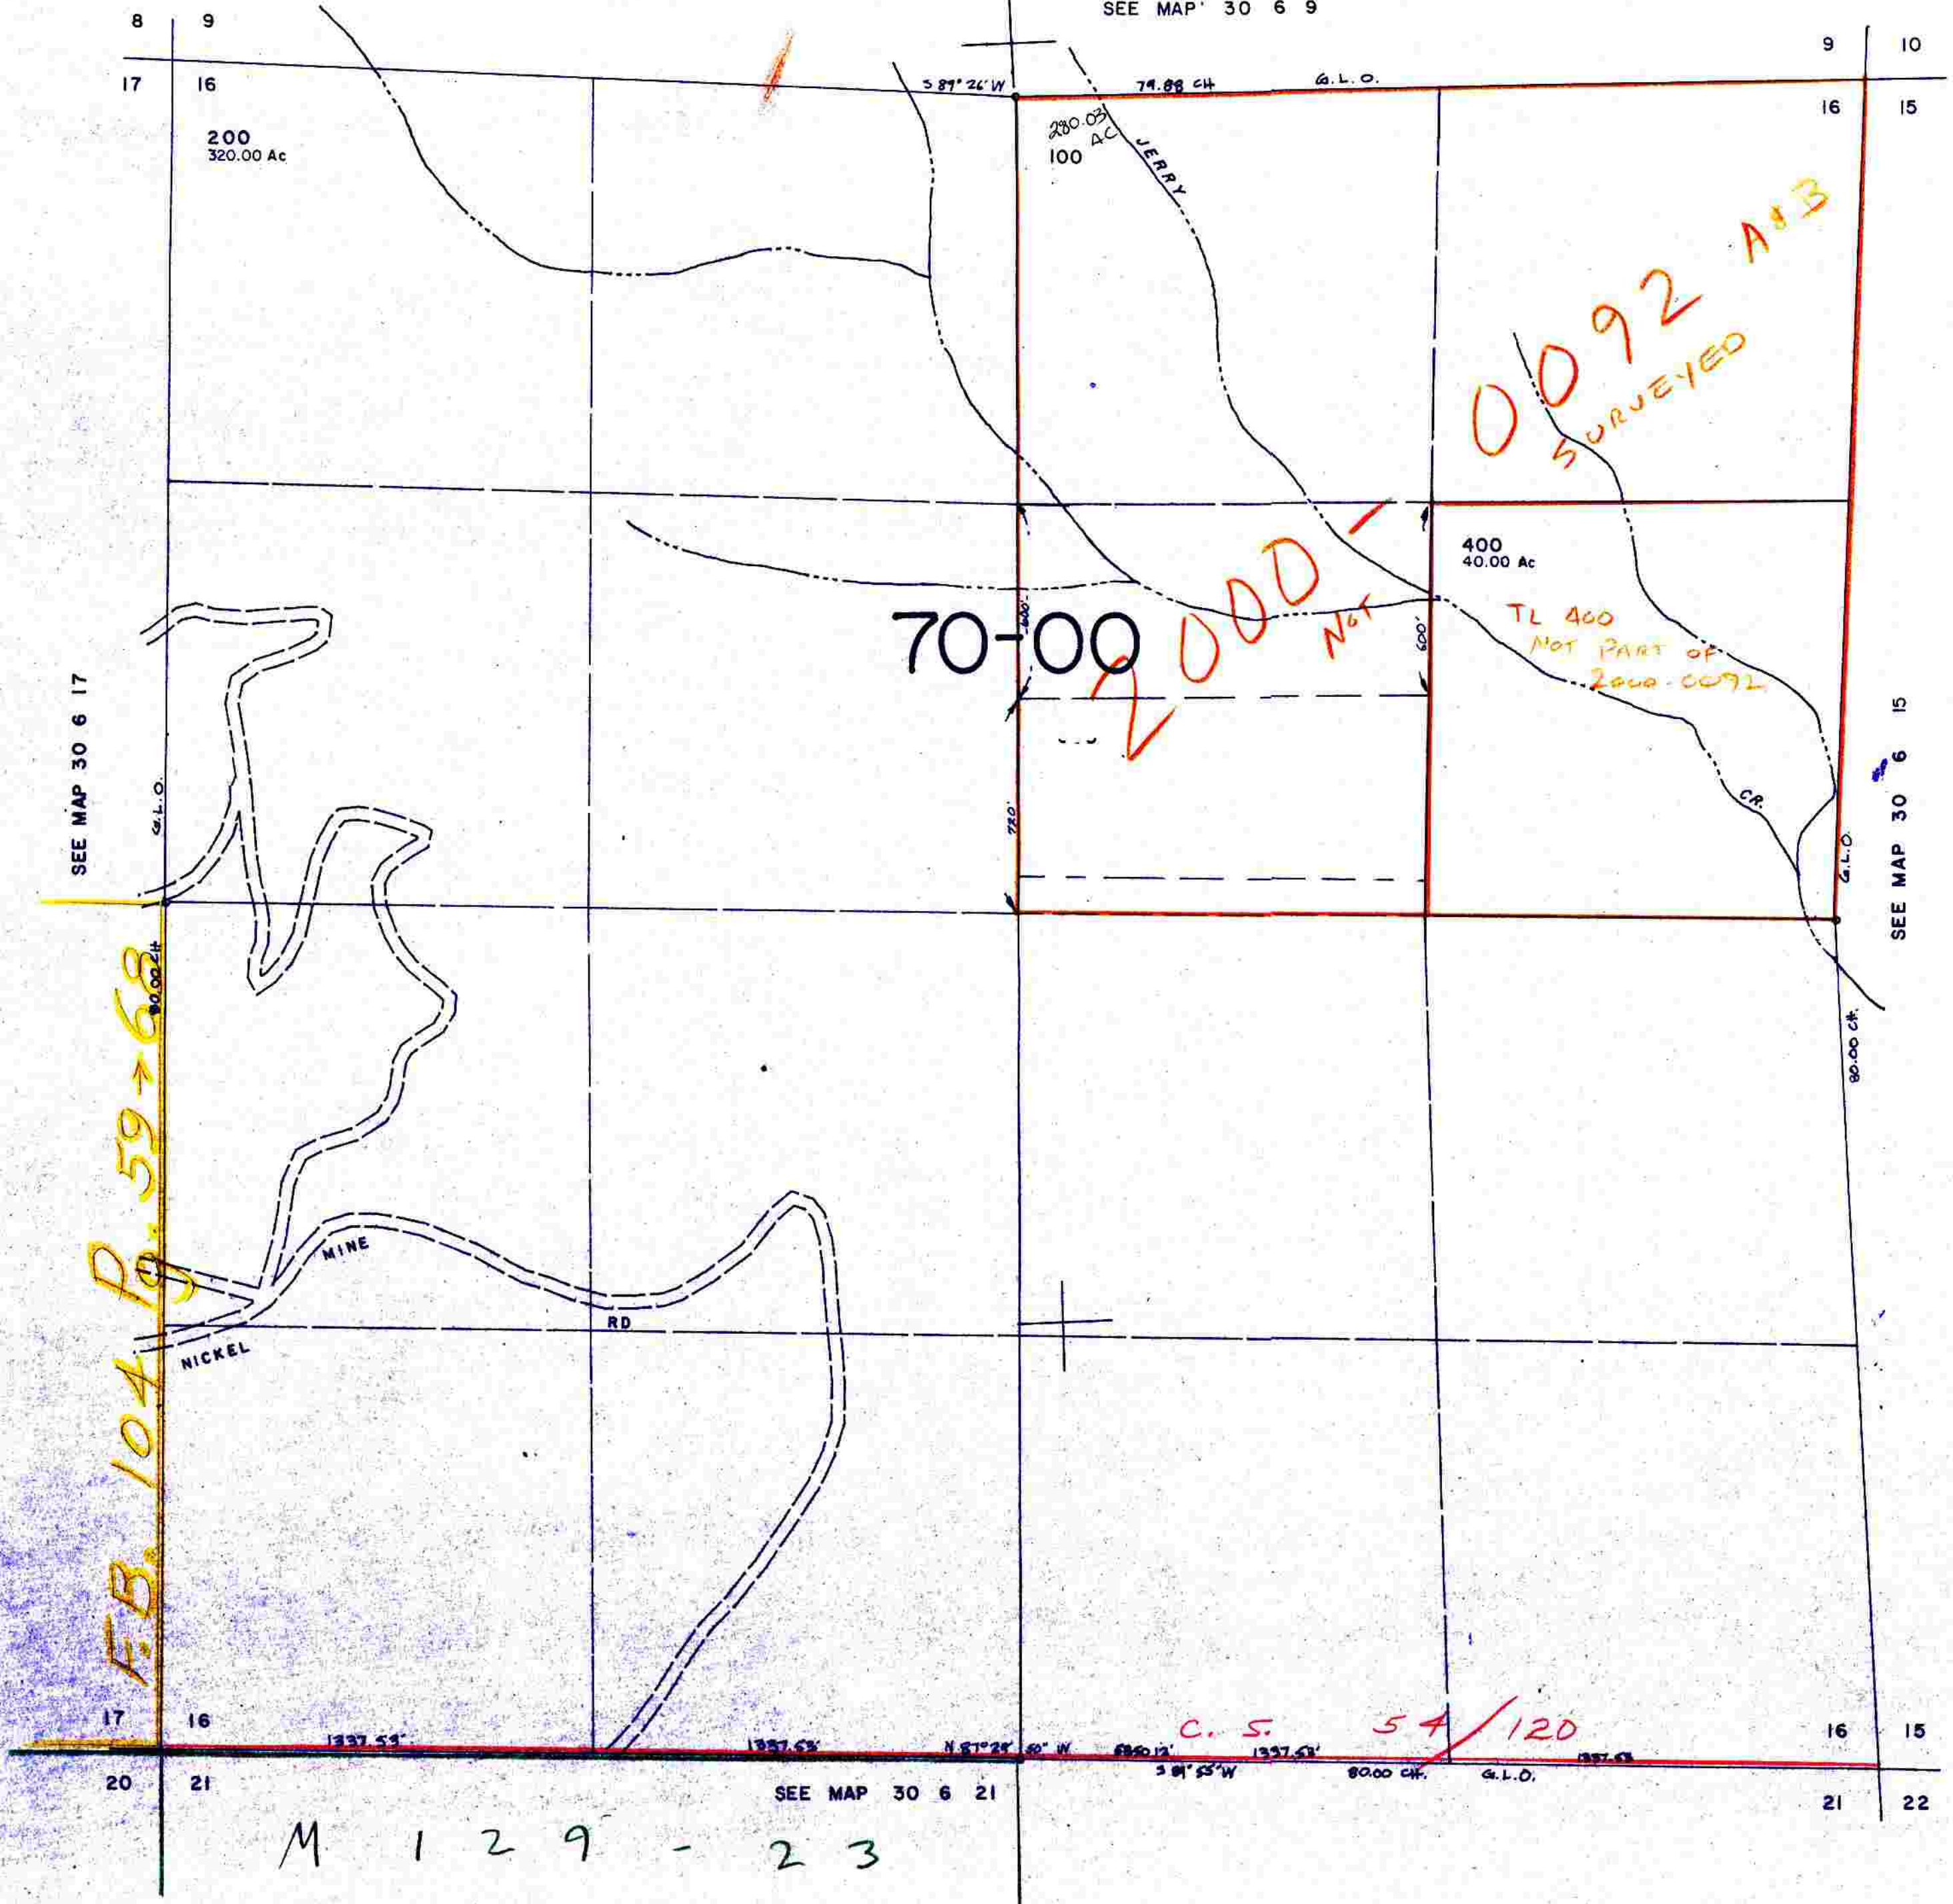

Cancelled  
160 M 1 300 500

485,000

E.B. 104 B. 59-68

70-00  
2000  
NOT

0092 A+B  
SURVEYED

TL 400  
NOT PART OF  
2000-0092

C.S. 54/120

M 129 - 23

30 6 16  
11/83  
BS

1220,000