


SECTION 3 T.31S. R.7W. W.M.
DOUGLAS COUNTY

31 7 3

THIS MAP WAS PREPARED FOR
ASSESSMENT PURPOSE ONLY.

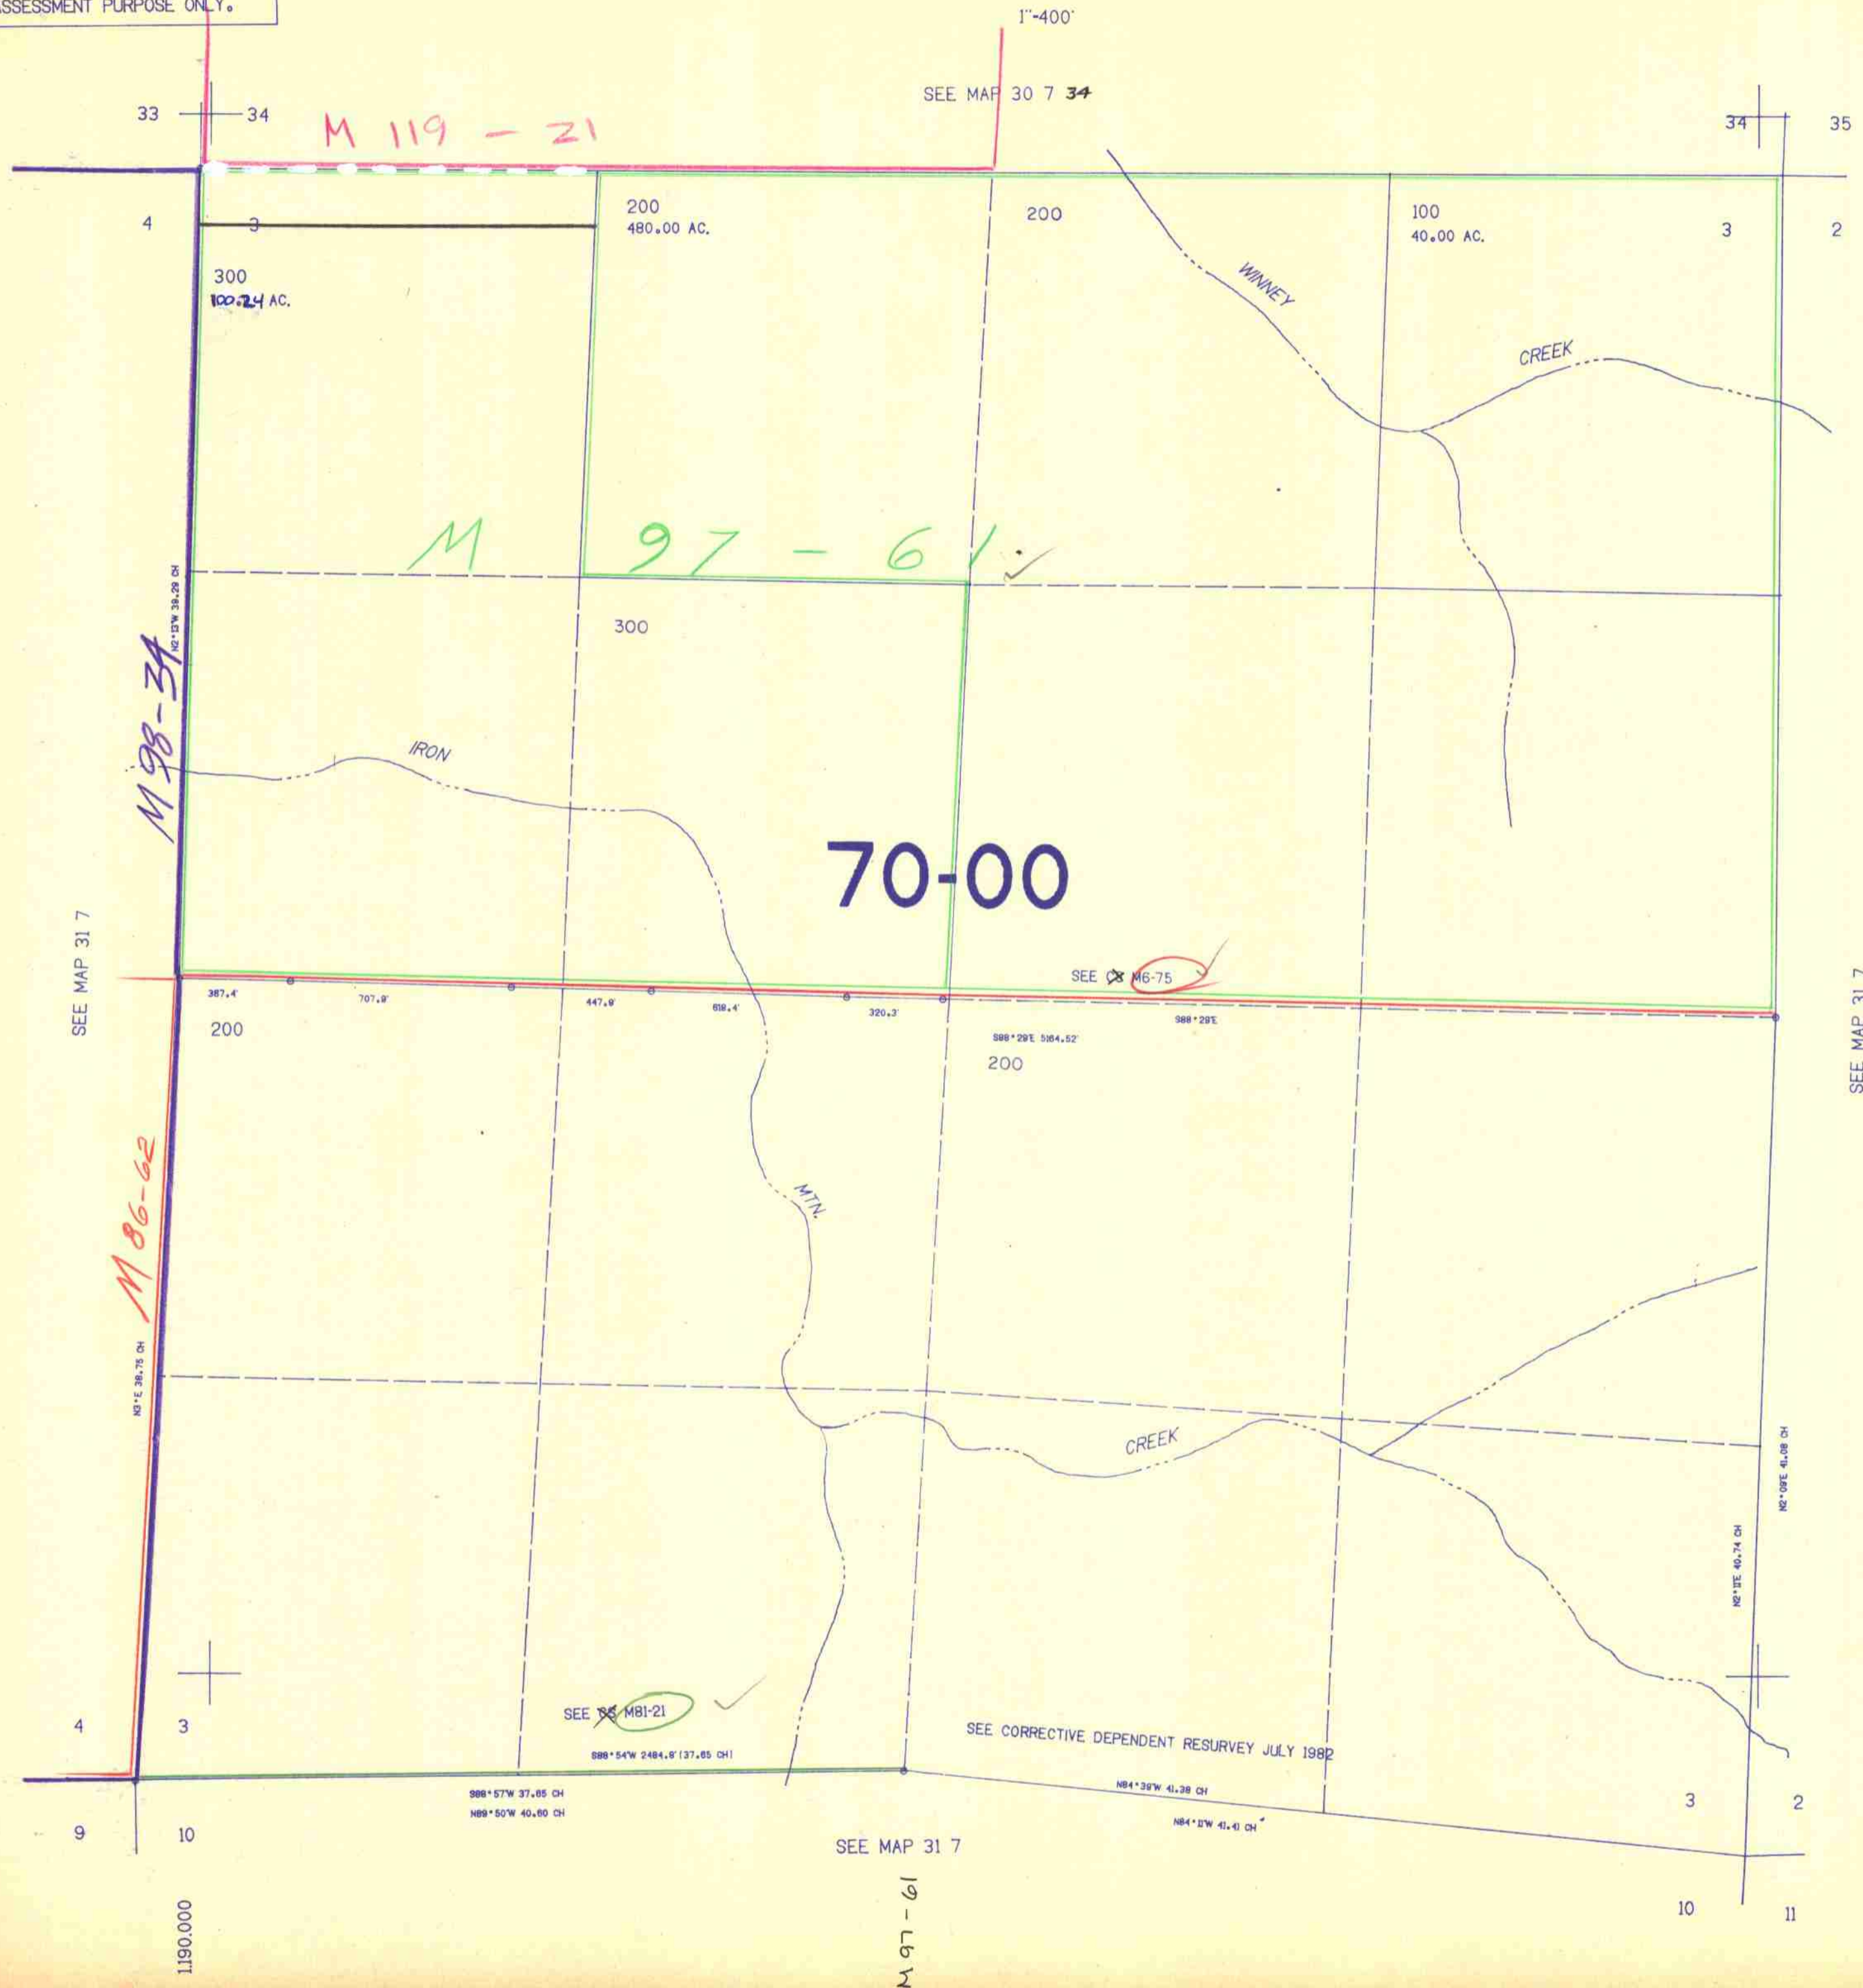

31 7 3
2/84 B2