


SECTION 34 T.31S. R.9W. W.M.
DOUGLAS COUNTY

REVISED ON
10-9-91

31 9 34

THIS MAP WAS PREPARED FOR
ASSESSMENT PURPOSE ONLY.

1"=400'

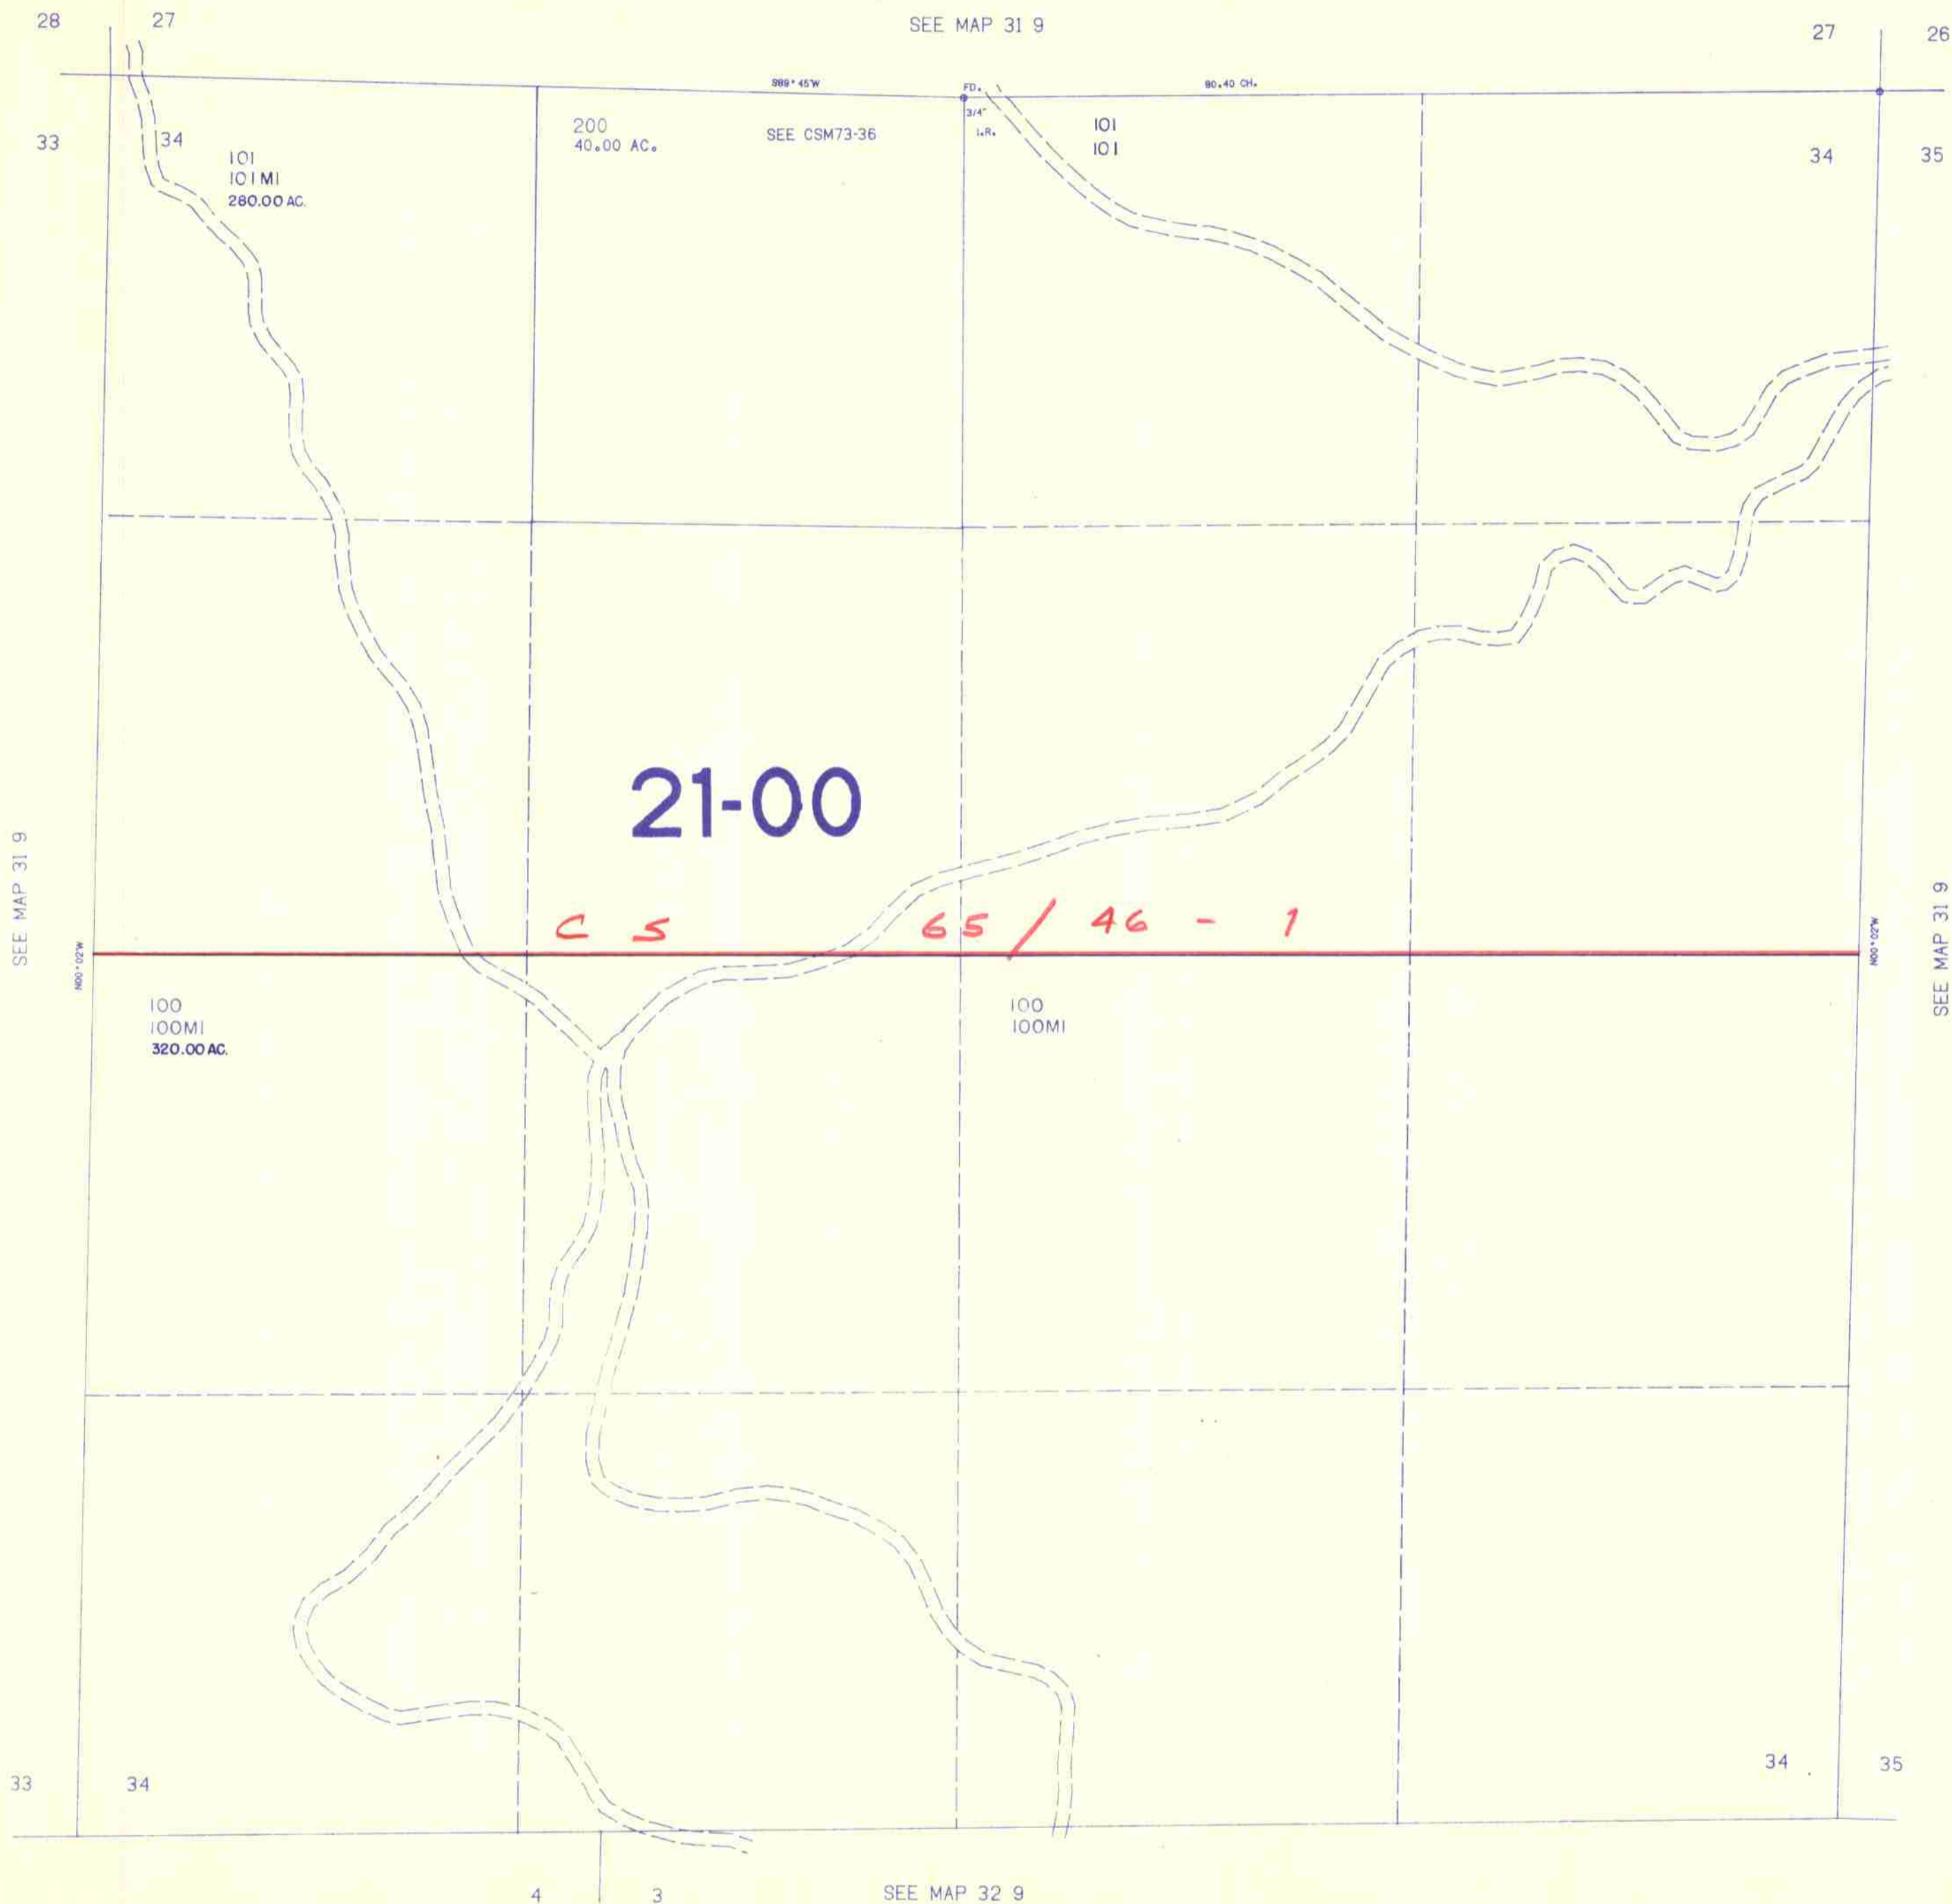

31 9 34

10/91
Camp