


SEC.12 T.32S. R.6W. W.M.
DOUGLAS COUNTY

32 6 12

THIS MAP WAS PREPARED FOR
ASSESSMENT PURPOSE ONLY.

1"=400'

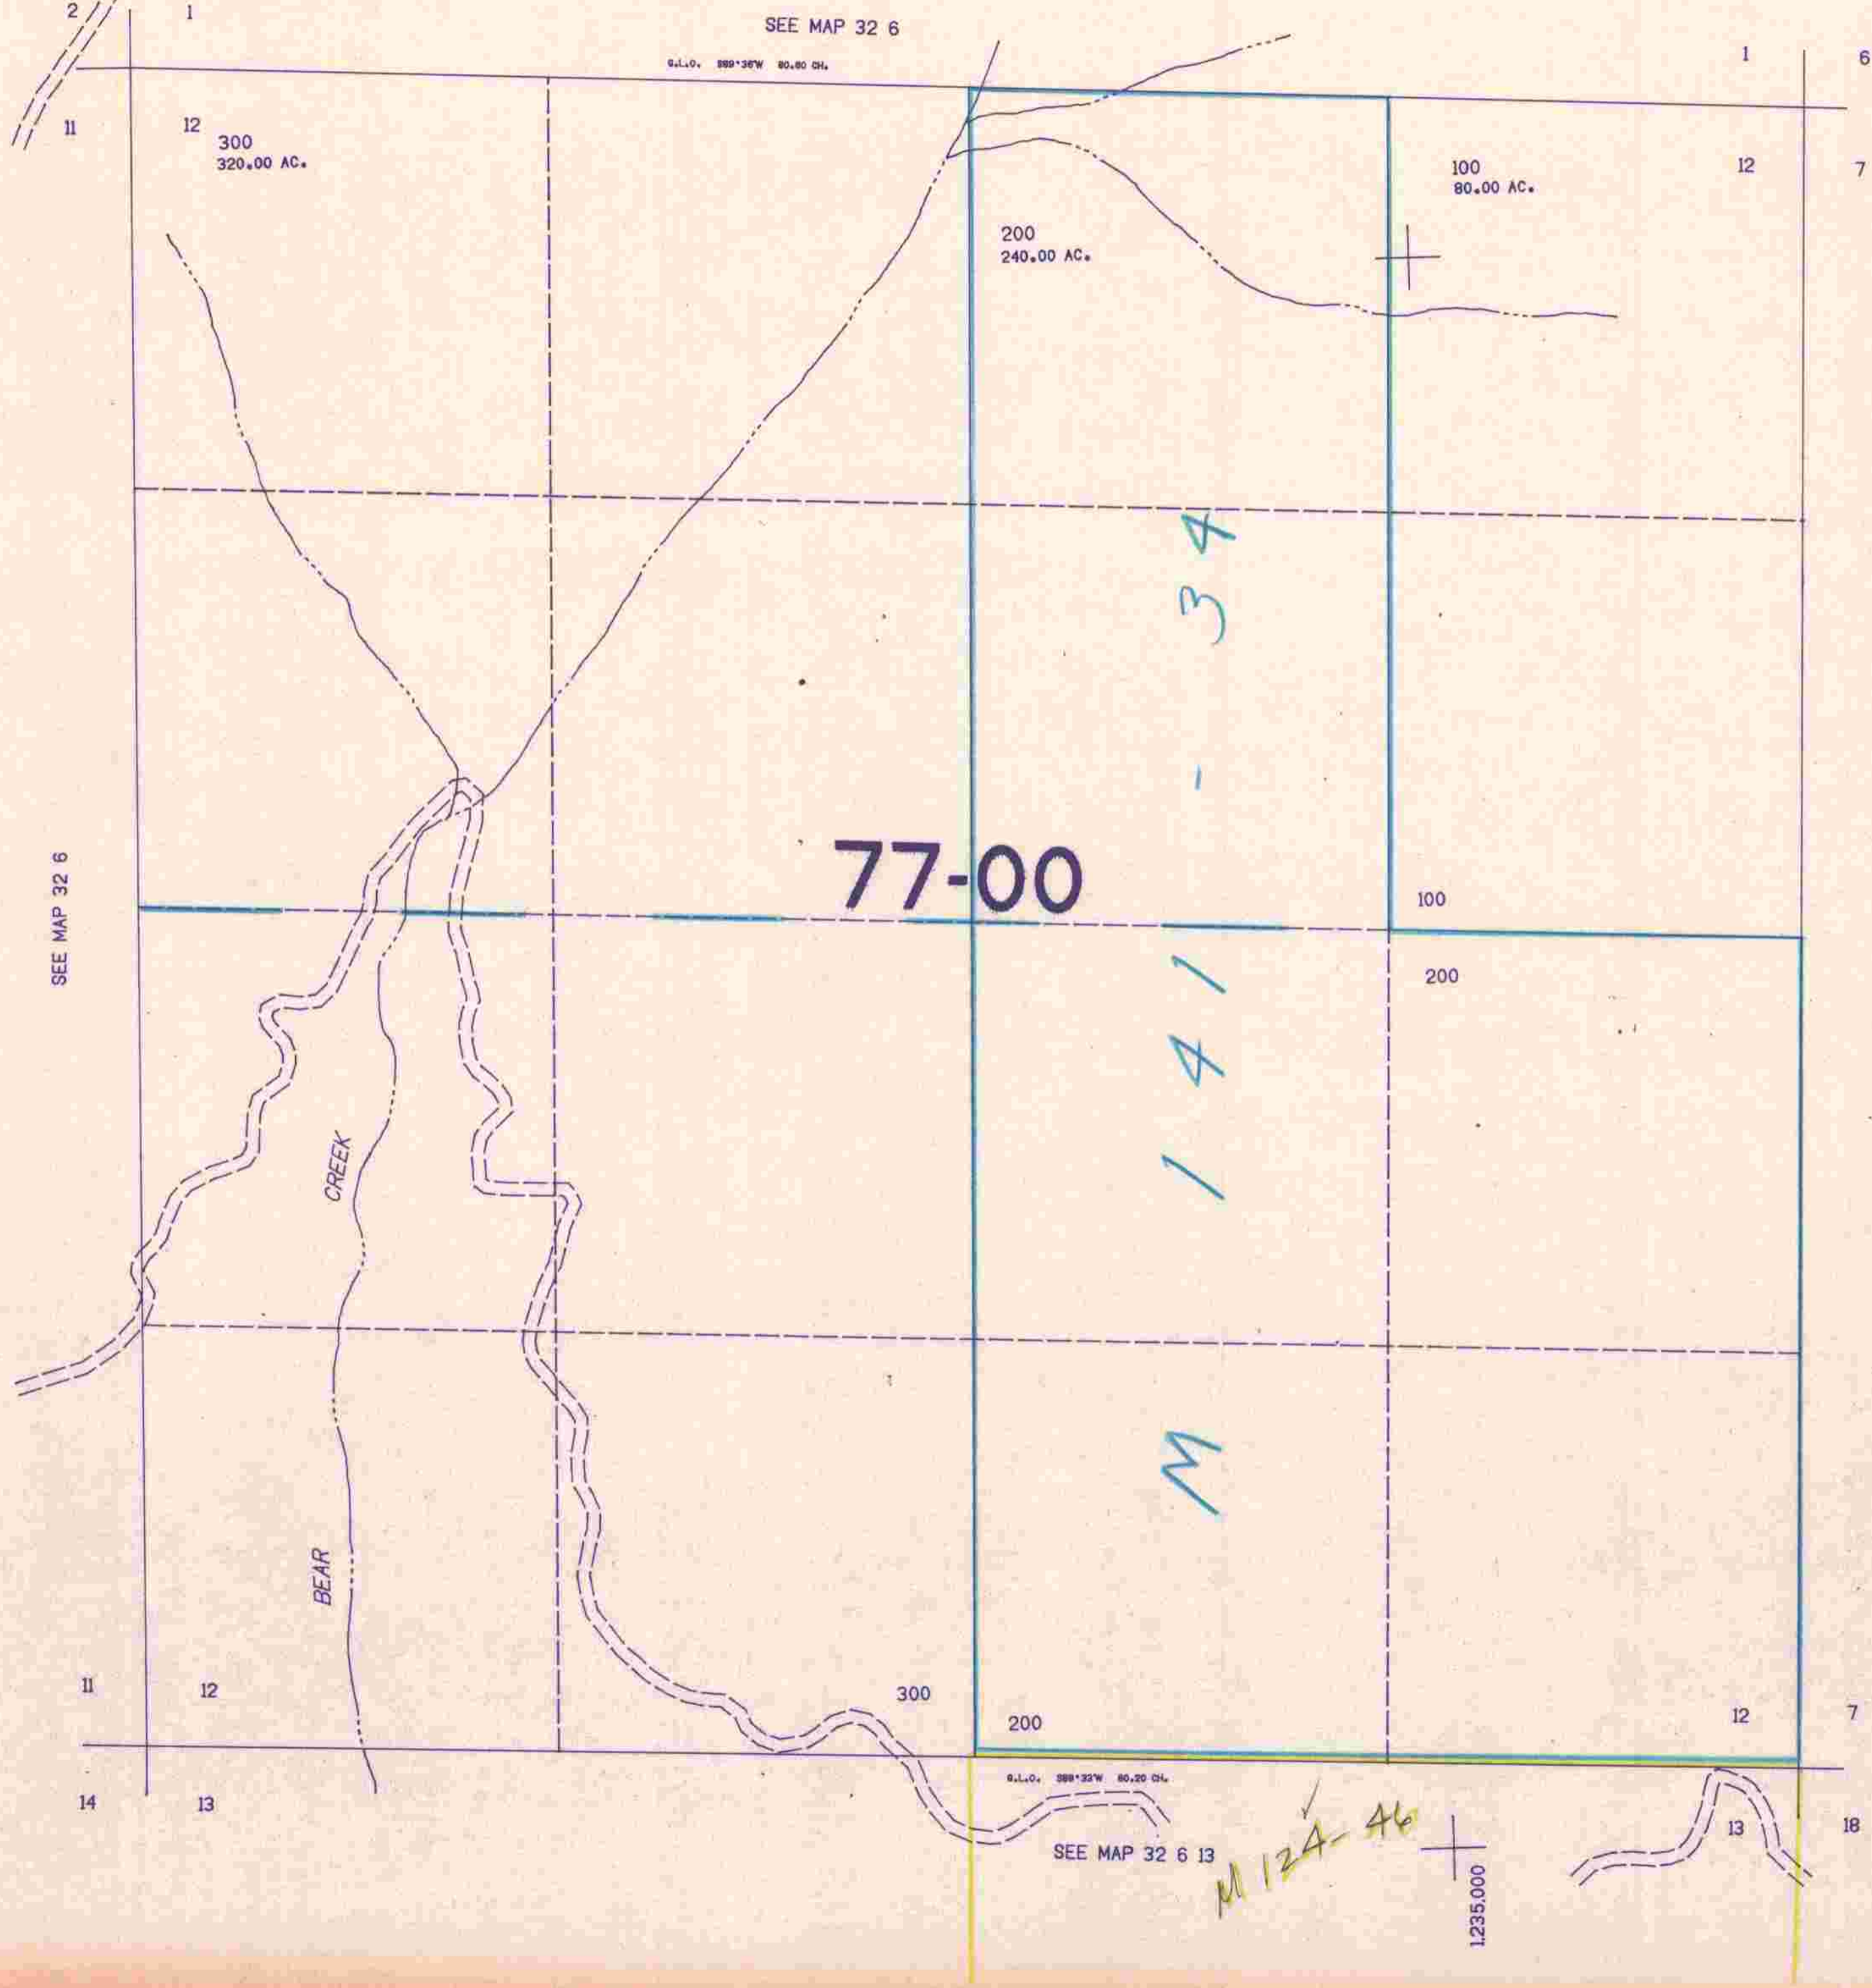

SEE MAP 32 6

S.L.O. 89° 32' W 80.20 CH.

300
320.00 AC.

200
240.00 AC.

100
80.00 AC.

77-00

100

200

CREEK

BEAR

300

200

12

S.L.O. 89° 32' W 80.20 CH.

SEE MAP 32 6 13

M 124-46

1235.000

425.000

32 6 12

10/10/20