


NW1/4 SEC.32 T.32S. R.6W. W.M.
DOUGLAS COUNTY

32 6 32B

THIS MAP WAS PREPARED FOR
ASSESSMENT PURPOSE ONLY.

1"=200'

SEE MAP 32 6

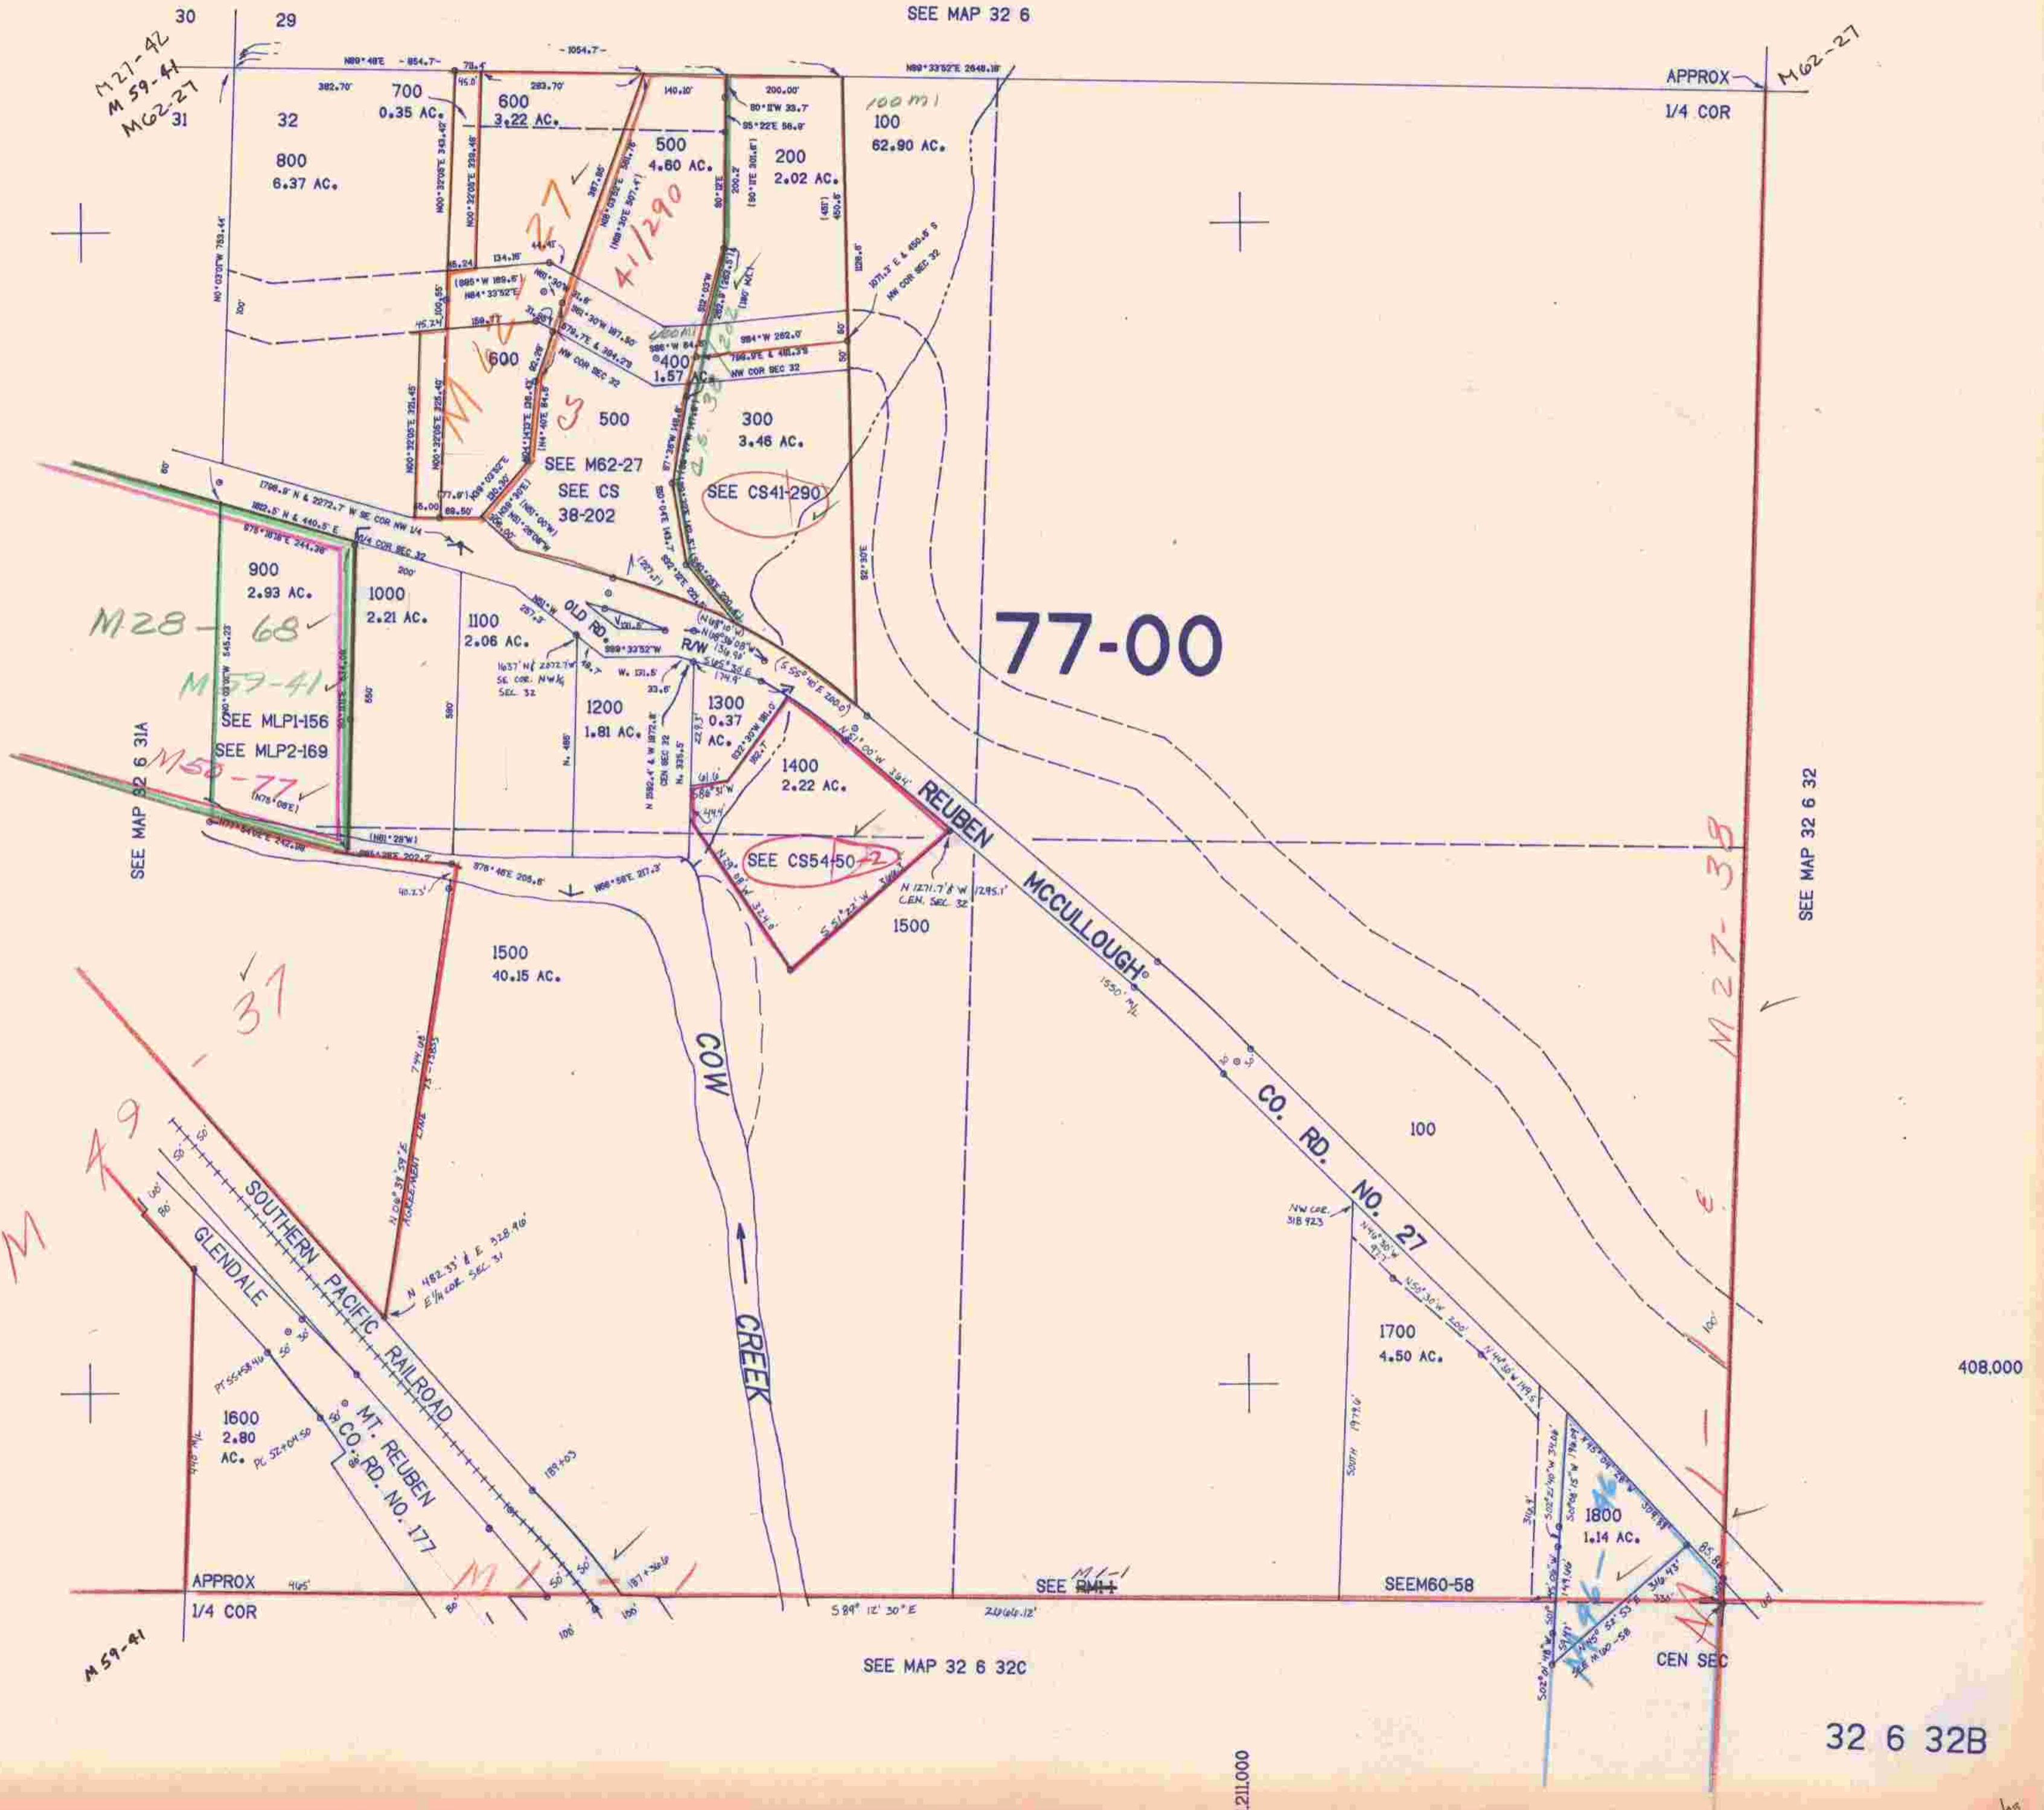

SEE MAP 32 6 32

SEE MAP 32 6 32C

32 6 32B

0001171

11/85
2/1