


SE1/4 SEC.34 T.32S. R.6W. W.M.
DOUGLAS COUNTY

32 6 34D

THIS MAP WAS PREPARED FOR
ASSESSMENT PURPOSE ONLY.

1"=200'

APPROX
CEN SEC

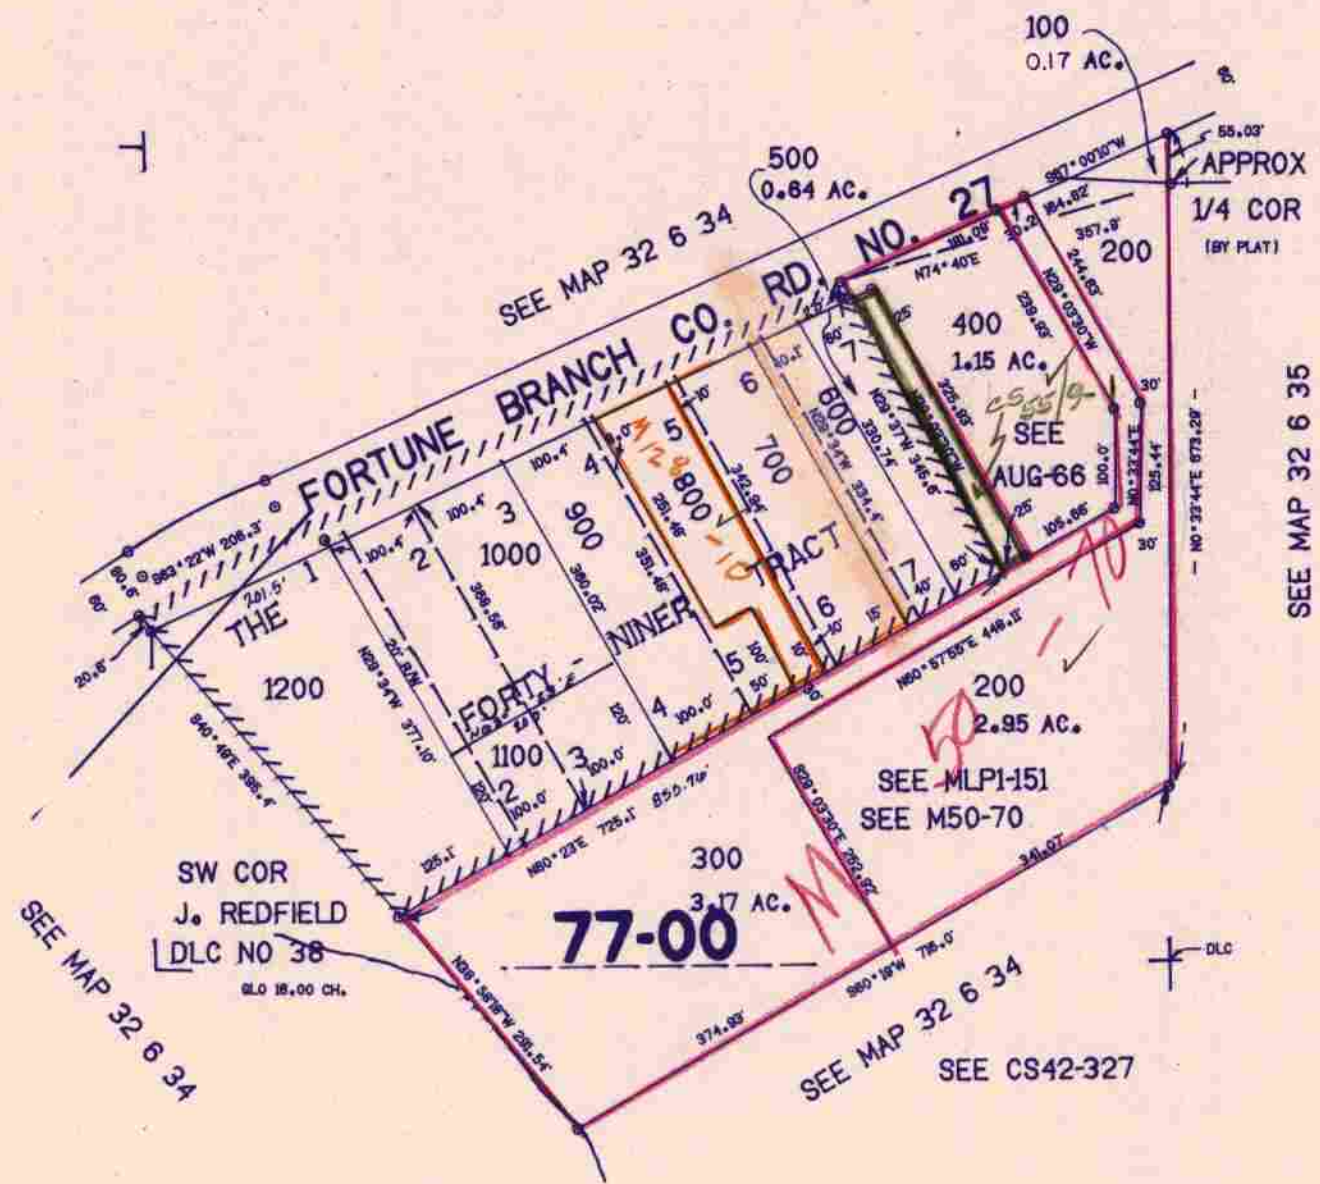

SEE MAP 32 6 35

SEE MAP 32 6 34


SEE MAP 32 6 34

SEE CS42-327

SEE MLP1-151
SEE M50-70

405.000

APPROX
1/4 COR

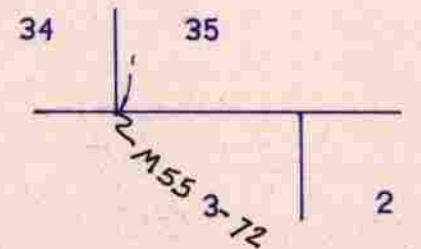

32 6 34D

1225.000

12/03
DR