


THIS MAP WAS PREPARED FOR
ASSESSMENT PURPOSE ONLY

SW/4 NE/4 SEC. 5 T.33S. R.6 W W.M.
DOUGLAS COUNTY

REVISED ON
3-16-99
6-2-03

33 6 5AC
GLENDALE

1"=100'

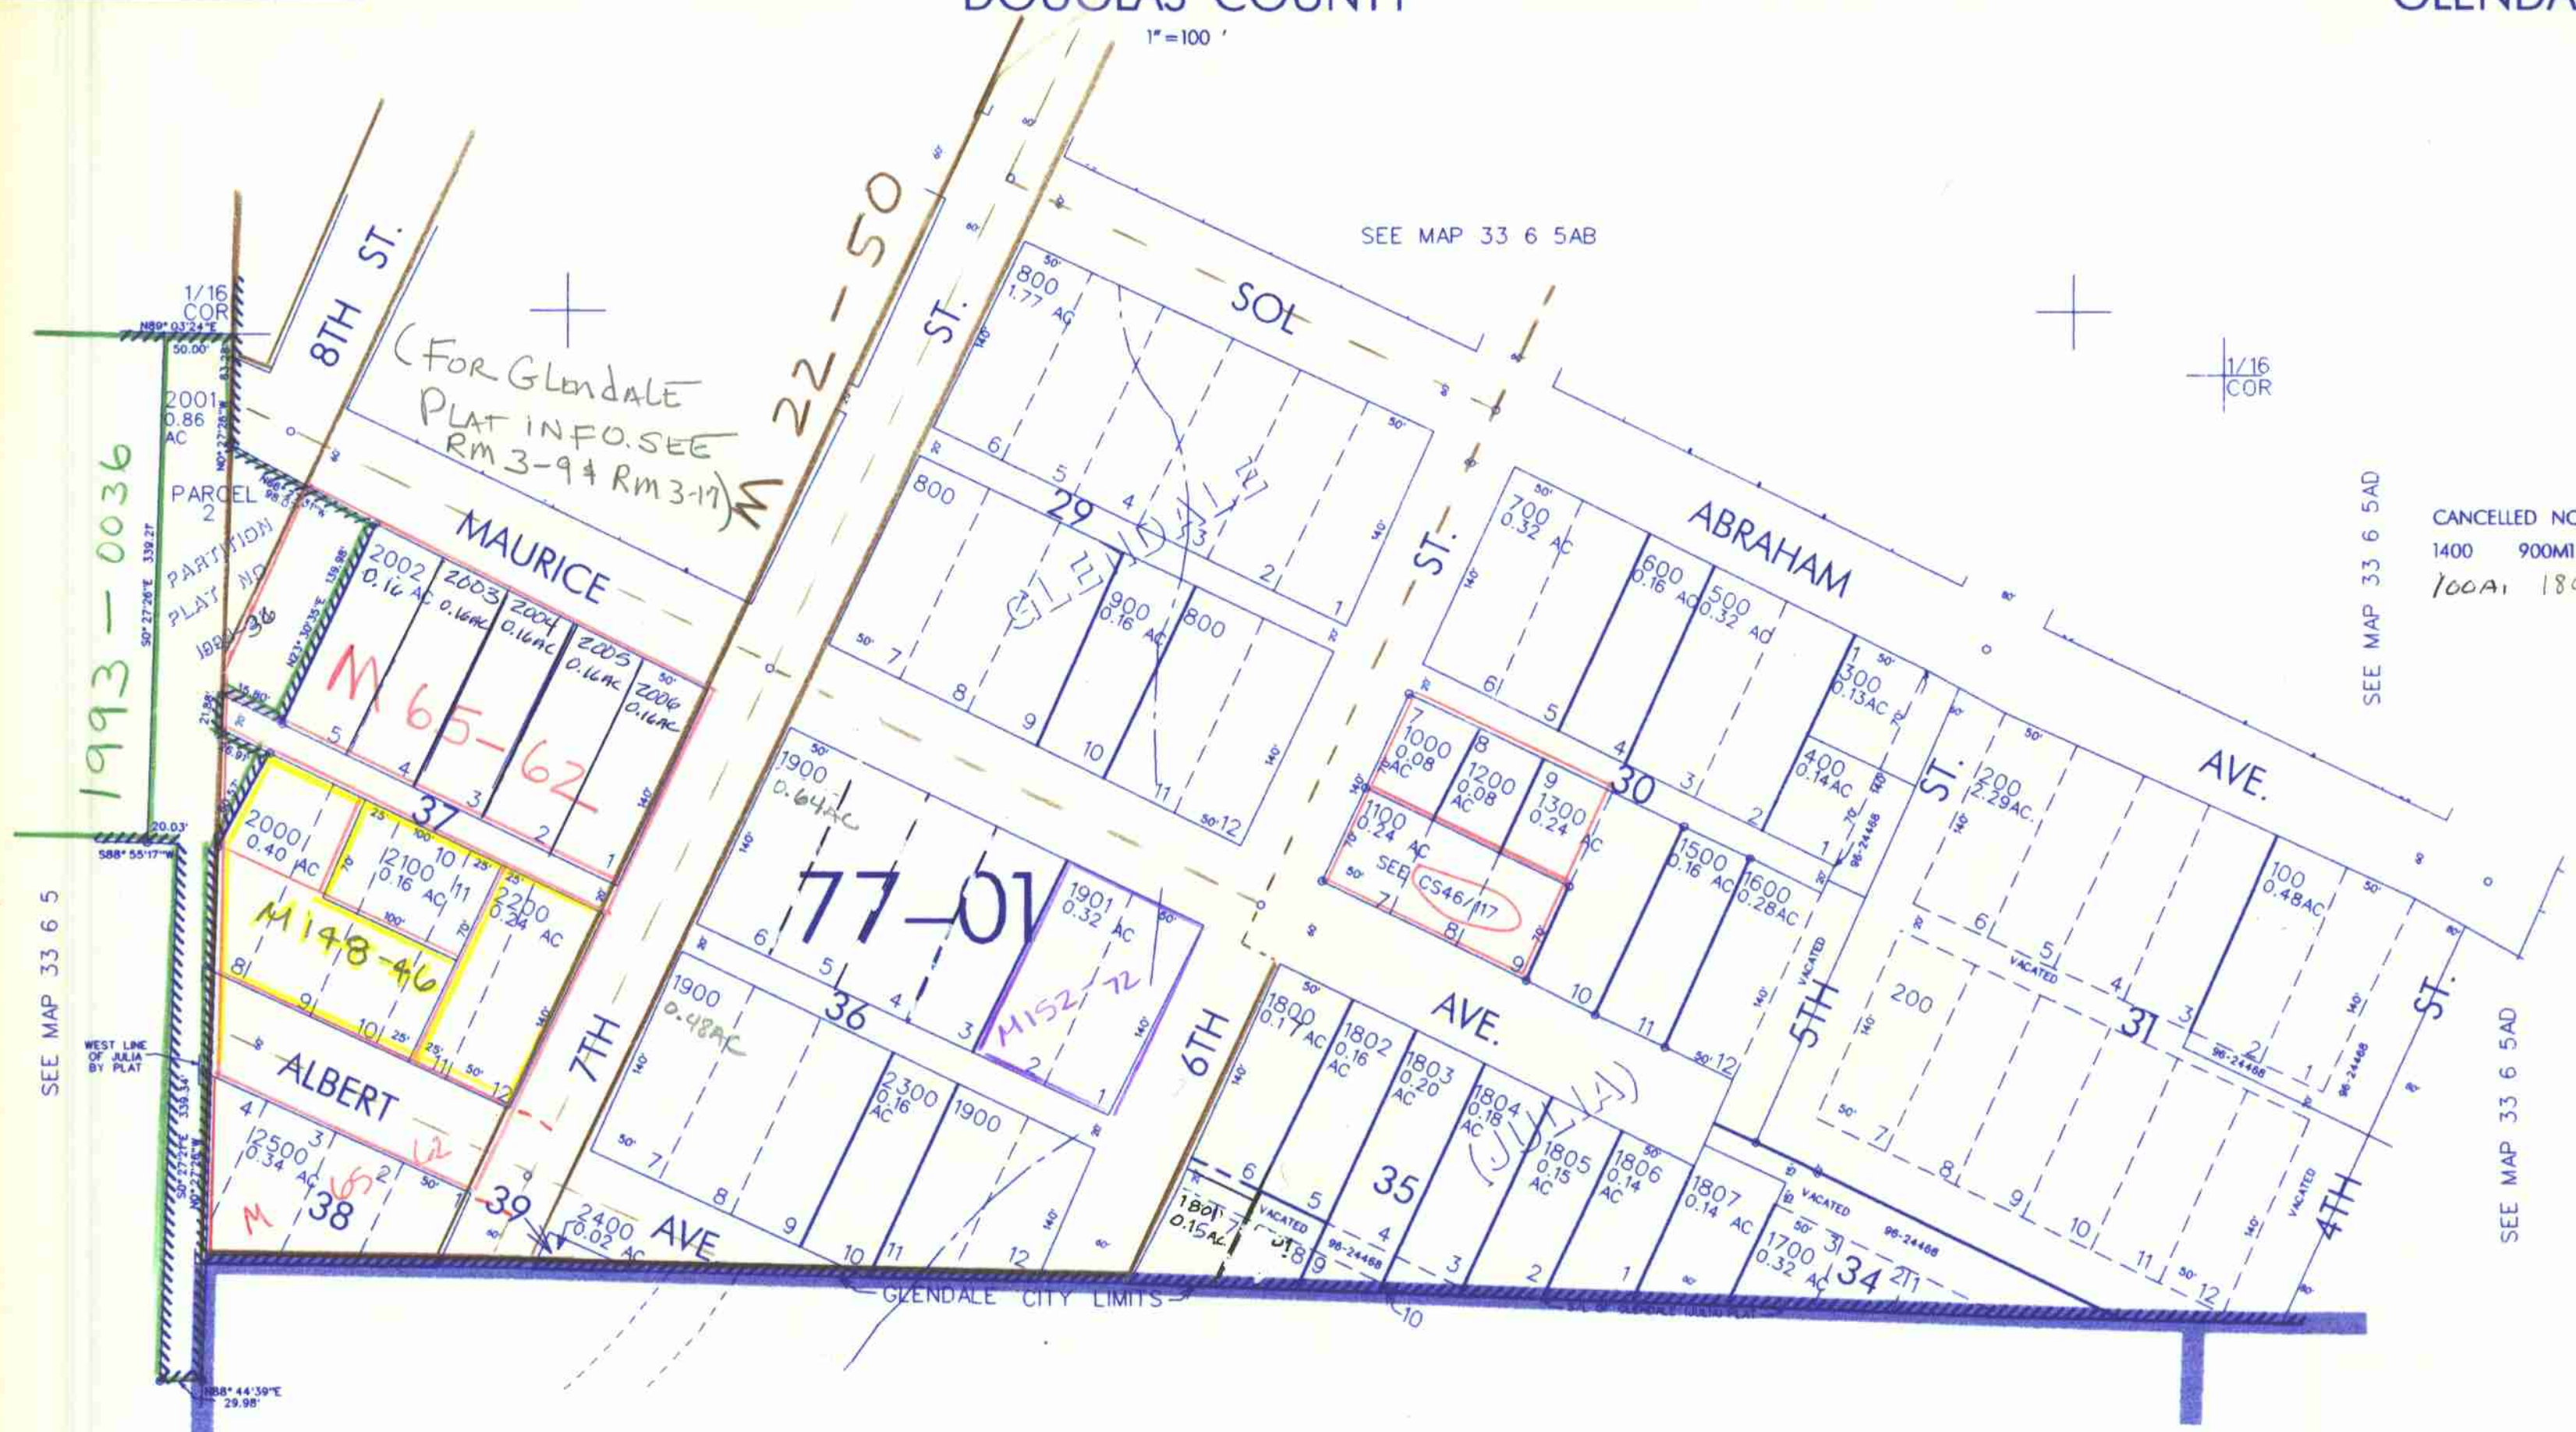

1993-0036

SEE MAP 33 6 5

WEST LINE OF ALIA BY PLAT

SEE MAP 33 6 5AB

SEE MAP 33 6 5AD

CANCELLED NO'S
1400 900MI 1808
100A, 1809 1810

SEE MAP 33 6 5AD

SEE MAP 33 6 5

402,500

CEN
SEC

4,134,000

1/16
COR

33 6 5AC
GLENDALE

NW 5/99