

TOWNSHIP 20 RANGE 11 POINT IDENTIFIER # 540300

PRIMARY CORNER DESCRIPTION 1/4 Cor. for Secs. 23 and 26

Alias _____	Description _____
Alias _____	Description _____
Alias _____	Description _____
Alias _____	Description _____

GLO Survey by Wm. Thiel under Contract #342 dated Oct. 6, 1879 - (DCSO records Vol. 1 Page(s) 97)

-----  
Set ¼ sec. post, from which  
    An Alder 14" dia., bears N.79¼°W., 139 lks. dist.  
    A Hazel 4" dia., bears West, 50 lks. dist.

Survey by Robert W. Ward - For: Champion International - Sept. 1981 - M 89-58 and C.S. File 58/260

-----  
Found no trace of original corner.  
Set 3½" USFS alum. cap on a 2½" x 30" alum. pipe at point of proportionate measure., from which  
    10" Alder bears N.6°52'W., 33.6 ft. (1981) bark scribed "¼ S23 BT"  
    14" Alder bears S.52°03'E., 52.4 ft. (1981) bark scribed "¼ S26 BT"

Survey by Harvey Wilcox - For: U.S. Forest Service - Dec. 1990 - M 111-47 A-F

-----  
Found - 3" alum. cap on 2½" alum. pipe.  
    16" Alder bark scribed, bears S.52°E., 52.4 ft.  
    11" Alder bark scribed, bears N.7°W., 33.6 ft.  
New Accessories:  
    12.5" Alder, bark scribed "T20S R11W S ¼ S23 BT", with tags and washer, bears N.47°E., 24.97 ft.  
    10.5" Alder, bark scribed "T20S R11W N ¼ S26 BT", with tags and washer, bears S.50°W., 47.15 ft.  
Set standard U.S.F.S. disk mkd. "RM N ¼ S26 N.0°19'W 50.98' 1990 RLS 2244", bears S.0°19'E., 50.98 ft.  
Distances are to side center of bearing trees.

Jerry Estabrook - Crew: Patrick Coy, John Rondeau, and Daniel Tiemissen - 6/26/2022 - C.S. 65/111-4


-----  
Found - A 2½" alum pipe w/an 3½" alum cap mkd Set per M89-58  
          USDA FOREST SERVICE  
          T20S R11W  
          ¼ S23  
          S26  
          1981  
          PLS 1091  
          UNLAWFUL TO DISTURB  
BTs - A 20" alder w/visible scribe bears N.47°E., 24.97', added a tag.  
      A 21" alder w/visible scribe on a rotten stump bears S.52°03'E., 52.4'. Continued next page

TOWNSHIP 20 RANGE 11 POINT IDENTIFIER # 540300

PRIMARY CORNER DESCRIPTION 1/4 Cor. for Secs. 23 and 26

Alias \_\_\_\_\_ Description \_\_\_\_\_  
Alias \_\_\_\_\_ Description \_\_\_\_\_  
Alias \_\_\_\_\_ Description \_\_\_\_\_  
Alias \_\_\_\_\_ Description \_\_\_\_\_

- A 17" alder w/visible scribe and tag bears S.50°W., 47.15'.
- B0s - Rotten remains of 11" alder bears N.6°52'W., 33.6'
- A carsonite post bears N.90°E., 2.2'.
- RM - A carsonite post bears S.0°W., 2.0'.
- A 2½" alum pipe with an alum cap marked: (cap upside down markings right side up) "UNLAWFUL TO DISTURB, RM, N¼ S26, N0°19'W, 1, 50.98', 1990, RL 2244" and set per M111-47.

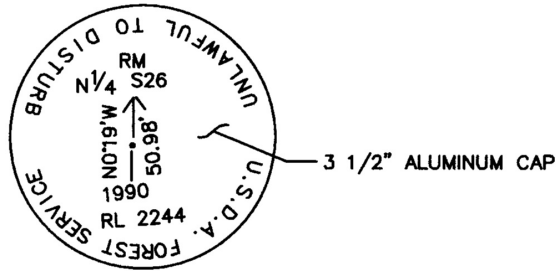

Note - Compass Declination 18° East  
Lat. and Long. per GARMIN ETREX handheld GPS  
N.43°48'36.8" W: 123°58'36.9"