

PRIMARY CORNER DESCRIPTION NE. Cor. for Sec. 1 (NE Tsp. Cor)


Alias _____ Description _____
 Alias _____ Description _____
 Alias _____ Description _____
 Alias _____ Description _____

GLO survey by Wm. Thiel, Deputy Surveyor, under Contract #567, dated Feb. 16, 1891 (DCSO records Vol. 1 Page(s) 323)

 At point of intersection (105 lks. S. of ¼ sec. cor. bet. secs. 31 & 36) I set a sandstone 8x8x8 ins., 5" in the ground for closing cor. to sec. 36, T20S R9W and Sec. 1, T21S R9W, marked CC with 6 notches on N., S., and W. edges; and raised a mound of stone, 1½ ft. high, 2 ft. base, alongside. Pits impracticable.

BLM Resurvey by Thomas A. Tillman and Joseph S. Gawron, Cadastral Engineers, under Group #306, surveyed May 1953/Oct. 1954 - (DCSO records Vol. 29 Page(s) 12455-56)

 Intersect the W. bdy. of Sec. 31, T20S R8W., at proportionate point (latitudinally) for the closing cor. of Tps. 20 & 21., R9W, there is no remaining evidence of the original corner. Set an Iron post 3 ft. long, 3" dia., 28" in the ground with brass cap mkd.

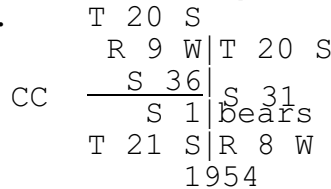

from which

A Cedar 10" dia., bears N.65°W., 67 lks. dist. mkd. T20S R9W S36 CC BT.

A Fir 18" dia., bears S.31¼°W., 55 lks. dist. mkd. T21S R9W S1 CC BT.

(From this point, the ¼ sec. cor. of sec. 31, T20S R8W bears N.1°27'E., 1.03 chs. dist.)

Fd. OK and used in BLM resurvey by Peter A. Peterson, Cadastral Surveyor, under Group #'s 350 & 511, surveyed Apr. 1966/May 1967 (DCSO records Vol. 34 Page(s) 14215)

Dependent resurvey by Edith M Forkner, Cadastral Surveyor, under Group #2286, surveyed Oct. 2009 - (DCSO records Vol. 56 Page(s) 22336)

 The closing cor. of Tps. 20 & 21 S., R. 9 W., on the W. bdy. of T20S R8W reestablished by proportionate measurement by Tillman and Gawron in 1953-54, and utilized by Peterson in 1966-67; monumented with an iron post, 3" dia., firmly set, projecting 4" above ground, with a brass cap (properly) mkd. from which the remains of the BTs mkd. by Tillman and Gawron

A fir, 40" dia., bears S.31¼°W., 36.3 ft., with a healed blaze.

continued next page

TOWNSHIP 21 RANGE 09 POINT IDENTIFIER # 700700

PRIMARY CORNER DESCRIPTION NE. Cor. for Sec. 1 (NE Tsp. Cor)

Alias _____	Description _____
Alias _____	Description _____
Alias _____	Description _____
Alias _____	Description _____

A decayed cedar stump, 14" dia., bears N.65°W., 44.2 ft., with a healed blaze. Stump is partially uprooted and a new bearing tree
A W.Fir, 8" dia., bears N.51½°W., 11.4 ft., mkd. T20S R9W S36 CC BT.
A steel fence post is alongside the cor.
Corner is located E., 110 ft., of a creek, 2 ft. wide, course N.30°E.