

TOWNSHIP 22 RANGE 05 POINT IDENTIFIER # 700300

PRIMARY CORNER DESCRIPTION Sec. cor. for 24 & 25; 19 & 30, T22-4

Alias _____ Description _____
Alias _____ Description _____
Alias _____ Description _____
Alias _____ Description _____

GL0 survey by Gordon and Gardner, under Contract #52 dated Feb. 17, 1855 (DCS0 records Vol. 3 Page(s) 1334)


Set post, cor. of secs. 19, 24, 25 and 30, from which
A Fir 20" dia., bears N.31°E., 39 lks. dist.
A Fir 10" dia., bears N.52°W., 33 lks. dist.
A Fir 18" dia., bears S.44°W., 13 lks. dist.
A L.Oak 4" dia., bears S.79°E., 49 lks. dist.

O.F. Thiel - For: Fred Lee - June 26, 1948 - F. Bk 5 Page 23

Stone 6x7x16 with cross. Find post & NW tree, N.52°W. 33 lks
Marked: W.Oak 5", N.15°E., 11 ft.
B.Oak 10" S.15°W., 27 ft.

Douglas Co. Surveyors Office - James Byron, Deputy - Crew,
S.A. Bilow - April 22, 1959 - C.S. File 49/59-30

Found - Orig. 10" now 28" Fir stump. I open and find good
scribing, "S", N.52°W., 21.8 ft.
I find no trace of other orig. BTs.
This corner was renewed years ago by Thiel, not
recorded. (See above report)
Thiel set 5" x 6" x 15" stone with + on top at
corner and barks scribed orig. NW BT, "24".
Thiel also scribed B.Oak, bears S.16°W., 27.7 ft.
Corner is under E-W fence.
Set Brass cap at cor. alongside corner stone, mkd:
County Surveyors Office

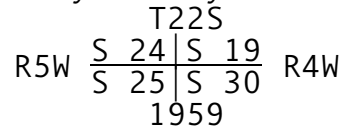

New BTs -5" R.Fir bears N.25°W., 31.0 ft. scribed S24 T22S
R5W CS BT.
8" R.Fir bears N.20°E., 49.5 ft. scribed S19 T22S
R4W CS BT.
10" B.Oak bears S.16°W., 27.7 ft. Thiel's BT, partly
grown over, I add scribe CS.
6" R.Fir bears S.30°E., 26.1 ft. scribed S30 CS BT.

Douglas Co. Surveyors Office - Milo E. Godfrey, Deputy -
crew, V. Tracy and M. Stone - July 1963 - C.S. File 49/59-41

Found - DCS0 brass cap and Thiel's rock at corner.
5" D.Fir N.25°W., 31.0 ft. alive and in good
condition. (Cont. Next Page)

TOWNSHIP 22 RANGE 05 POINT IDENTIFIER # 700300

PRIMARY CORNER DESCRIPTION Sec. Cor. for 24 & 25; 19 & 30, T22-4

Alias _____	Description _____
Alias _____	Description _____
Alias _____	Description _____
Alias _____	Description _____

8" D.Fir N.20°E. 49.5 ft. alive & in good condition.
6" D.Fir S.30°E., 26.1 ft. alive & in good condition
The SW BT is now down.
New BT - 7" D.Fir S.6½°W., 41.0 ft. mkd. T22S R5W S25 CS BT.

Cor. Fd. and used in BLM resurvey by Berry and Akin, under contract #812, surveyed Aug/Sept. 1973 (DCSO records, Vol. 36 Pages 15057-58)

Douglas Co. Surveyors Office - Gregory Quibell, Deputy - T. Plouff, crew - Feb. 9, 1982 - C.S. File 61/30-13

Found - 1959 DCSO brass cap properly mkd., set firmly in ground protruding 4" out of ground.
Stone set by Thiel with "+" on top, mentioned by Byron, just East of brass cap. Stone protrudes 4" out of ground.
Orig. 10" now rotted 28" Fir stump previously opened bears N.52°W., 21.8 ft Scribing no longer visible
6" now 13" Fir bears S.32°E., 26.1 ft. (Rec. S.30°E.) with well healed double blaze.
7" now 13" Fir bears S.4½°W., 41.0 ft. (Rec. S.6½°W) with well healed double blaze.

All other BTs have been destroyed by recent logging.
Due to wire fence and 2 steel fence posts being within approx. 2 ft. of brass cap, all of my compass bearings were taken on lines projected back approx. 10 ft. from brass cap.
New BT - 15" Fir scribed "T22S R4W S30 CS BT" in double blaze bears S.63°E., 54.6 ft. (Sketch in C.S. File)

Fd. OK, Mar 1997 by K. Hoffine - M 124-47
Fd. OK, Feb. 1998 by D. Edwards - M 128-35
Fd. OK, Oct. 2002 by D. Edwards - M141-30
Fd. OK, Aug. 2003 by D. Edwards - M142-71

Harvey Christensen - For: Roseburg Resources - 6/2005 M148-13

Found - 1959 2.5' DCSO BC, 3' above ground
6" D.Fir N.2°W., 11.3 ft blazed & scribed "T22S R5W S24 BT"
5" D.Fir N.60°E., 5.1 ft blazed & scribed "X" "BT"
16" D.Fir S.32°E. 26.1 ft healed face/tagged/ painted
16" D.Fir S.4.5°W. 41.0 ft healed face/tagged/ painted
21" D.Fir S.63°E. 54.6 ft healed face/tagged/ painted

continued next page

TOWNSHIP 22 RANGE 05 POINT IDENTIFIER # 700300

PRIMARY CORNER DESCRIPTION Sec. cor. for 24 & 25; 19 & 30, T22-4

Alias _____	Description _____
Alias _____	Description _____
Alias _____	Description _____
Alias _____	Description _____

DCS0-GIS Corner visitation - 1/5/2006 - Typed: 1/19/2011 -
C.S. File 67/33-1

Monument - 2½" BC on IP. Comment - OK, 5 live BTs.

Fd. Ok Aug. 2006 by K. DeGroot - M146-44
Fd. Ok 12/2017 by D Edwards - M174-5