


T. 23 S., R. 1 E W.

CORNERS RENEWED BY  
 BUREAU OF LAND MANAGEMENT -----◆  
 COUNTY SURVEYOR'S OFFICE -----◎  
 PRIVATE SURVEYORS -----○  
 CORNERS FOUND AND USED -----■  
 CORNERS LOOKED FOR AND NOT FOUND -----●

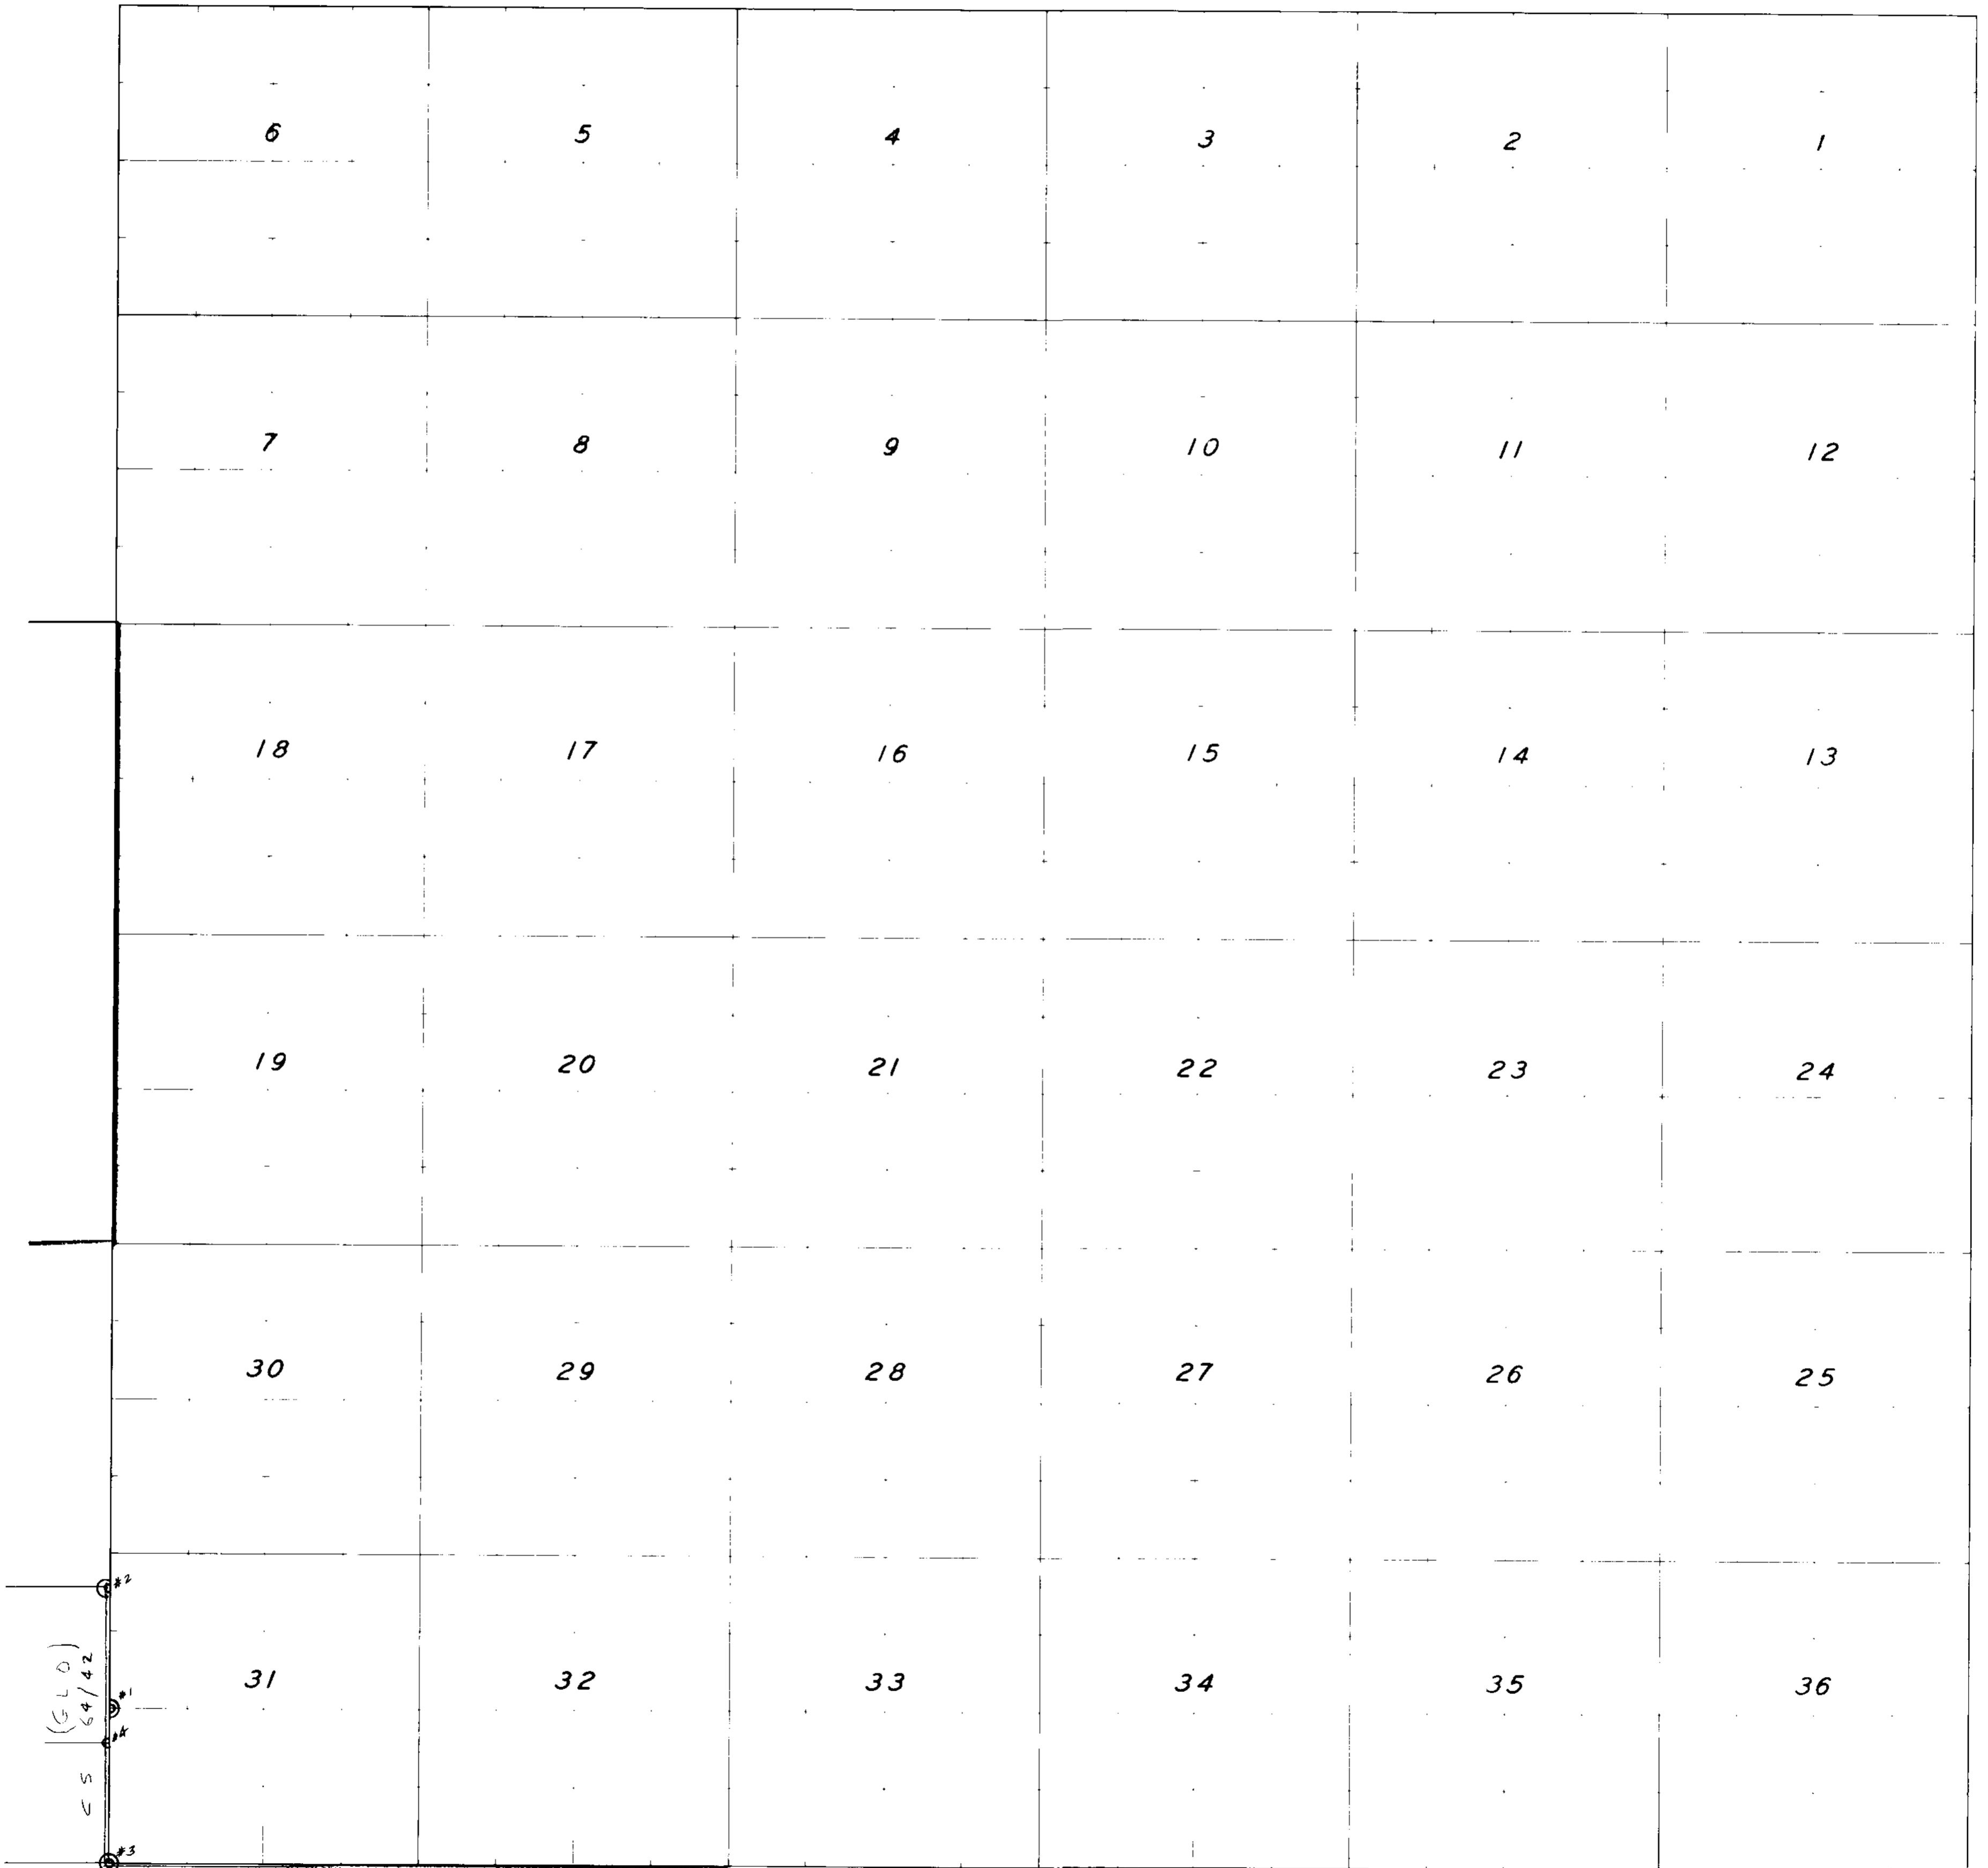

(G L O)  
 64/42  
 C S

C S 64/42